


Replace 2 poles on Nature Rd with taller poles

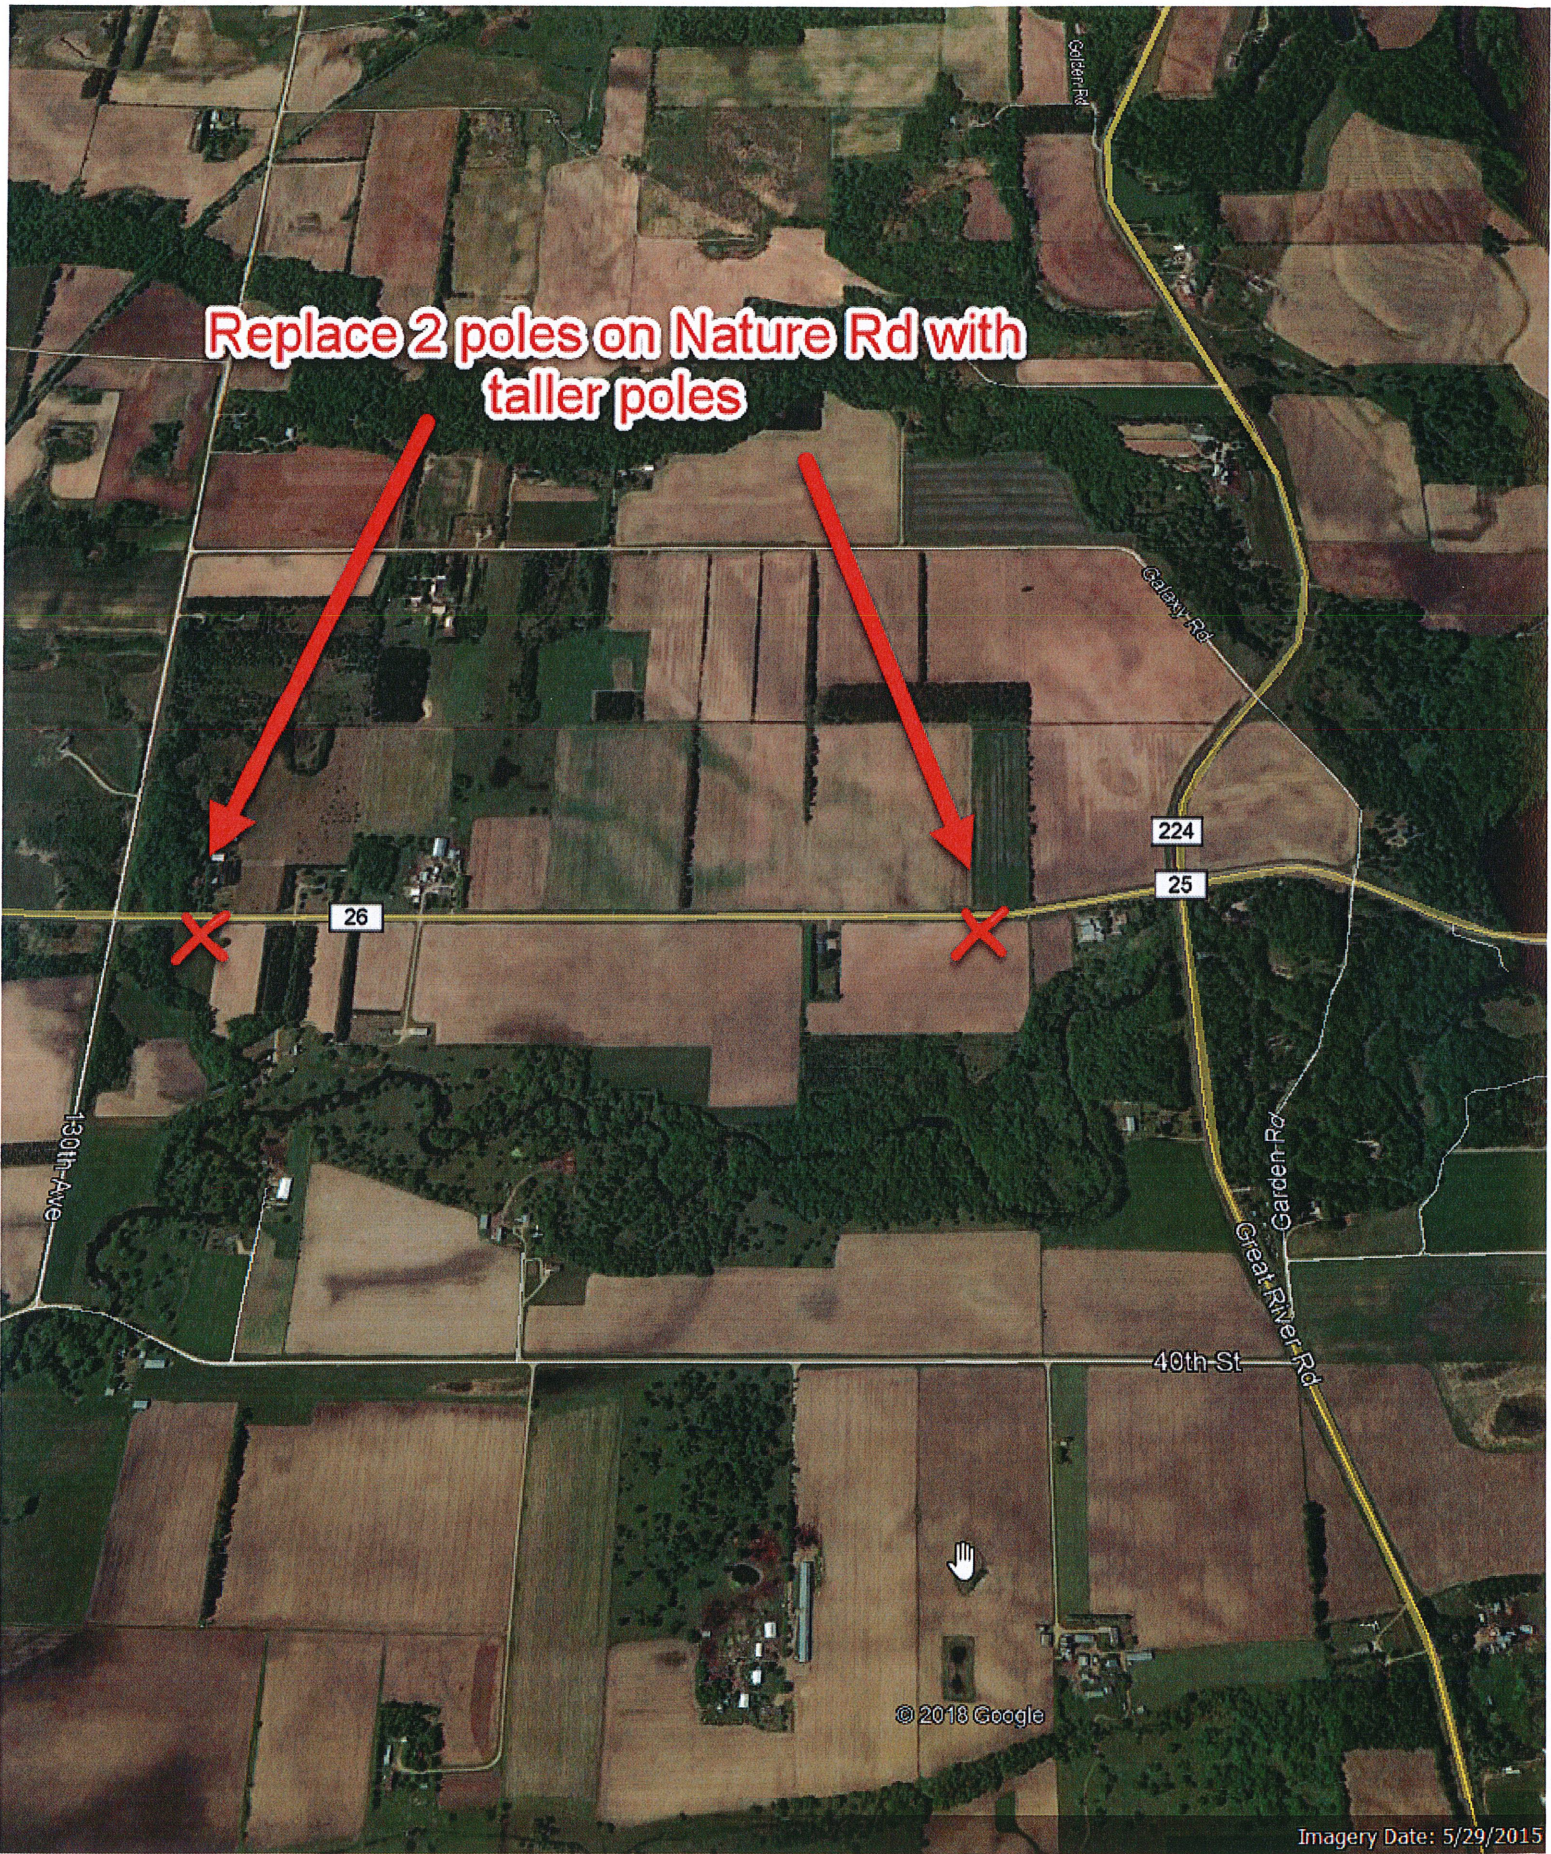

© 2018 Google

Imagery Date: 5/29/2015