


GENERAL LOCATION ONLY. DO NOT USE TO LOCATE FOR EXCAVATION. CALL 1-800-252-1166 FOR ONSITE LOCATIONS AND STAKING.

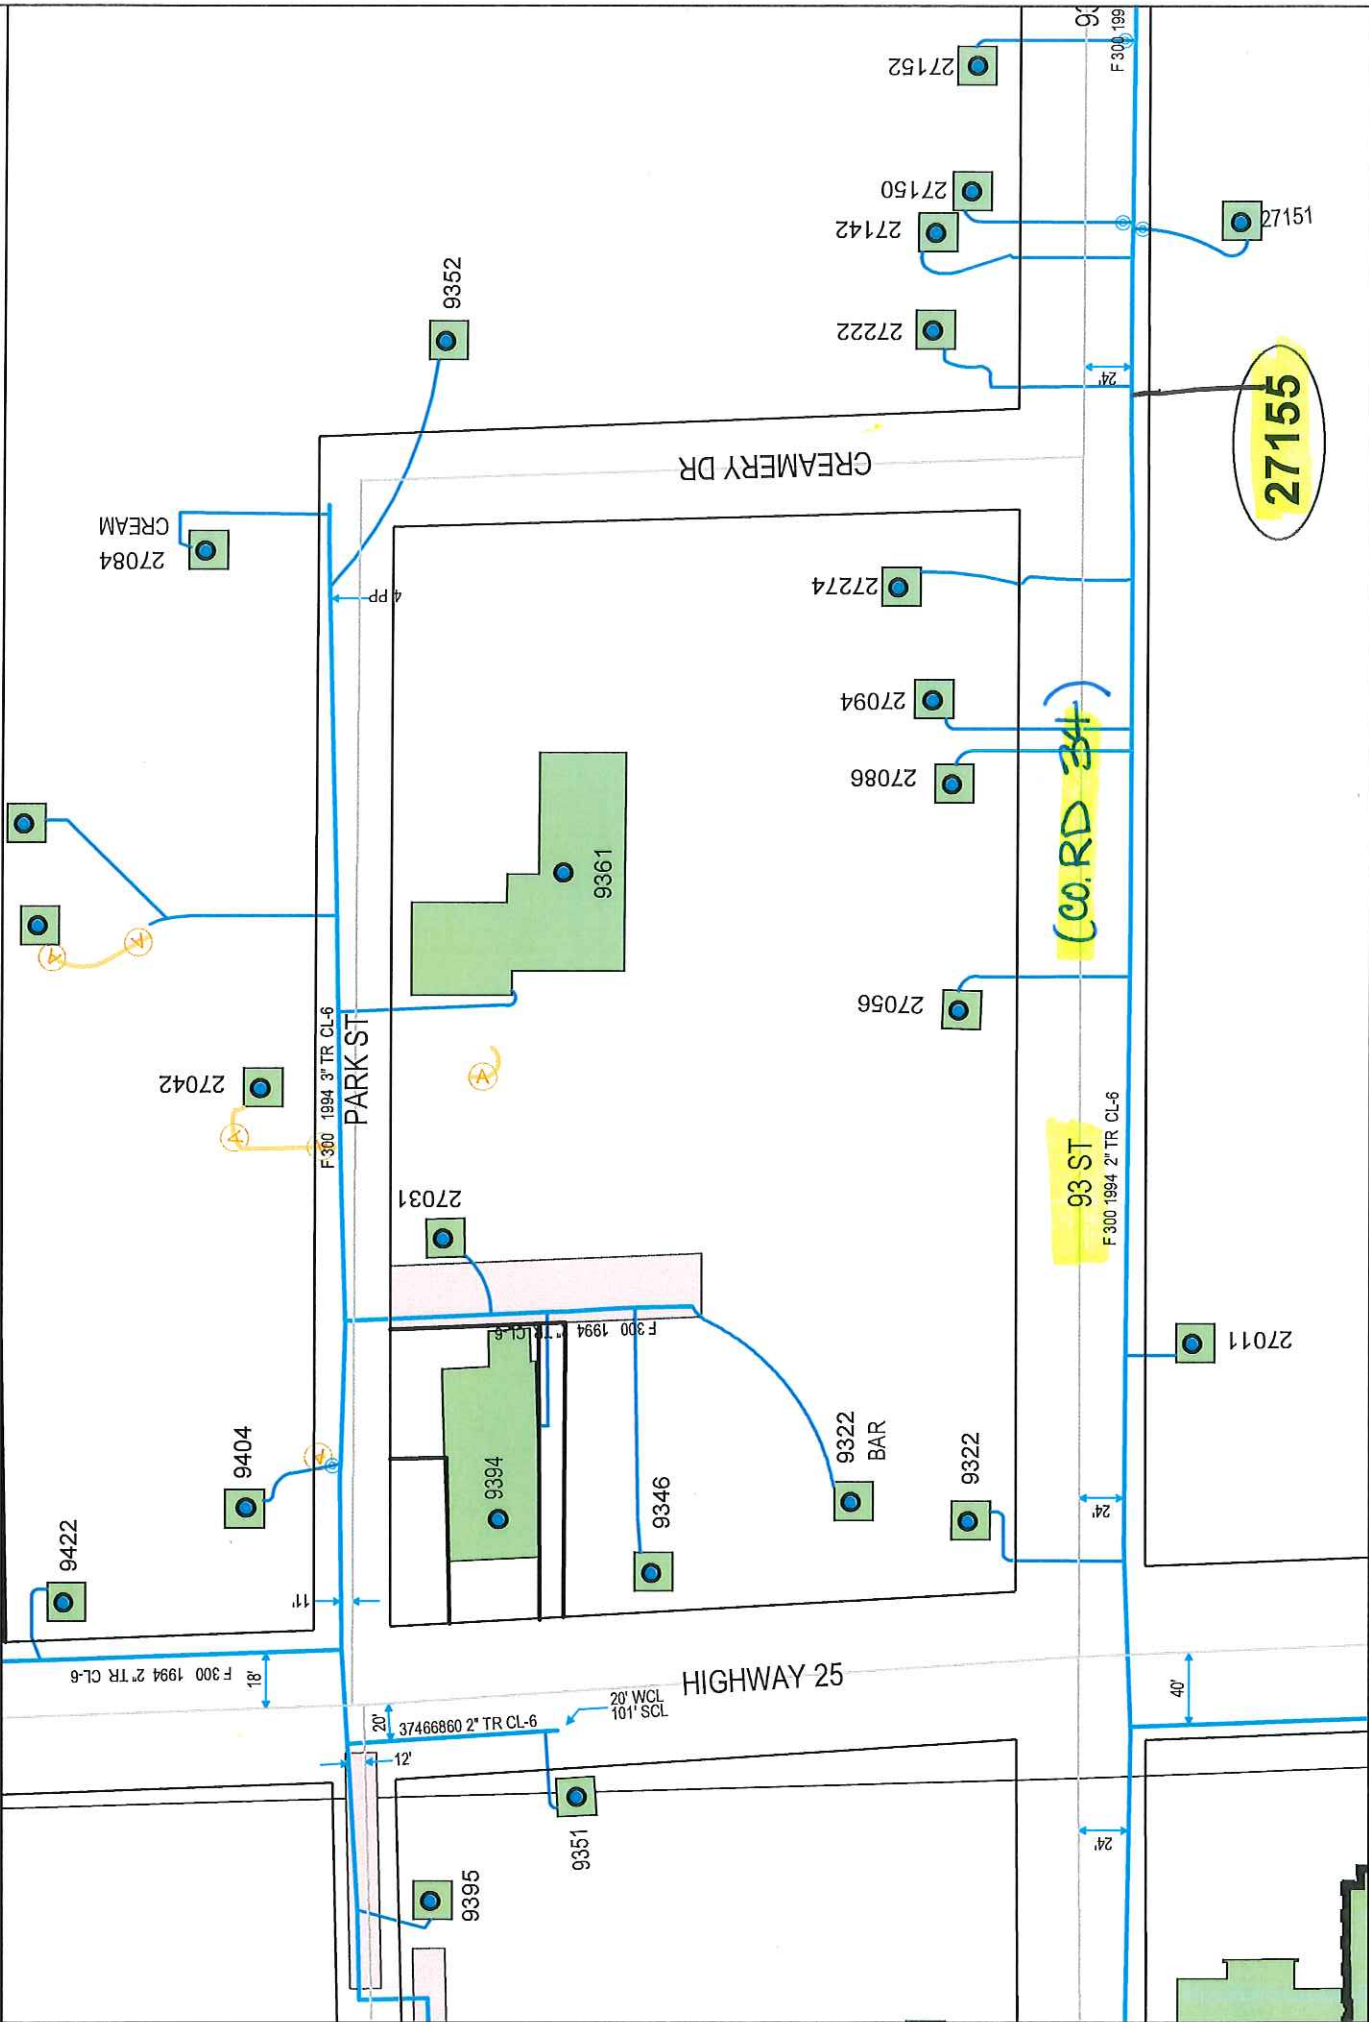

Scale: 1" = 100'
CenterPoint Energy
North

27155 93RD ST (CO RD 34)
BUCKMAN (MORRISON CO)

Plotted by: i221539
Plot Date: 6/27/2019