GENERAL LOCATION ONLY. DO NOT USE TO LOCATE FOR EXCAVATION. CALL 1-800-252-1166 FOR ONSITE LOCATIONS AND STAKING.

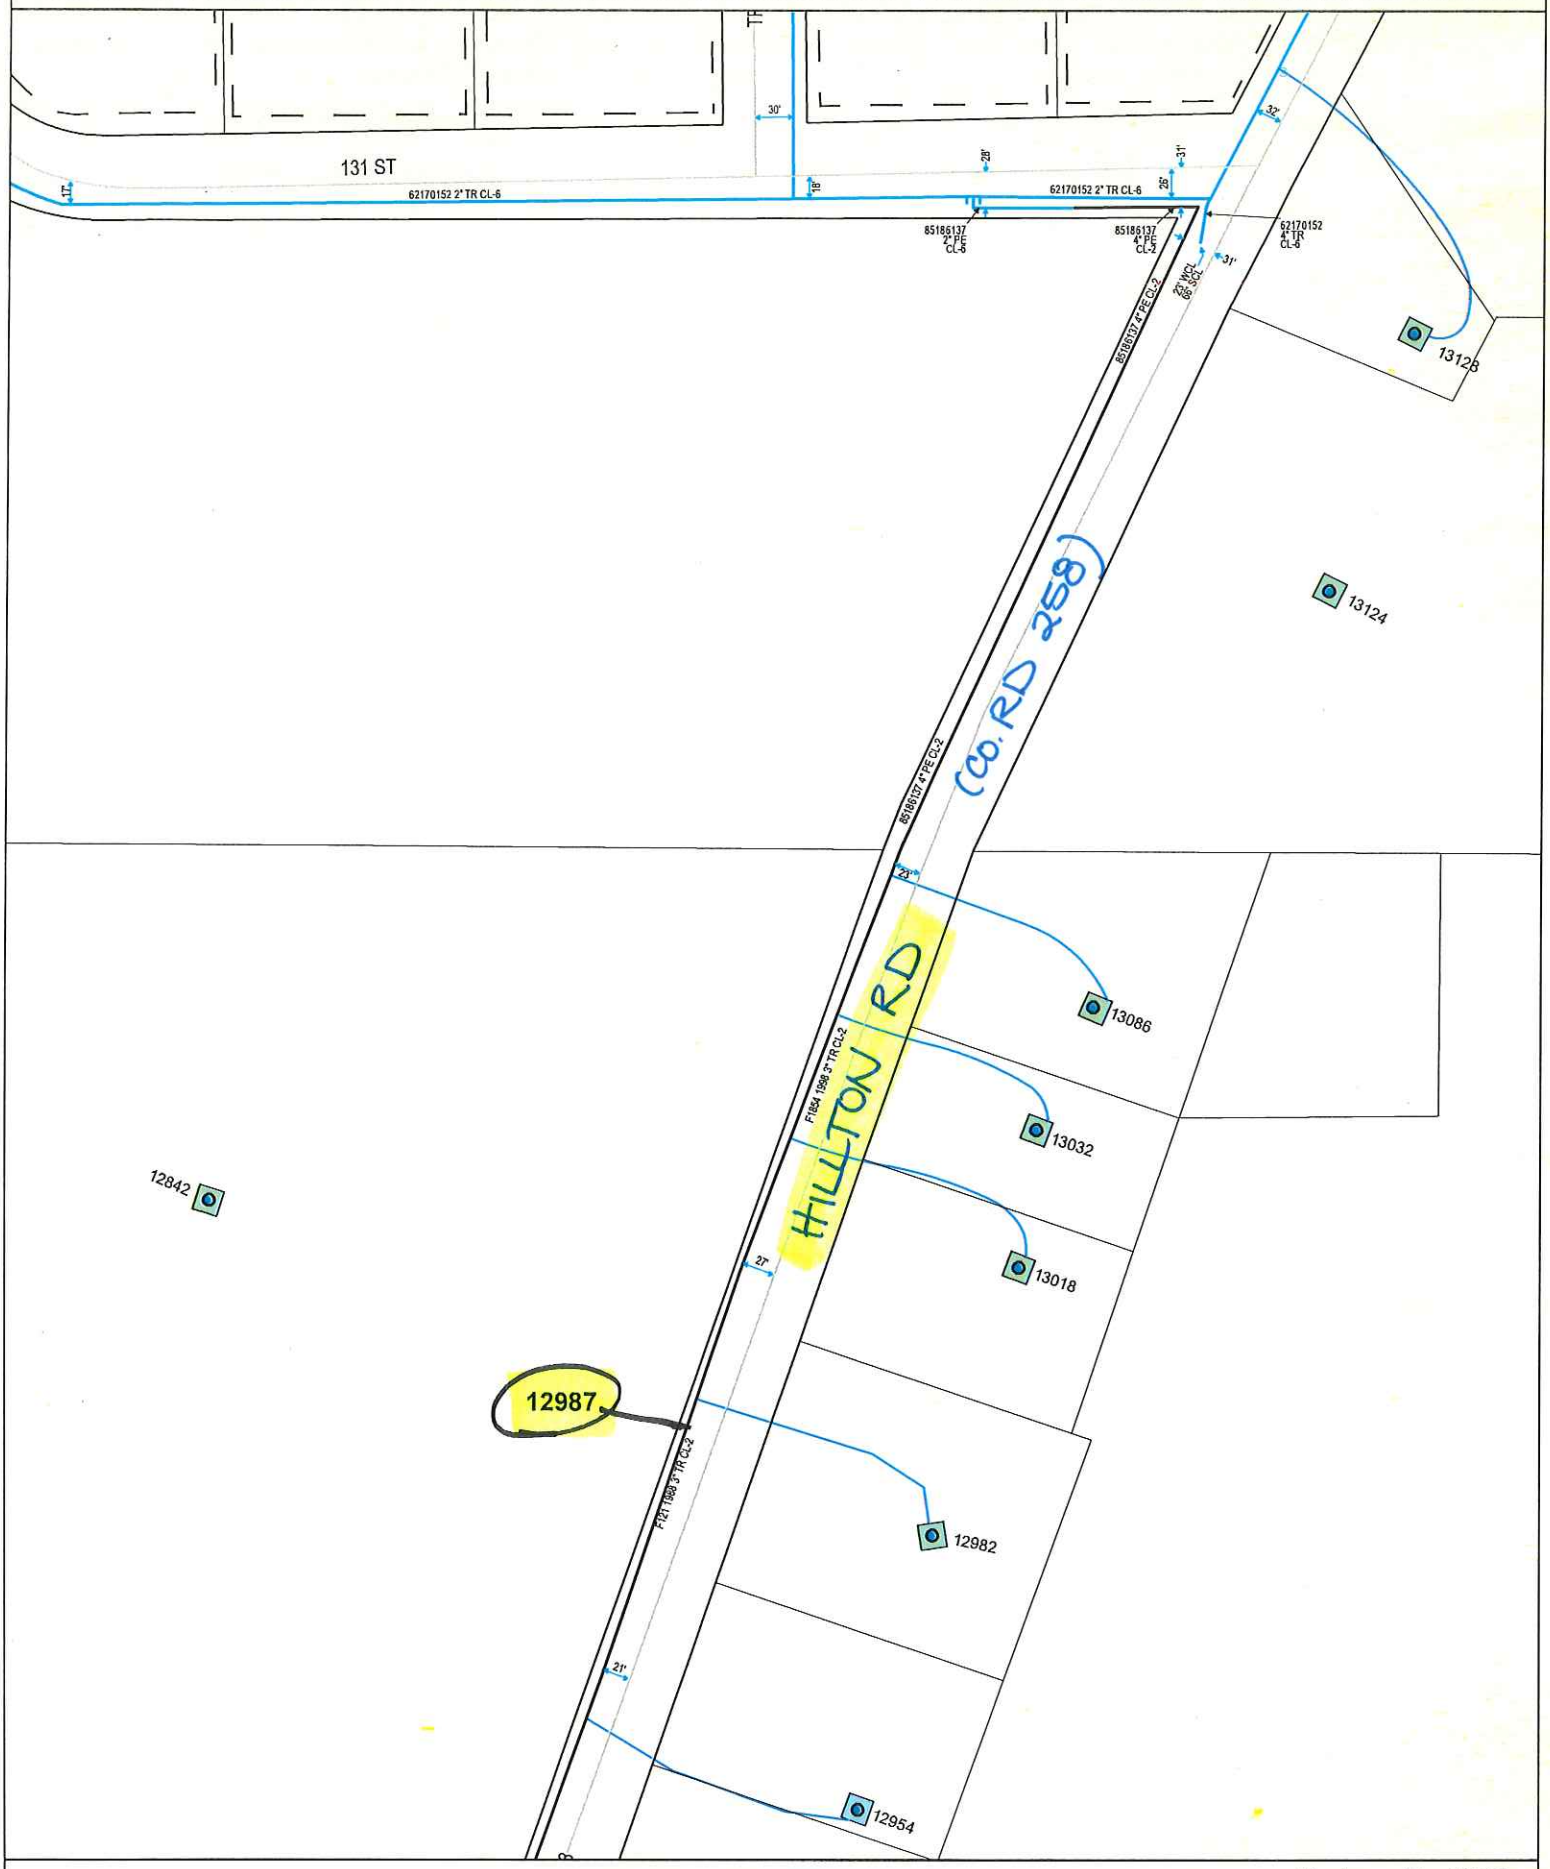

Plotted by: i934488

Plot Date: 7/23/2019

12987 HILLTON RD

LITTLE FALLS TWP - MORRISON

Scale: 1" : 150 '

CenterPoint Energy

North