


Hartman Rd

43

plow along
road
approx 100
ft then
east onto
private

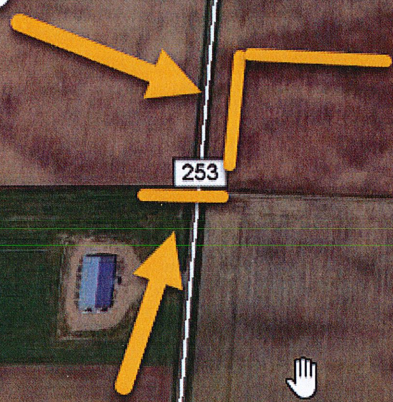

get over
road -
minimum
22'

250th Ave

27

Replace pole
on east side
of road with
taller one and
bring primary
wire to it from
pole on west
side of road.
Then, plow
primary wire
north on east
side of road
row to
driveway at
new chicken
barn then
east onto
private
property

143rd St