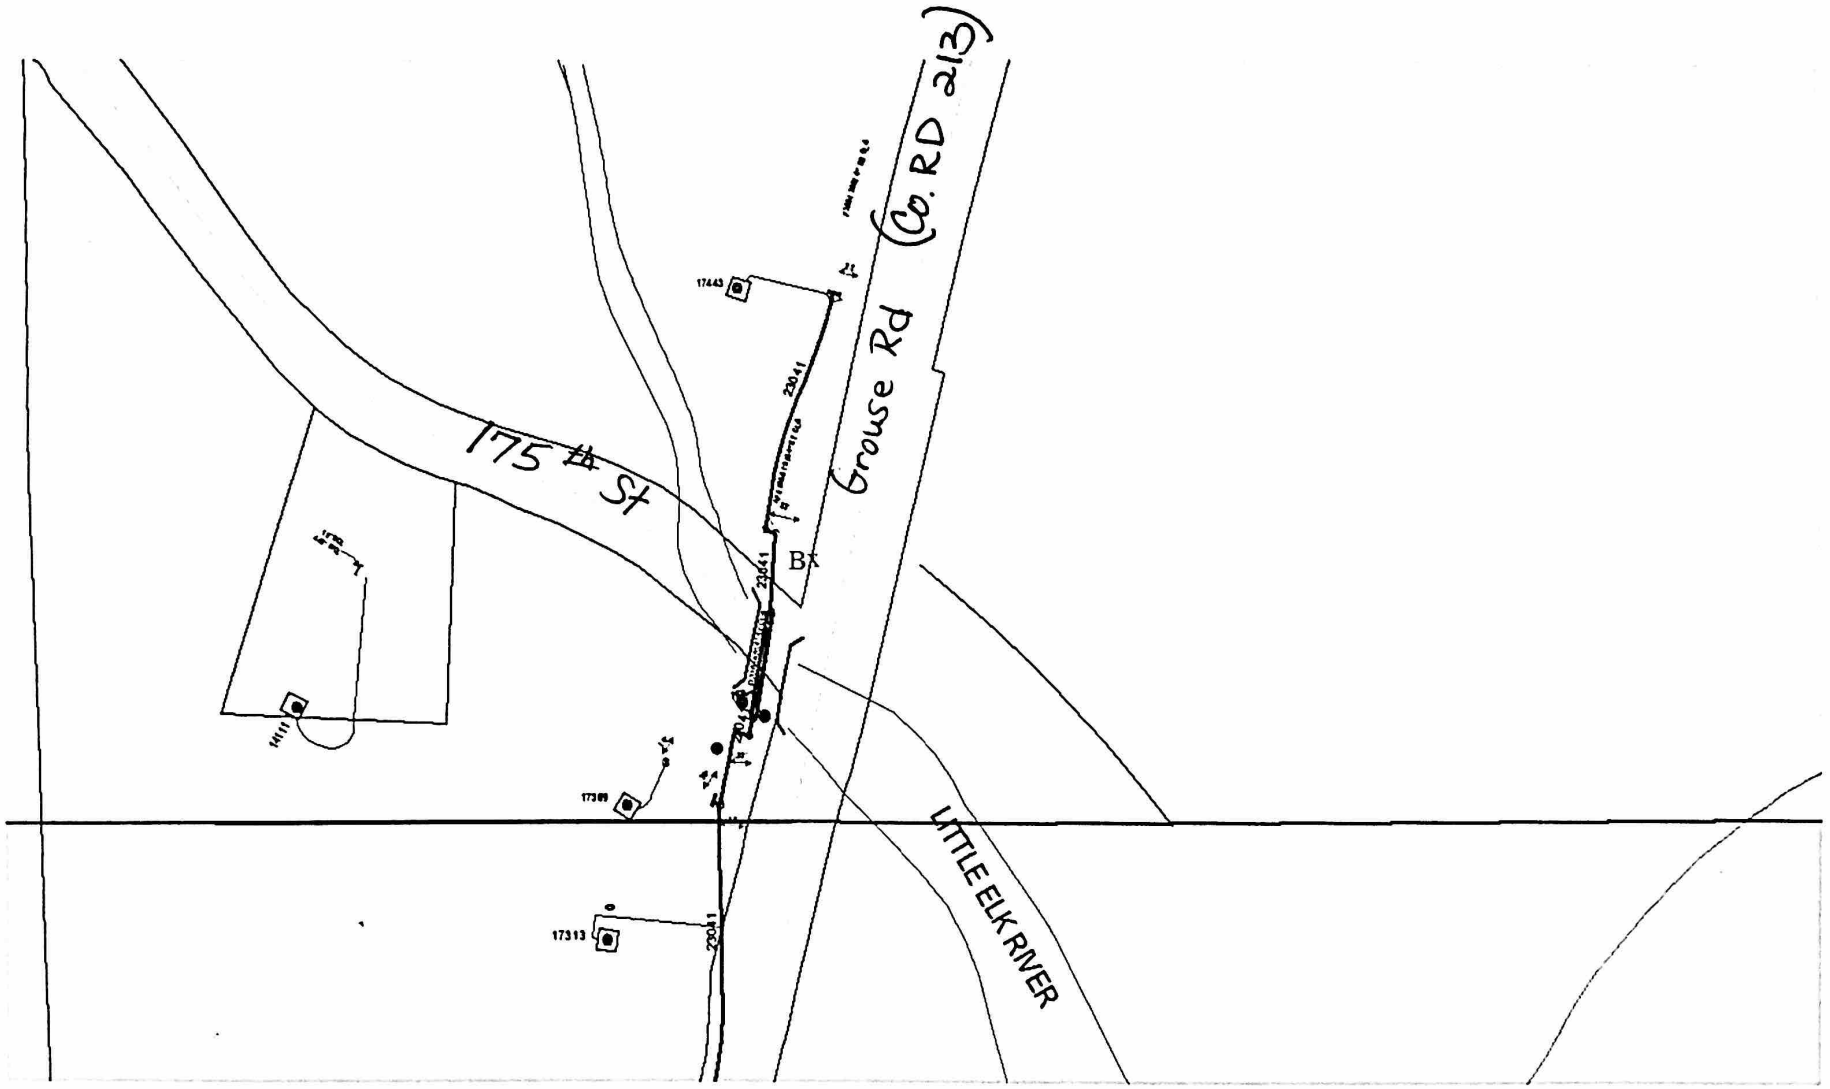

Green Prairie Twp – Morrison Co.

9288 3018