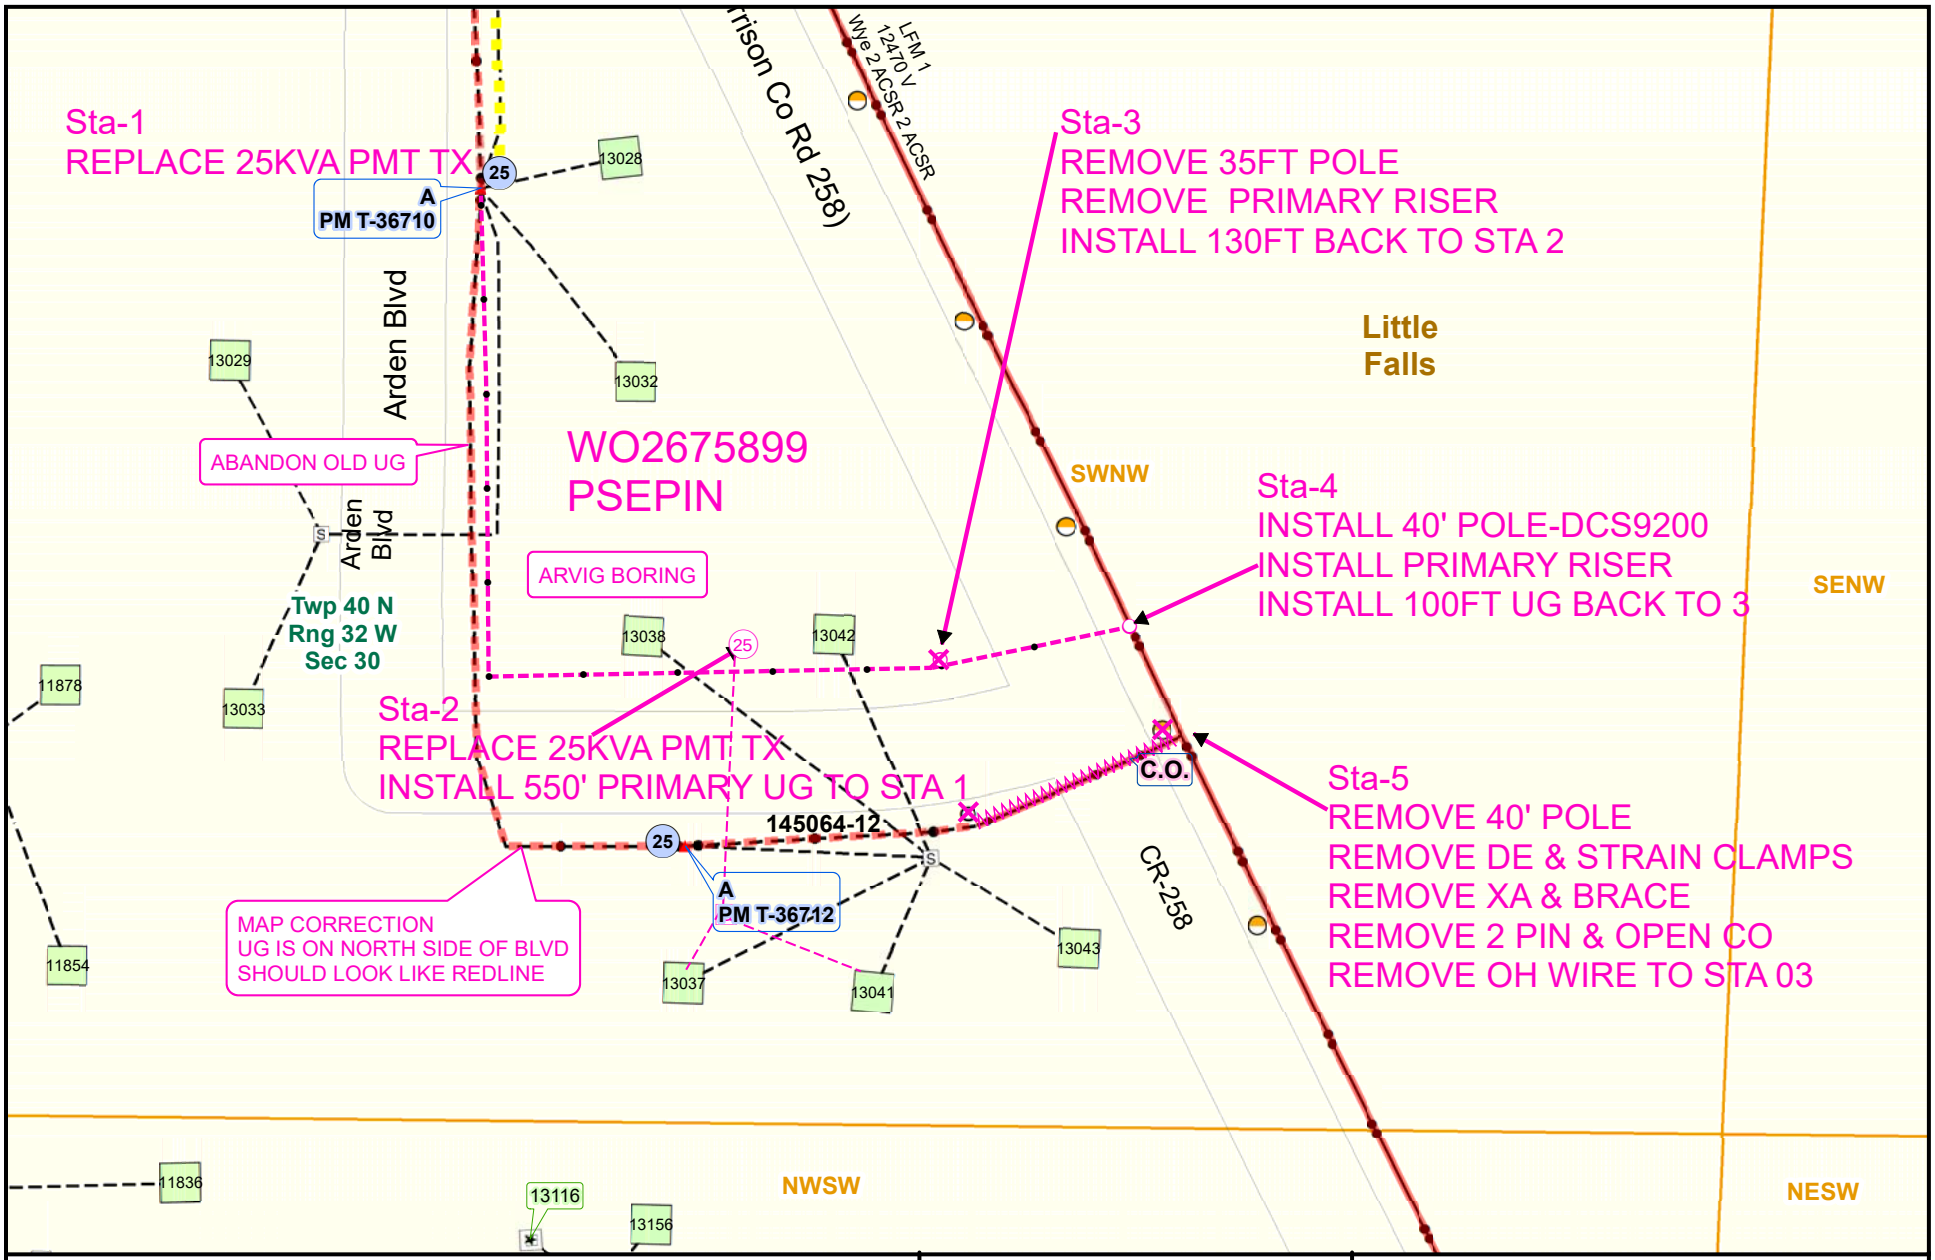

psepin	9/2/2020	N

minnesota power
AN ALLETE COMPANY