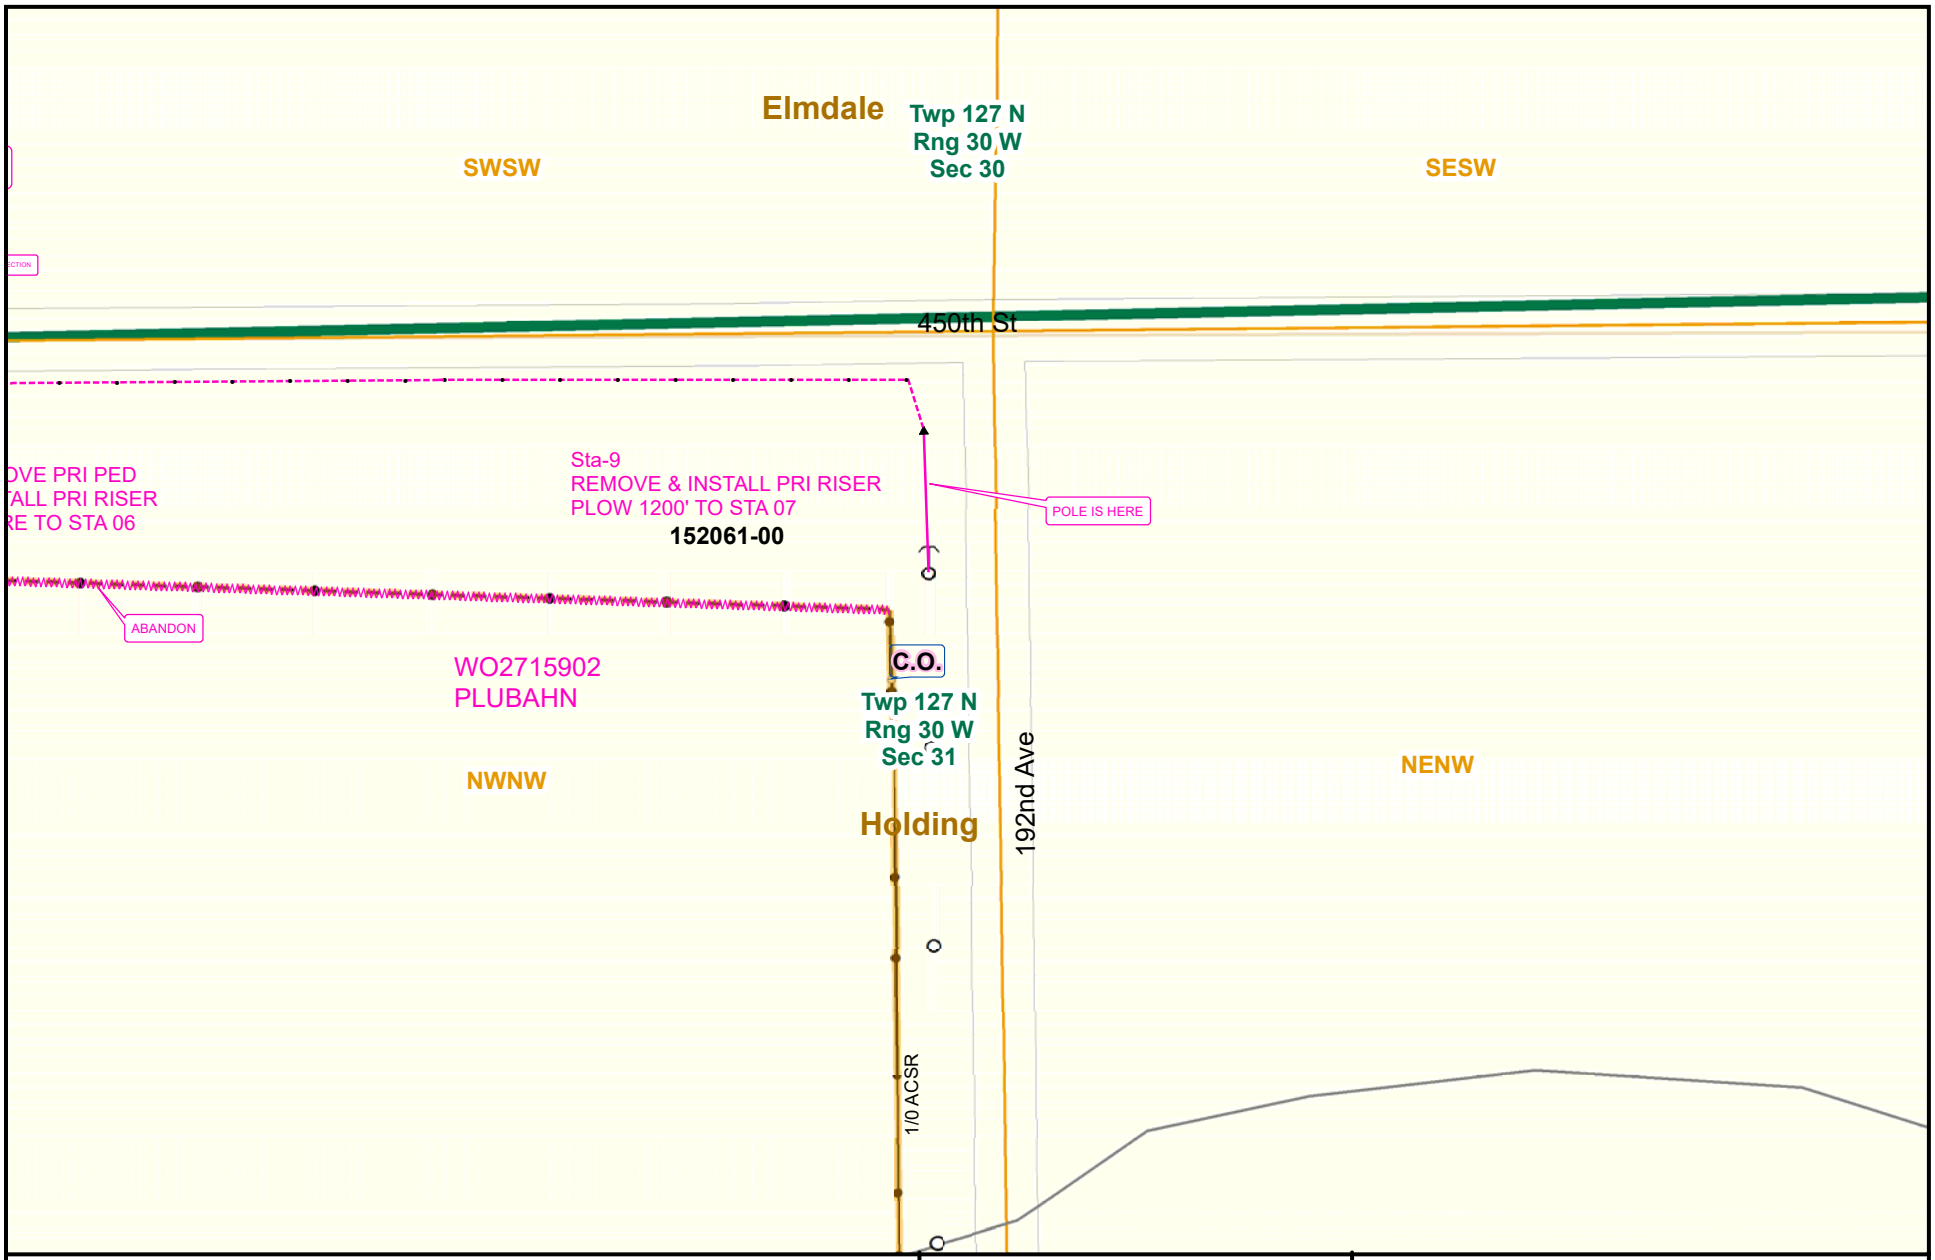

N

minnesota power

AN ALLETE COMPANY

psepin

10/16/2020