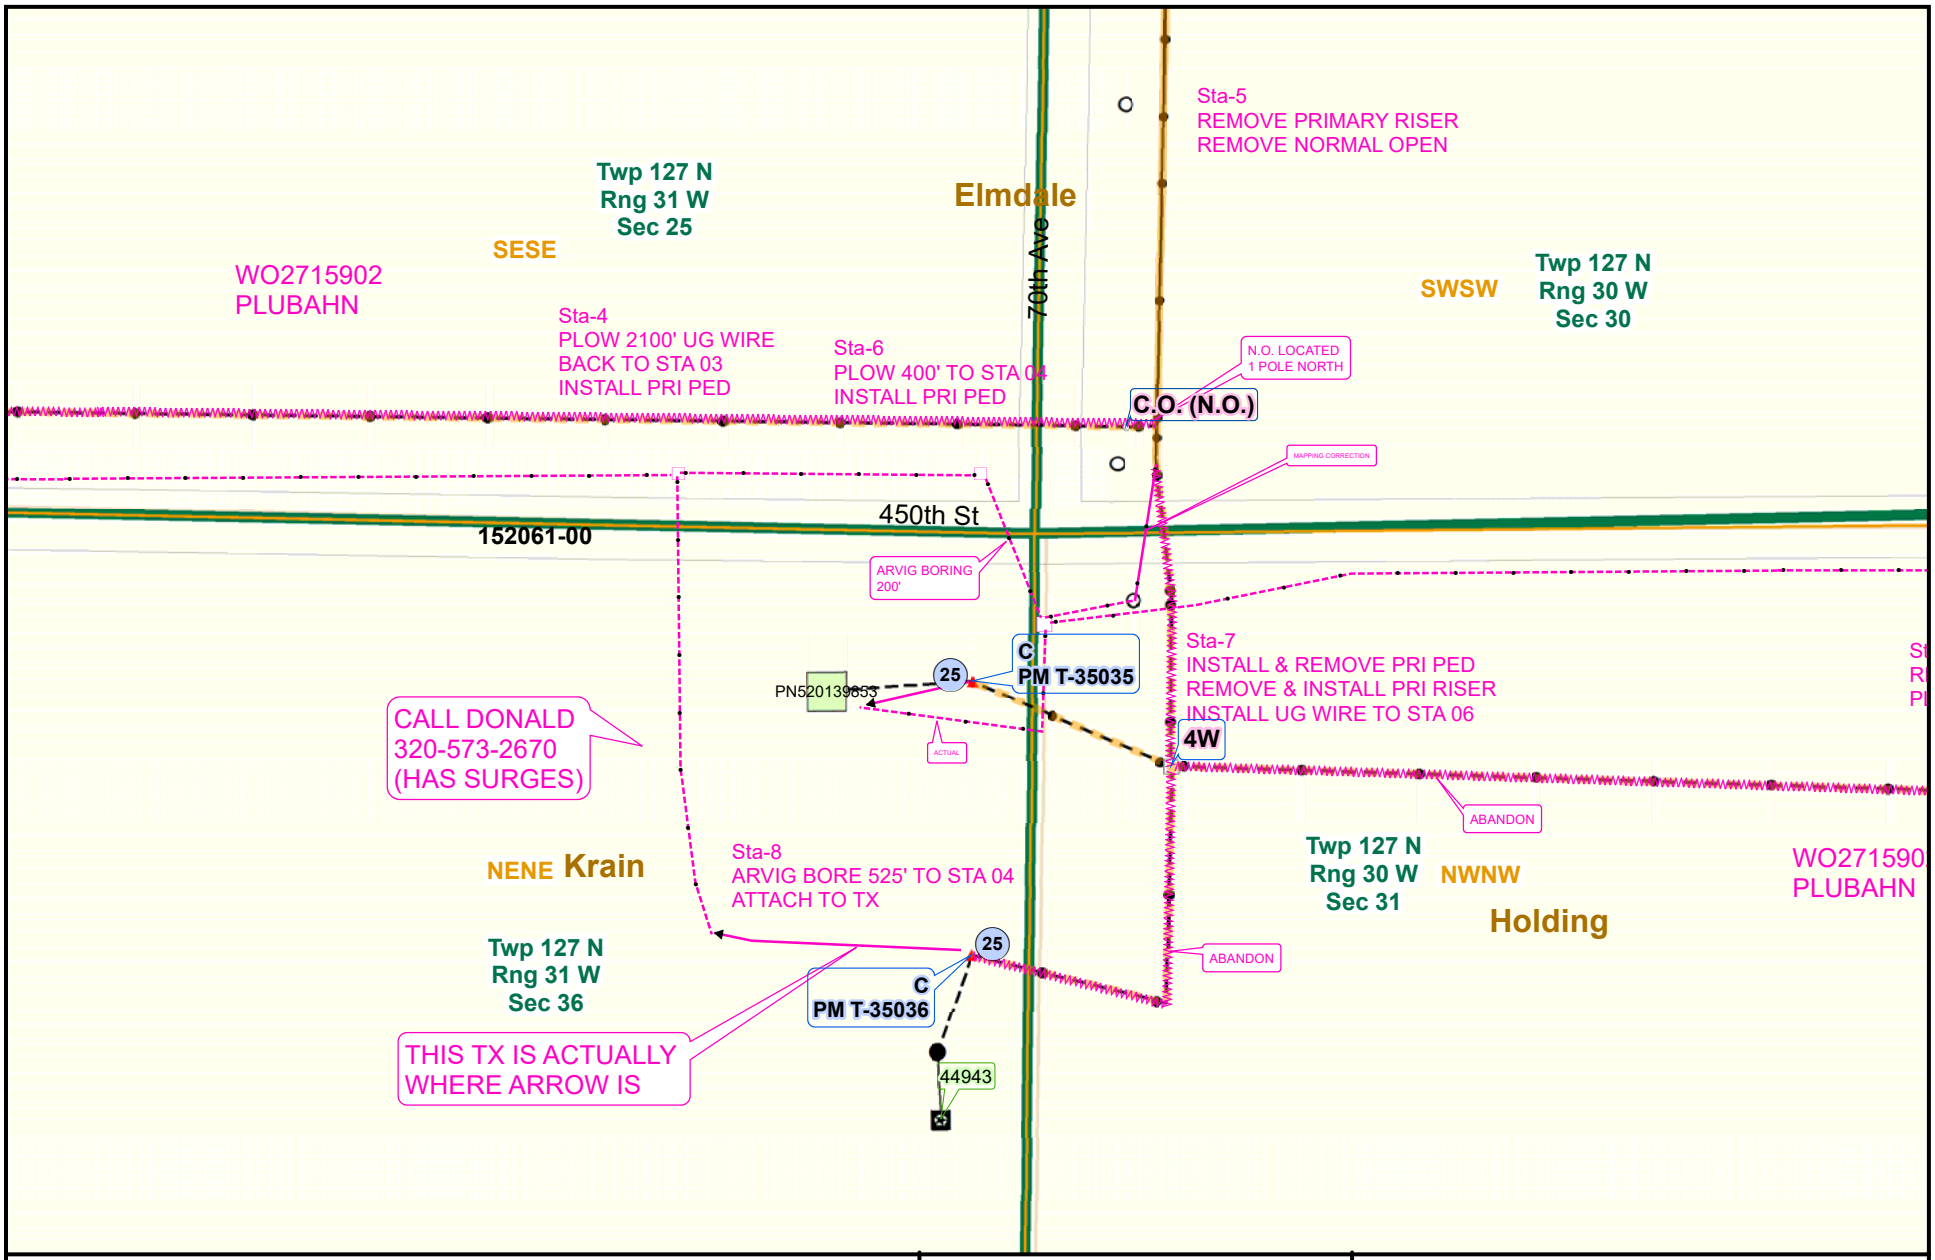

psepin	10/16/2020	N

minnesota power
AN ALLETE COMPANY