


3RD AVENUE NW (CSAH 43)

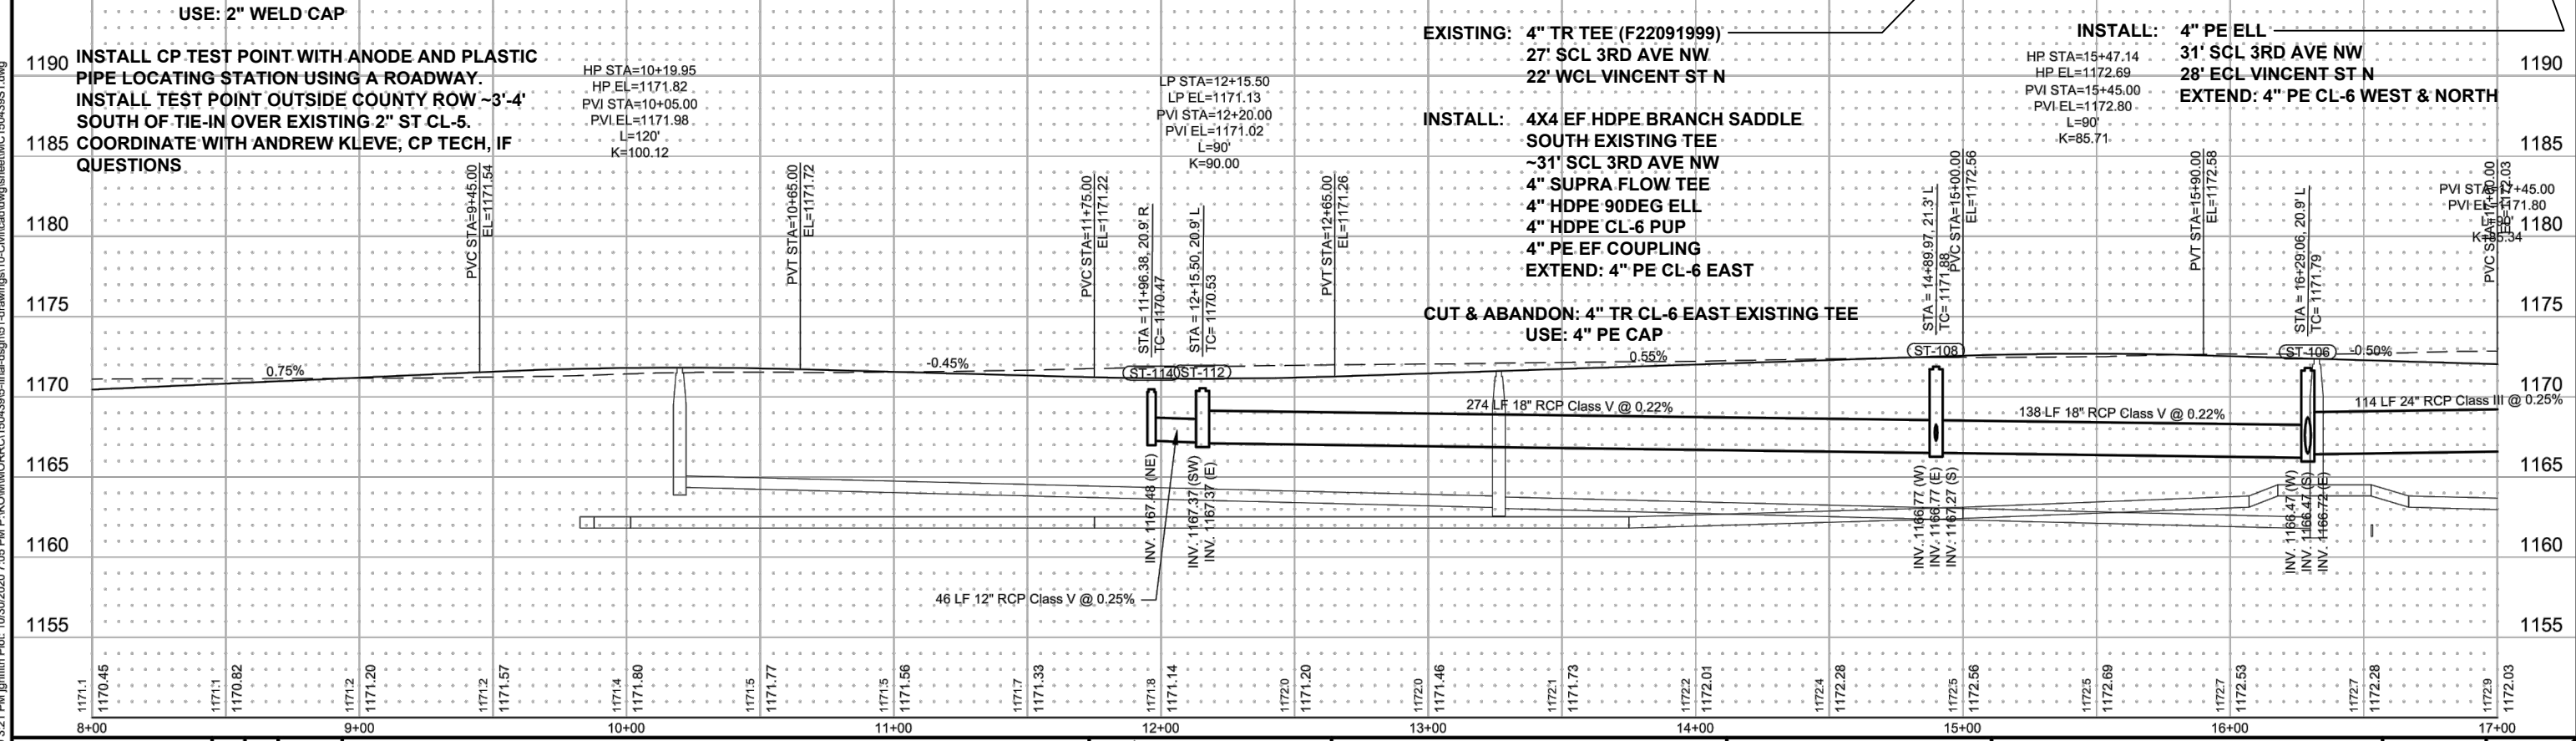

DRAWN BY: JRG
 DESIGNER: JRG
 CHECKED BY: SDH

| NO. | BY | DATE | REVISIONS |
|-----|----|------|-----------|
| | | | |
| | | | |

SEH
 PHONE: 320.229.4300
 1200 25TH AVENUE SOUTH
 P.O. BOX 1717
 ST. CLOUD, MN 56302-1717
 www.sehinc.com

I HEREBY CERTIFY THAT THIS PLAN WAS PREPARED BY ME OR UNDER MY DIRECT SUPERVISION AND THAT I AM A DULY LICENSED PROFESSIONAL ENGINEER UNDER THE LAWS OF THE STATE OF MINNESOTA.
Scott D. Hedlund
 SCOTT D. HEDLUND, PE (MN)
 Date: 10/07/2020 Lic. No. 40696

MORRISON COUNTY, MINNESOTA
 SAP 049-643-017; SAP 049-639-014;
 SP 049-591-005

STREET & STORM SEWER PLAN & PROFILE
2021 CSAH 43 & 39 RECONSTRUCTION AND SRTS

FILE NO. MORRIS 150439
44
97

2/22/2021 12:31:36 PM DESIGNER EXPRESS DESIGN

Save: 10/30/2020 3:21 PM Jgriffin Plot: 10/30/2020 7:05 PM P:\COMM\MORRIS\150439\5-final-dsgn\51-drawings\10-Civil\cad\dwg\street\MC150439S1.dwg