3RD AVENUE NE (CSAH 39)

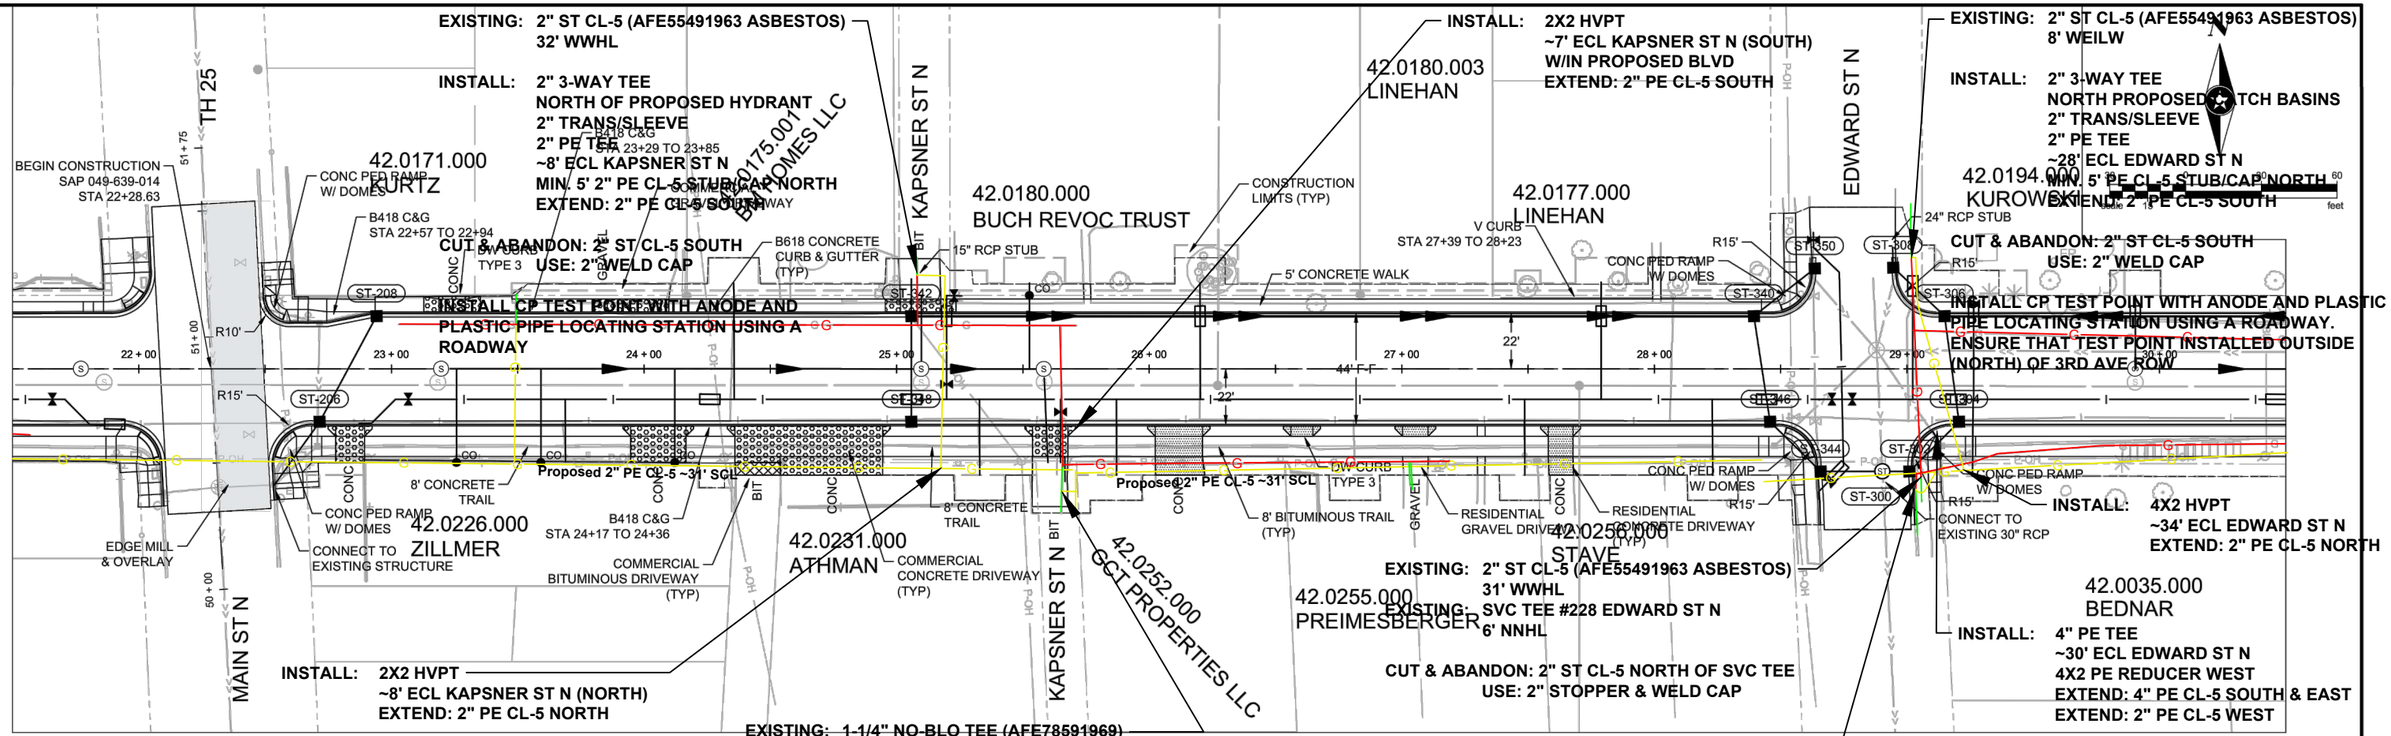

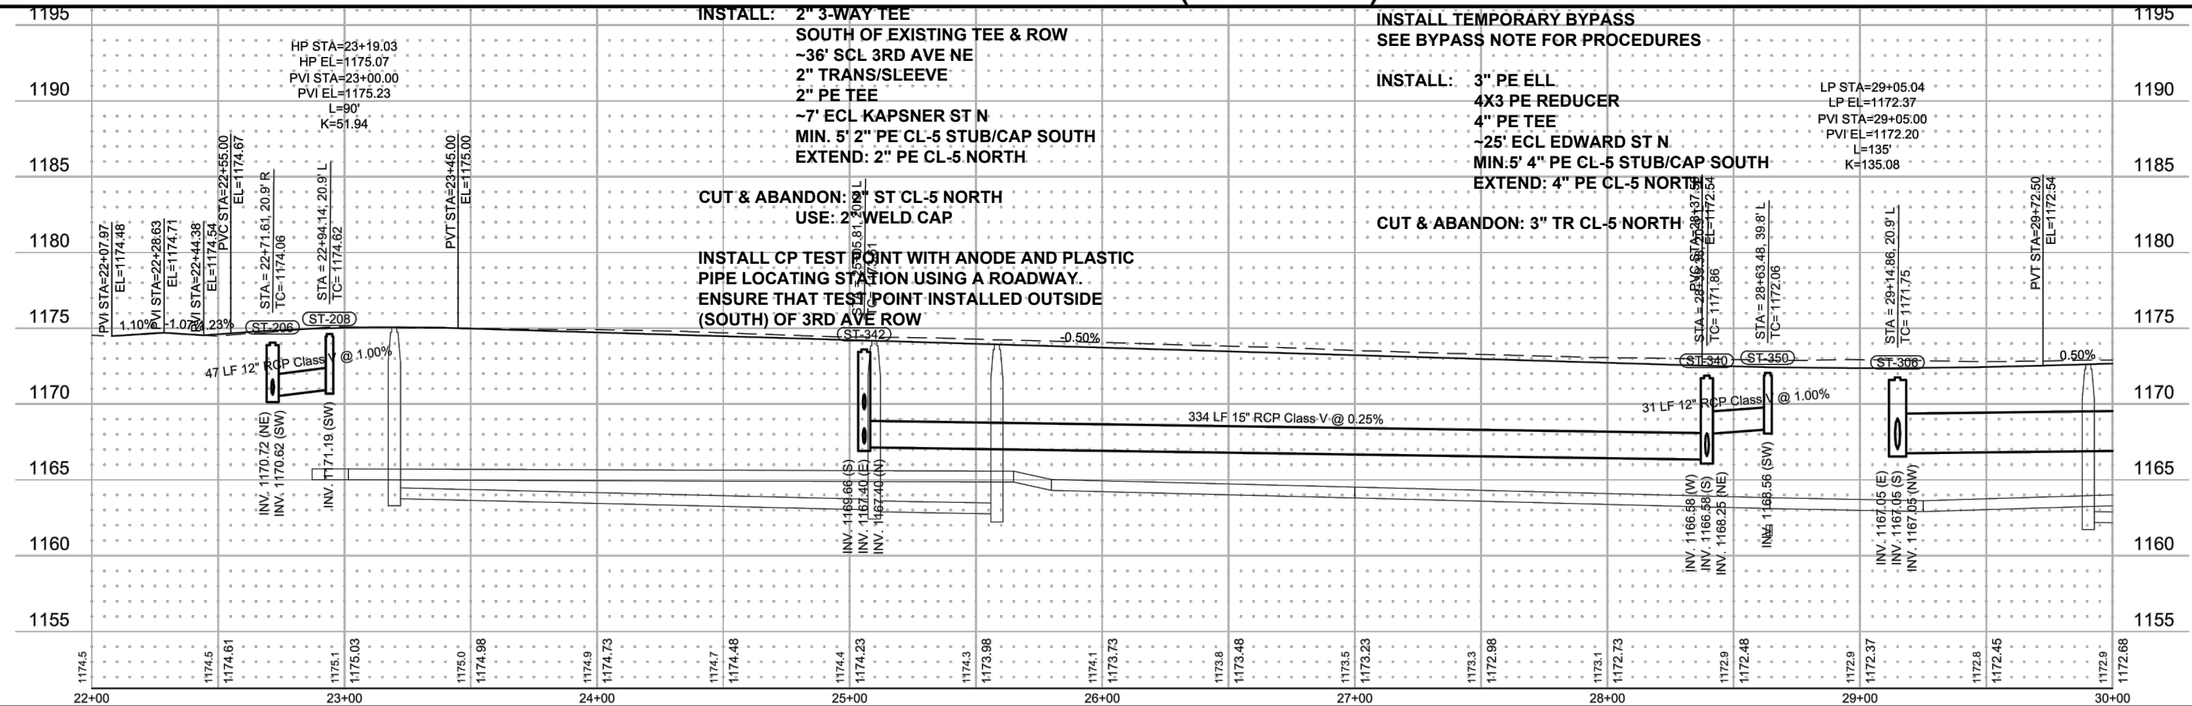

DRAWN BY: JRG				SEH PHONE: 320.229.4300 1200 25TH AVENUE SOUTH P.O. BOX 1717 ST. CLOUD, MN 56302-1717 www.sehinc.com	MORRISON COUNTY, MINNESOTA SAP 049-643-017; SAP 049-639-014; SP 049-591-005
DESIGNER: JRG					STREET & STORM SEWER PLAN & PROFILE 2021 CSAH 43 & 39 RECONSTRUCTION AND SRTS
CHECKED BY: SDH				I HEREBY CERTIFY THAT THIS PLAN WAS PREPARED BY ME OR UNDER MY DIRECT SUPERVISION AND THAT I AM A DULY LICENSED PROFESSIONAL ENGINEER UNDER THE LAWS OF THE STATE OF MINNESOTA.	FILE NO. MORRC 150439
DESIGN TEAM	NO.	BY	DATE	REVISIONS	SCOTT D. HEDLUND, PE (MN) Date: 10/07/2020 Lic. No. 40686	46 / 97

Save: 10/30/2020 2:18 PM jgriffith Plot: 10/30/2020 7:12 PM P:\KOM\MORRC\150439\5-final-dsgn\51-drawings\10-Civil\cad\dwg\sheet\MC150439S2.dwg

2/22/2021 1:20:30 PM DESIGNER EXPRESS DESIGN