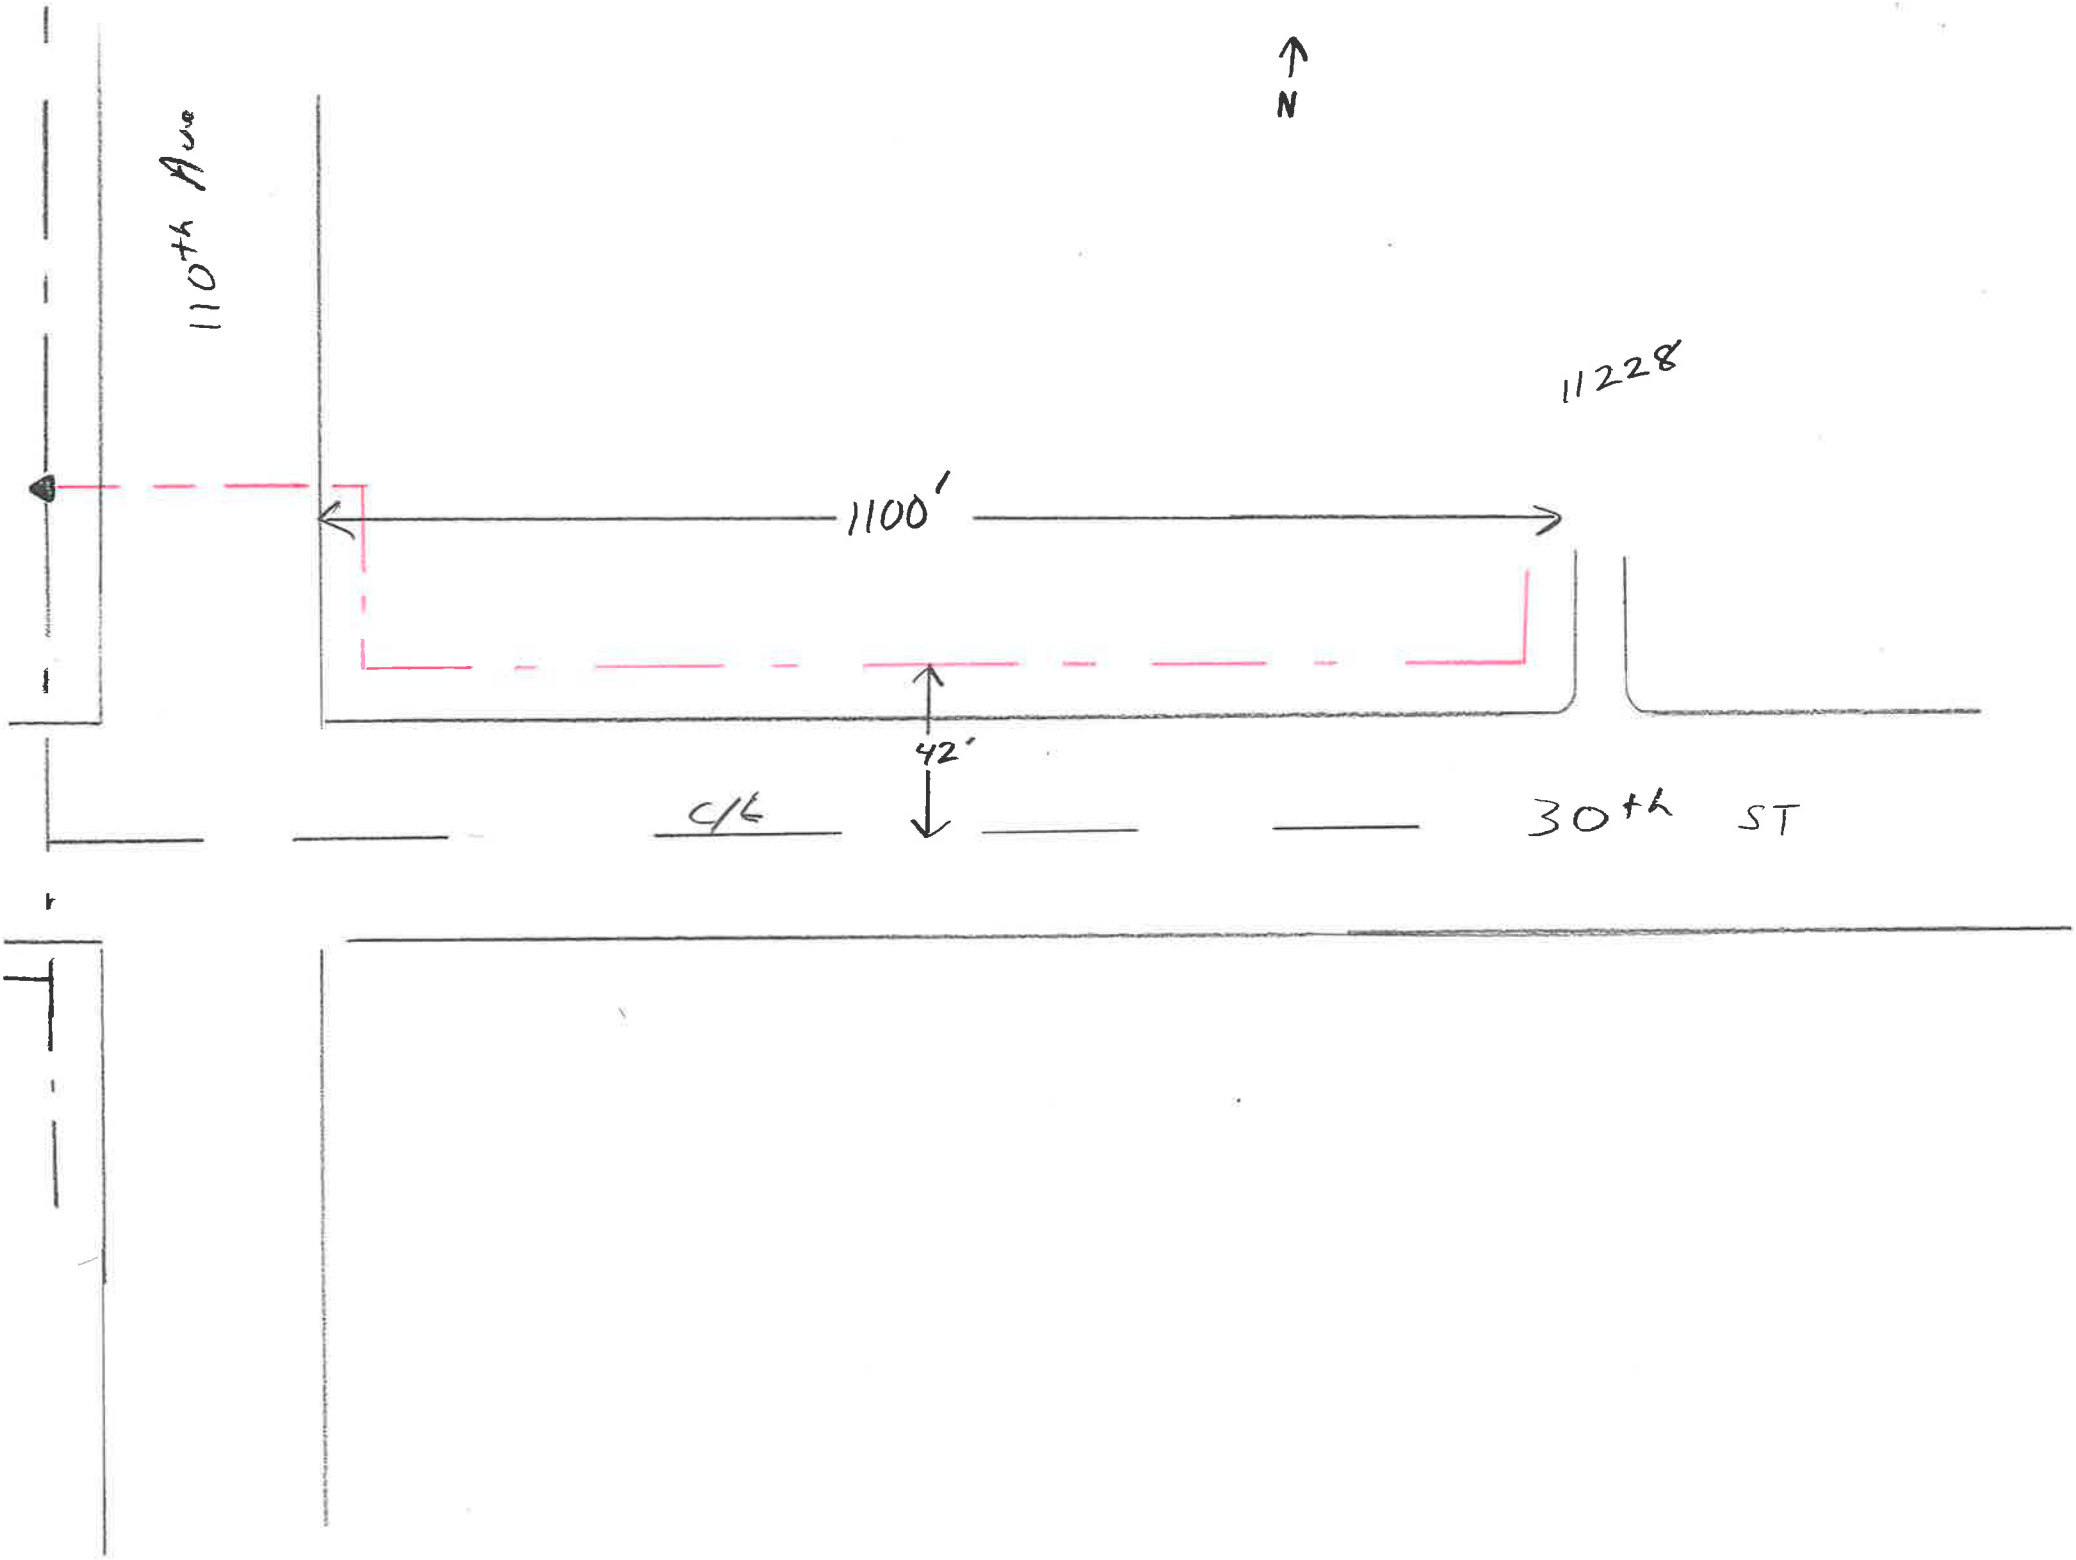
N
110th Ave
11228
1100'
42'
C/L
30th ST