


| | | | | | | | | | |
|--|--|--|--|--|--|--|--|---|--|
| Customer Ready Date <input style="width:100%;" type="text"/> | | Minnesota Energy Resources | | Field Site Visit: <input type="radio"/> Service Card <input type="radio"/> Main Card | | WR: <input style="width:100%;" type="text"/> | | | |
| Customer Name <input style="width:100%;" type="text"/> | | | | Related WR: <input style="width:100%;" type="text"/> | | | | | |
| Address <input style="width:100%;" type="text"/> | | Premise #: <input style="width:100%;" type="text"/> | | Contact Number: <input style="width:100%;" type="text"/> | | County: <input style="width:100%;" type="text"/> | | | |
| Cross Street <input style="width:100%;" type="text"/> | | City: <input style="width:100%;" type="text"/> | | Within City Limits? <input style="width:100%;" type="text"/> | | Taxing District: <input style="width:100%;" type="text"/> | | | |
| Main Size: <input style="width:100%;" type="text"/> | | *PSI: <input style="width:100%;" type="text"/> | | Material: <input style="width:100%;" type="text"/> | | Job Type: <input style="width:100%;" type="text"/> | | | |
| | | CP: <input style="width:100%;" type="text"/> | | | | Type of Service: <input style="width:100%;" type="text"/> | | | |
| * If Service PSI is greater than 60#, please refer to Engineering | | | | Location: <input style="width:100%;" type="text"/> | | | | | |
| Svc Requires Main? <input style="width:100%;" type="text"/> | | Permits Required (Check all that apply) | | Pipe Install: | | Material: <input style="width:100%;" type="text"/> | | | |
| Additional Information / Special Instructions / Contacts / Directions / Notes: <div style="border: 1px solid black; height: 150px; width: 100%;"></div> | | <input type="checkbox"/> Township | | Quantity (ft): <input style="width:100%;" type="text"/> | | Size (in): <input style="width:100%;" type="text"/> | | | |
| | | <input type="checkbox"/> City | | Retire: | | <input type="checkbox"/> CWS <input type="checkbox"/> Xtrube <input type="checkbox"/> Copper | | | |
| | | <input type="checkbox"/> County | | Add. Bellhole <input style="width:100%;" type="text"/> | | <input type="checkbox"/> BS <input type="checkbox"/> MDPE <input type="checkbox"/> Aldyl-A | | | |
| | | <input type="checkbox"/> MnDOT | | Quantity (ft): <input style="width:100%;" type="text"/> | | Size (in): <input style="width:100%;" type="text"/> | | | |
| | | <input type="checkbox"/> Environmental? | | Check All That Apply: <input type="checkbox"/> Curb Value <input type="checkbox"/> Meter Remove <input type="checkbox"/> Mtr Bar Remove | | <input type="checkbox"/> Regulator <input type="checkbox"/> EFV <input type="checkbox"/> Meter Bracket <input type="checkbox"/> Reg Ice Shield | | | |
| | | | | <input type="checkbox"/> Barricade <input type="checkbox"/> Riser <input type="checkbox"/> Meter Bar <input type="checkbox"/> Mtr Ice Shield | | Meter Set needed? <input style="width:100%;" type="text"/> | | Multiple Meters? <input style="width:100%;" type="text"/> | |
| | | | | Excavation (sq ft unless otherwise stated) | | Sod: | | BD&S: | |
| | | | | Dir.Bore (lin ft): <input style="width:100%;" type="text"/> | | Conv.Bore (lin ft): <input style="width:100%;" type="text"/> | | Gravel (cu yds): <input style="width:100%;" type="text"/> | |
| | | | | Concrete: <input style="width:100%;" type="text"/> | | Blacktop: <input style="width:100%;" type="text"/> | | Sand: <input style="width:100%;" type="text"/> | |
| | | | | Sawing (lin ft): <input style="width:100%;" type="text"/> | | Rock Peel (cu yd): <input style="width:100%;" type="text"/> | | C&G (lin ft): <input style="width:100%;" type="text"/> | |
| | | Rock Haul (cu yd): <input style="width:100%;" type="text"/> | | Concrete: <input style="width:100%;" type="text"/> | | Blacktop: <input style="width:100%;" type="text"/> | | | |
| | | Customer UG Facilities? <input style="width:100%;" type="text"/> | | Type of UG Facilities: <input style="width:100%;" type="text"/> | | Estimate: <input style="width:100%;" type="text"/> | | | |
| | | Excess Footage: <input style="width:100%;" type="text"/> | | P/L to Meter: <input style="width:100%;" type="text"/> | | | | | |

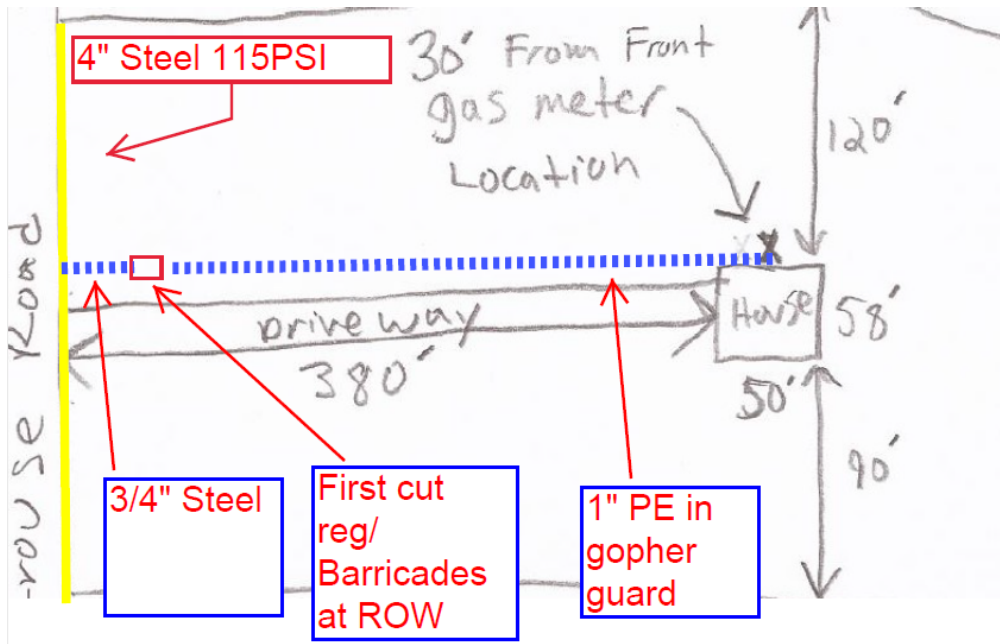

Technician Name: Telephone: Date: