
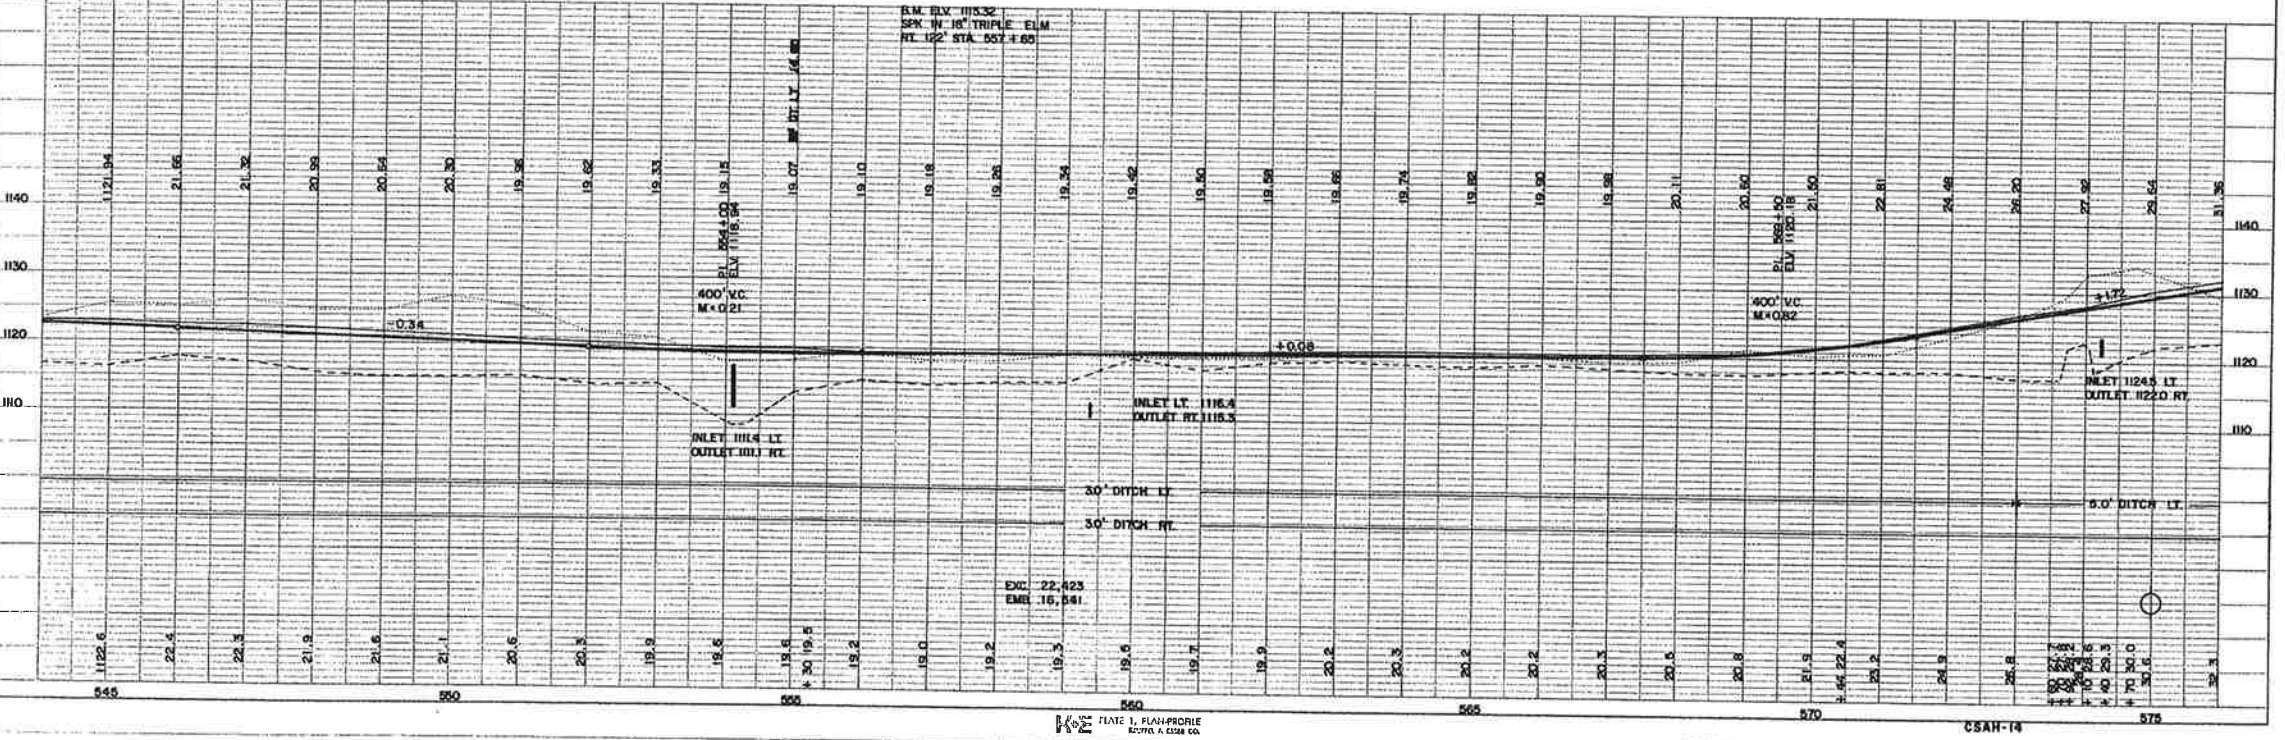




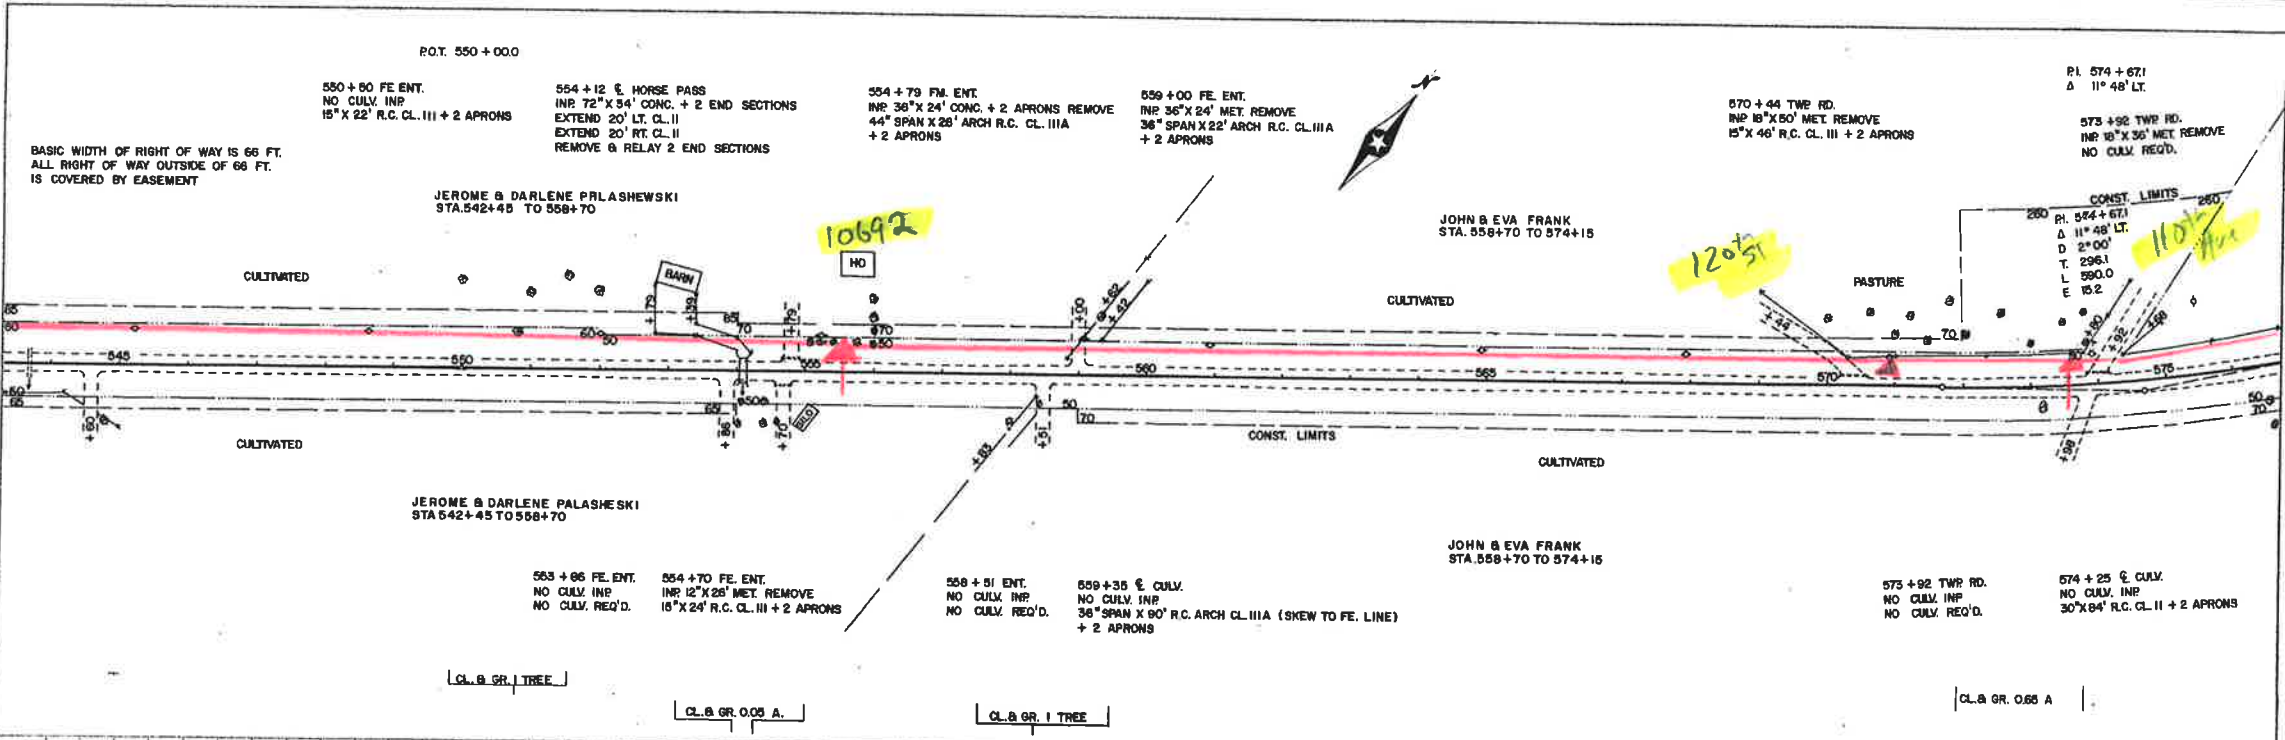


STATE 1, FLAHPROFILE




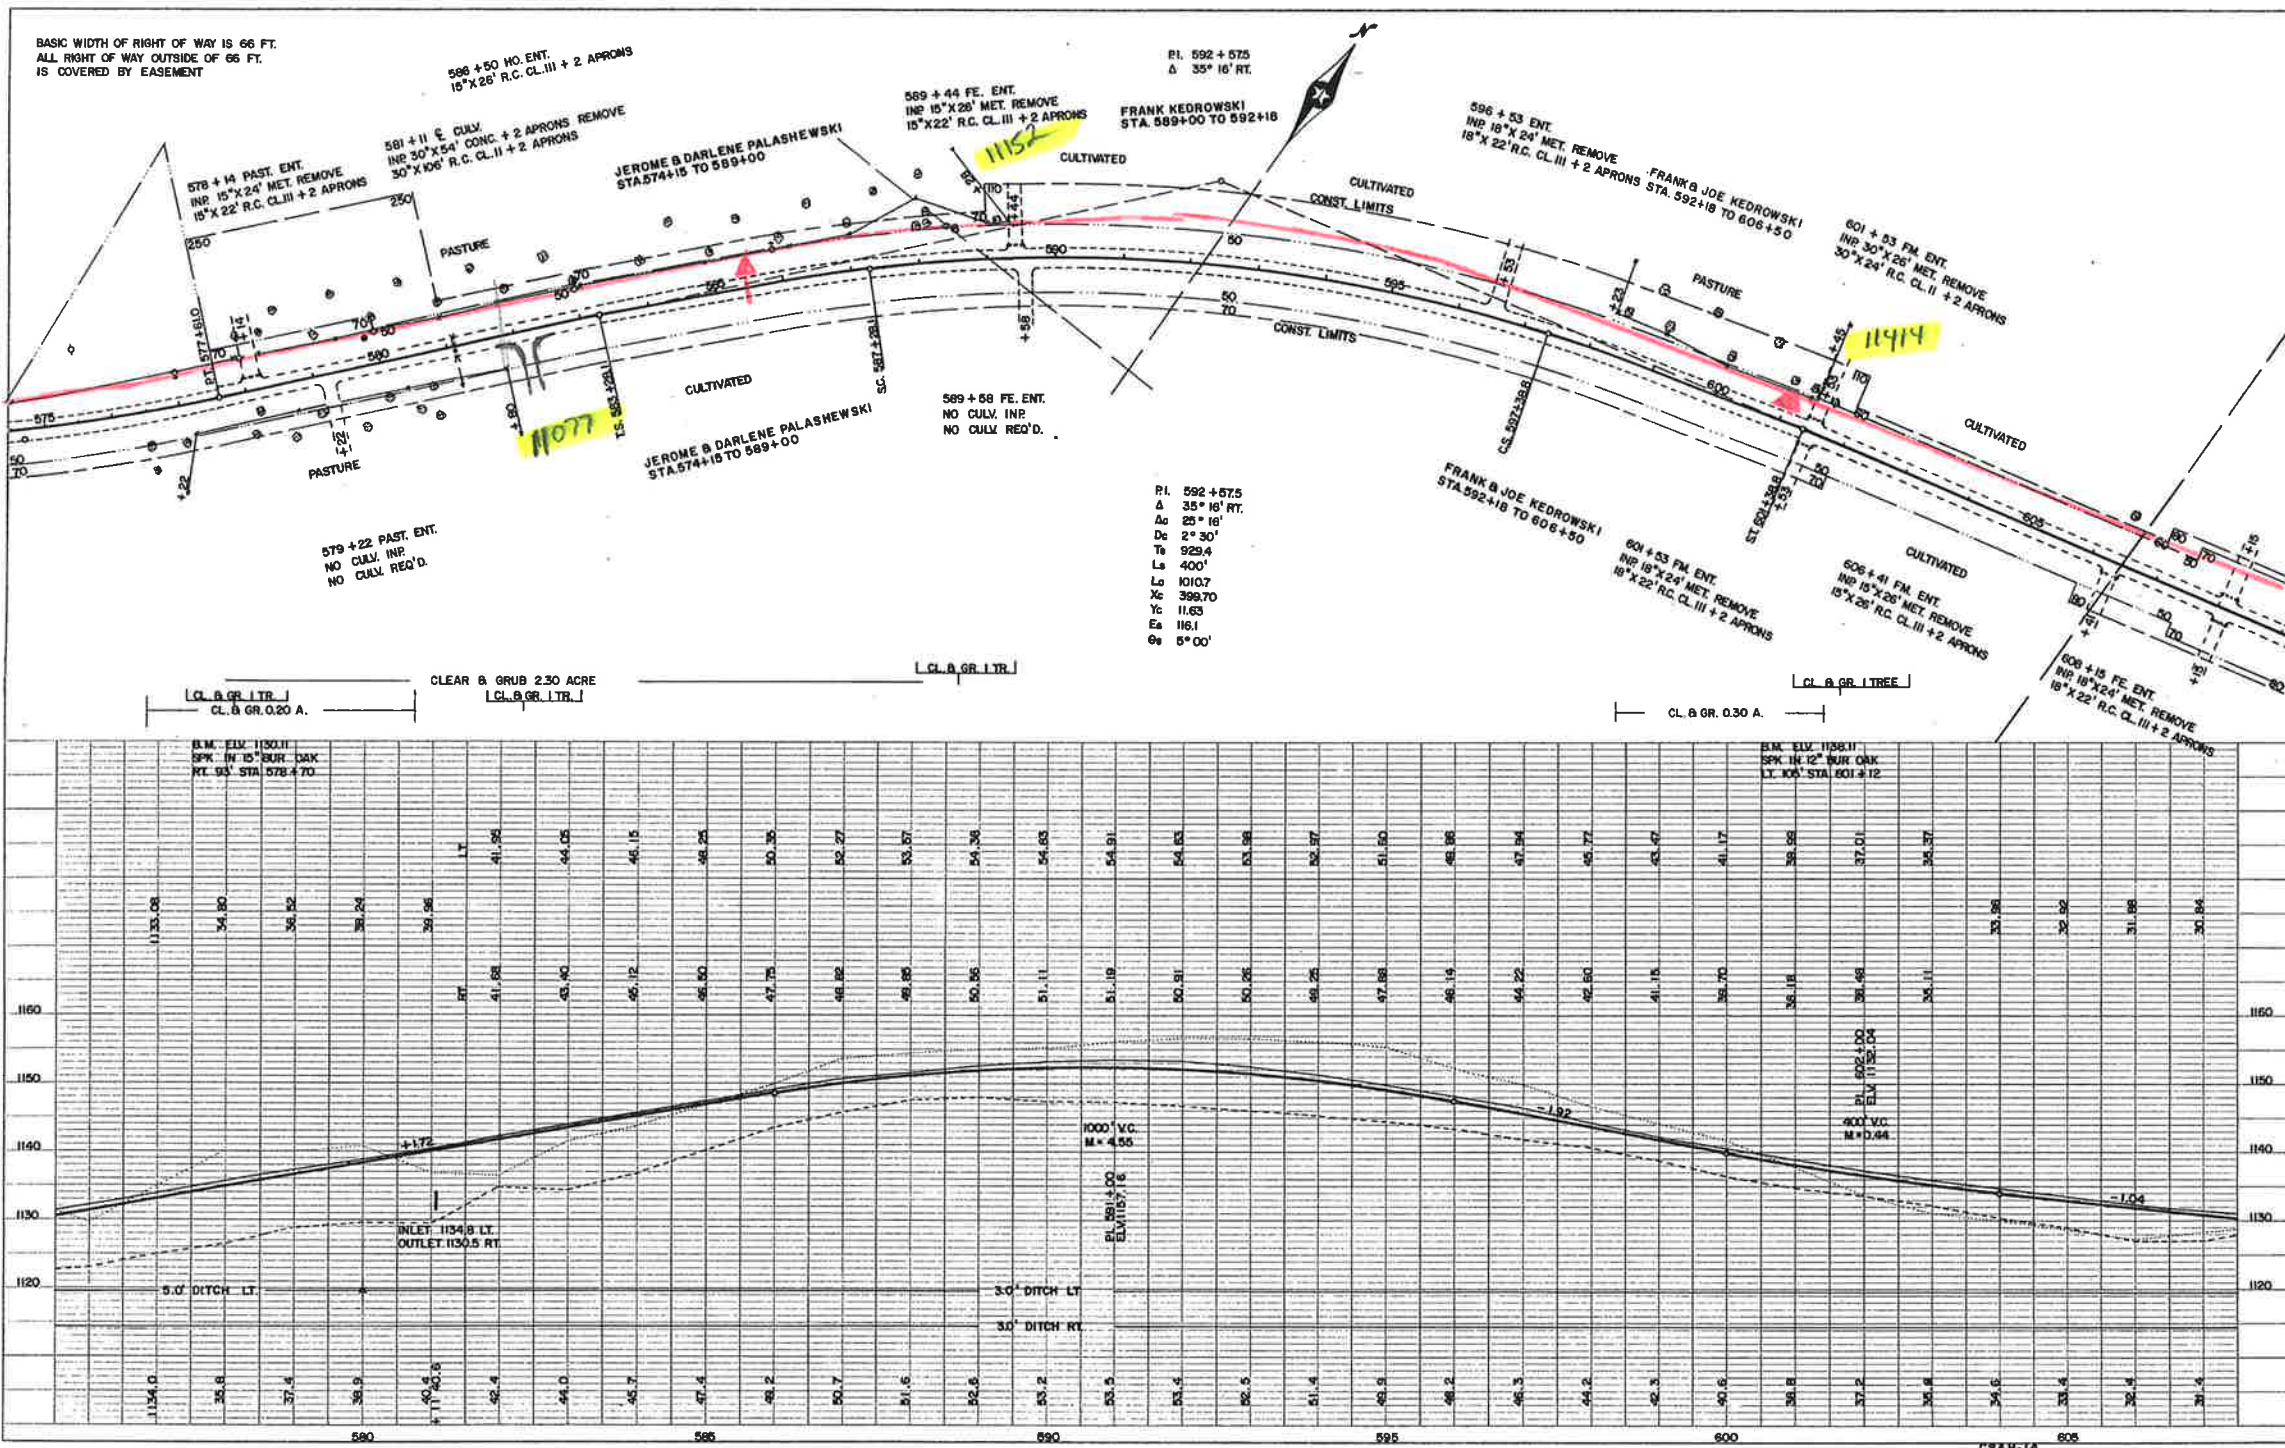




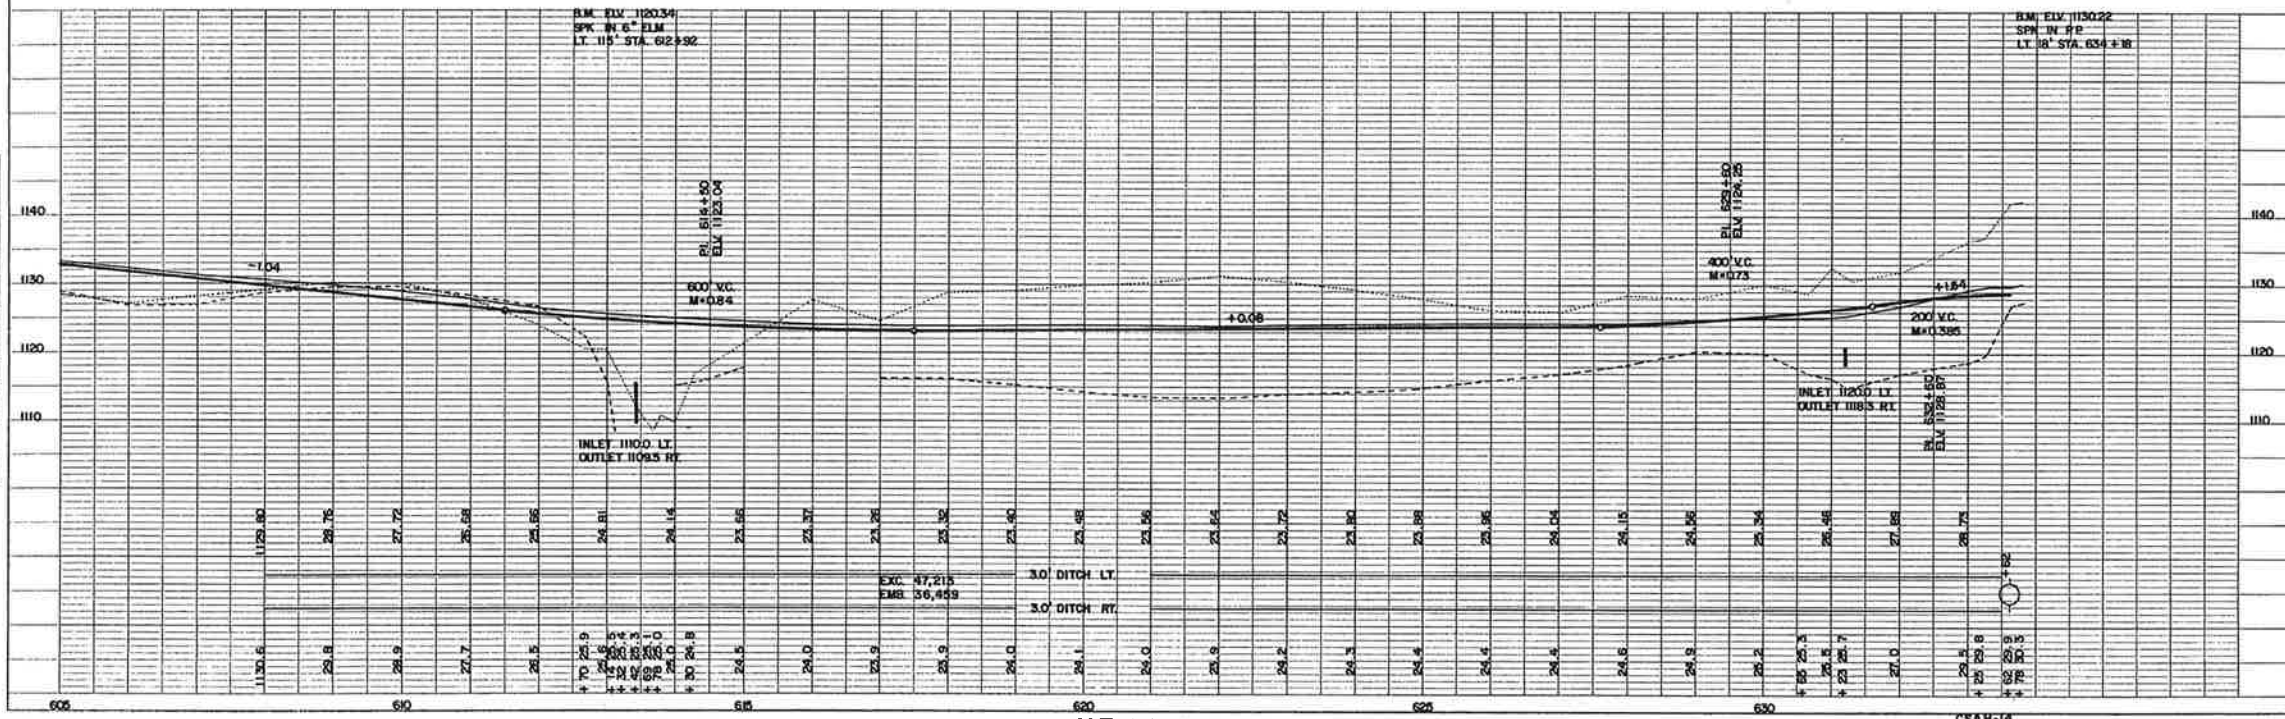
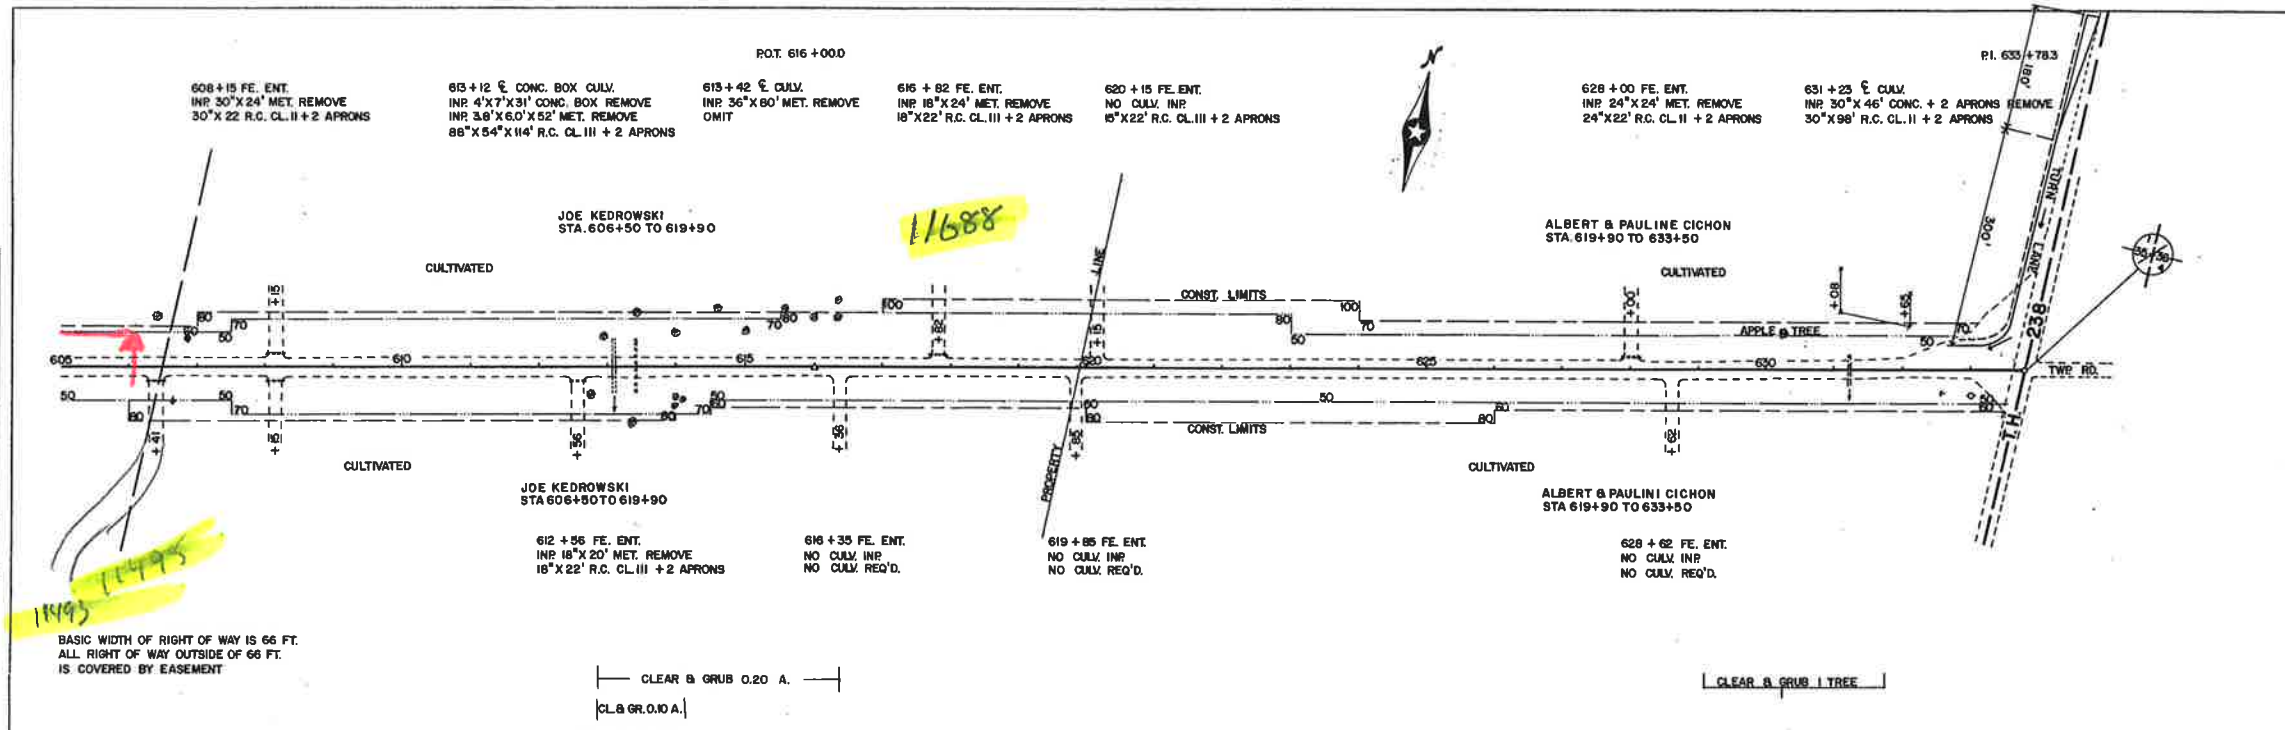


PLATE 1, PLAN PROFILE
 S&P 49-614-06 FROM EAST CORPORATE LIMITS TO TH. 238 SHEET 6 OF 16 SHEETS

