


GENERAL LOCATION ONLY. DO NOT USE TO LOCATE FOR EXCAVATION. CALL 1-800-252-1166 FOR ONSITE LOCATIONS AND STAKING.

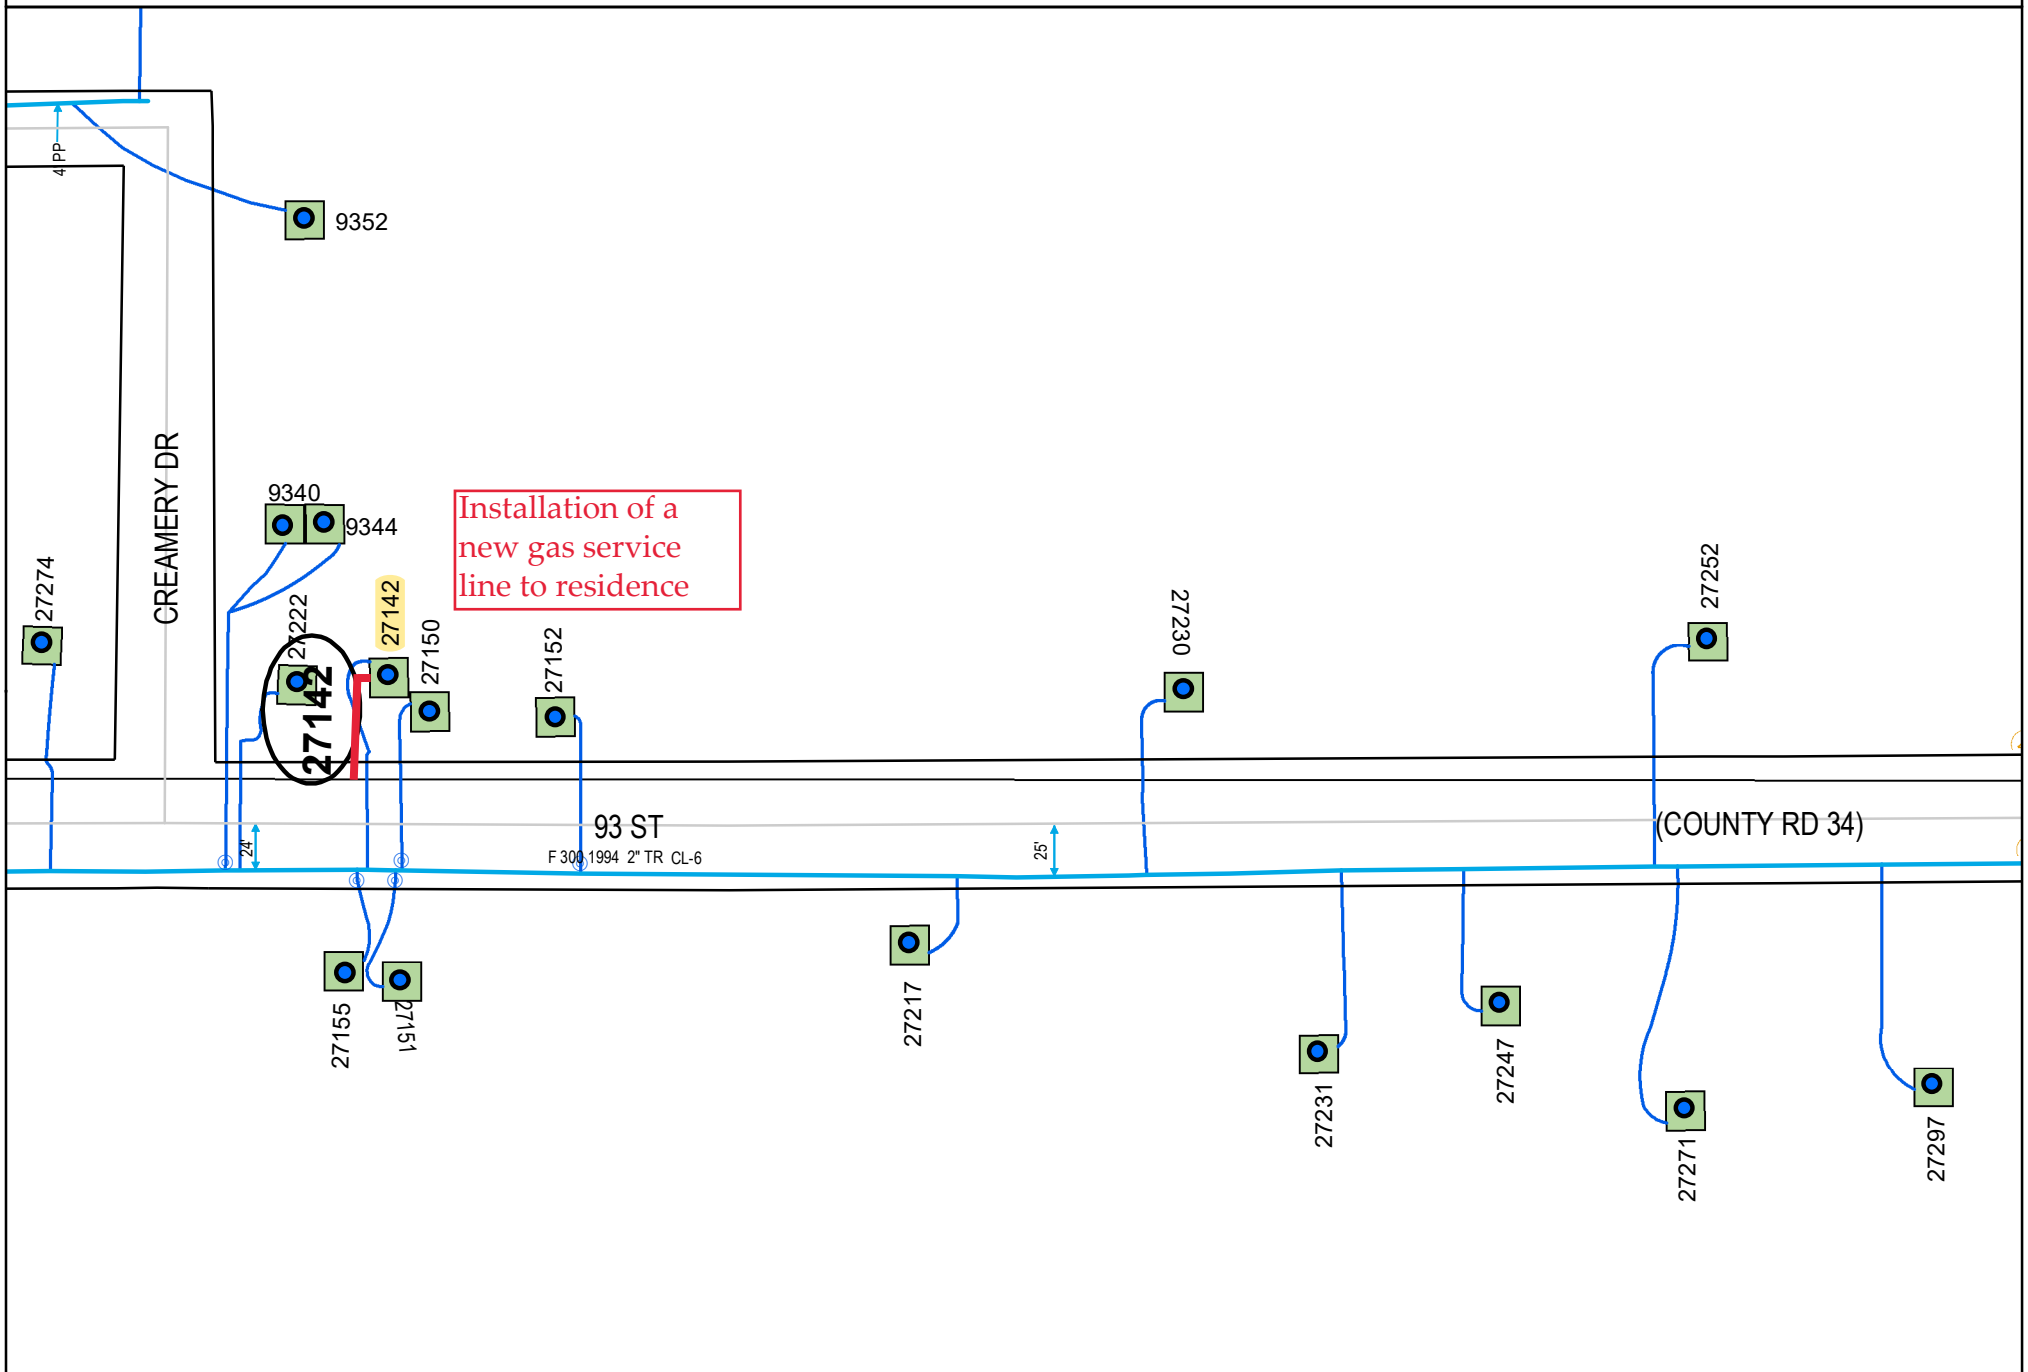

Plotted by: i228736 SAP# 104731279
Plot Date: 9/15/2022 MGC# 22-68431

27142 93RD ST
BUCKMAN, MORRISON COUNTY

Scale: 1" : 100'
CenterPoint Energy
North