WO #: **530626**

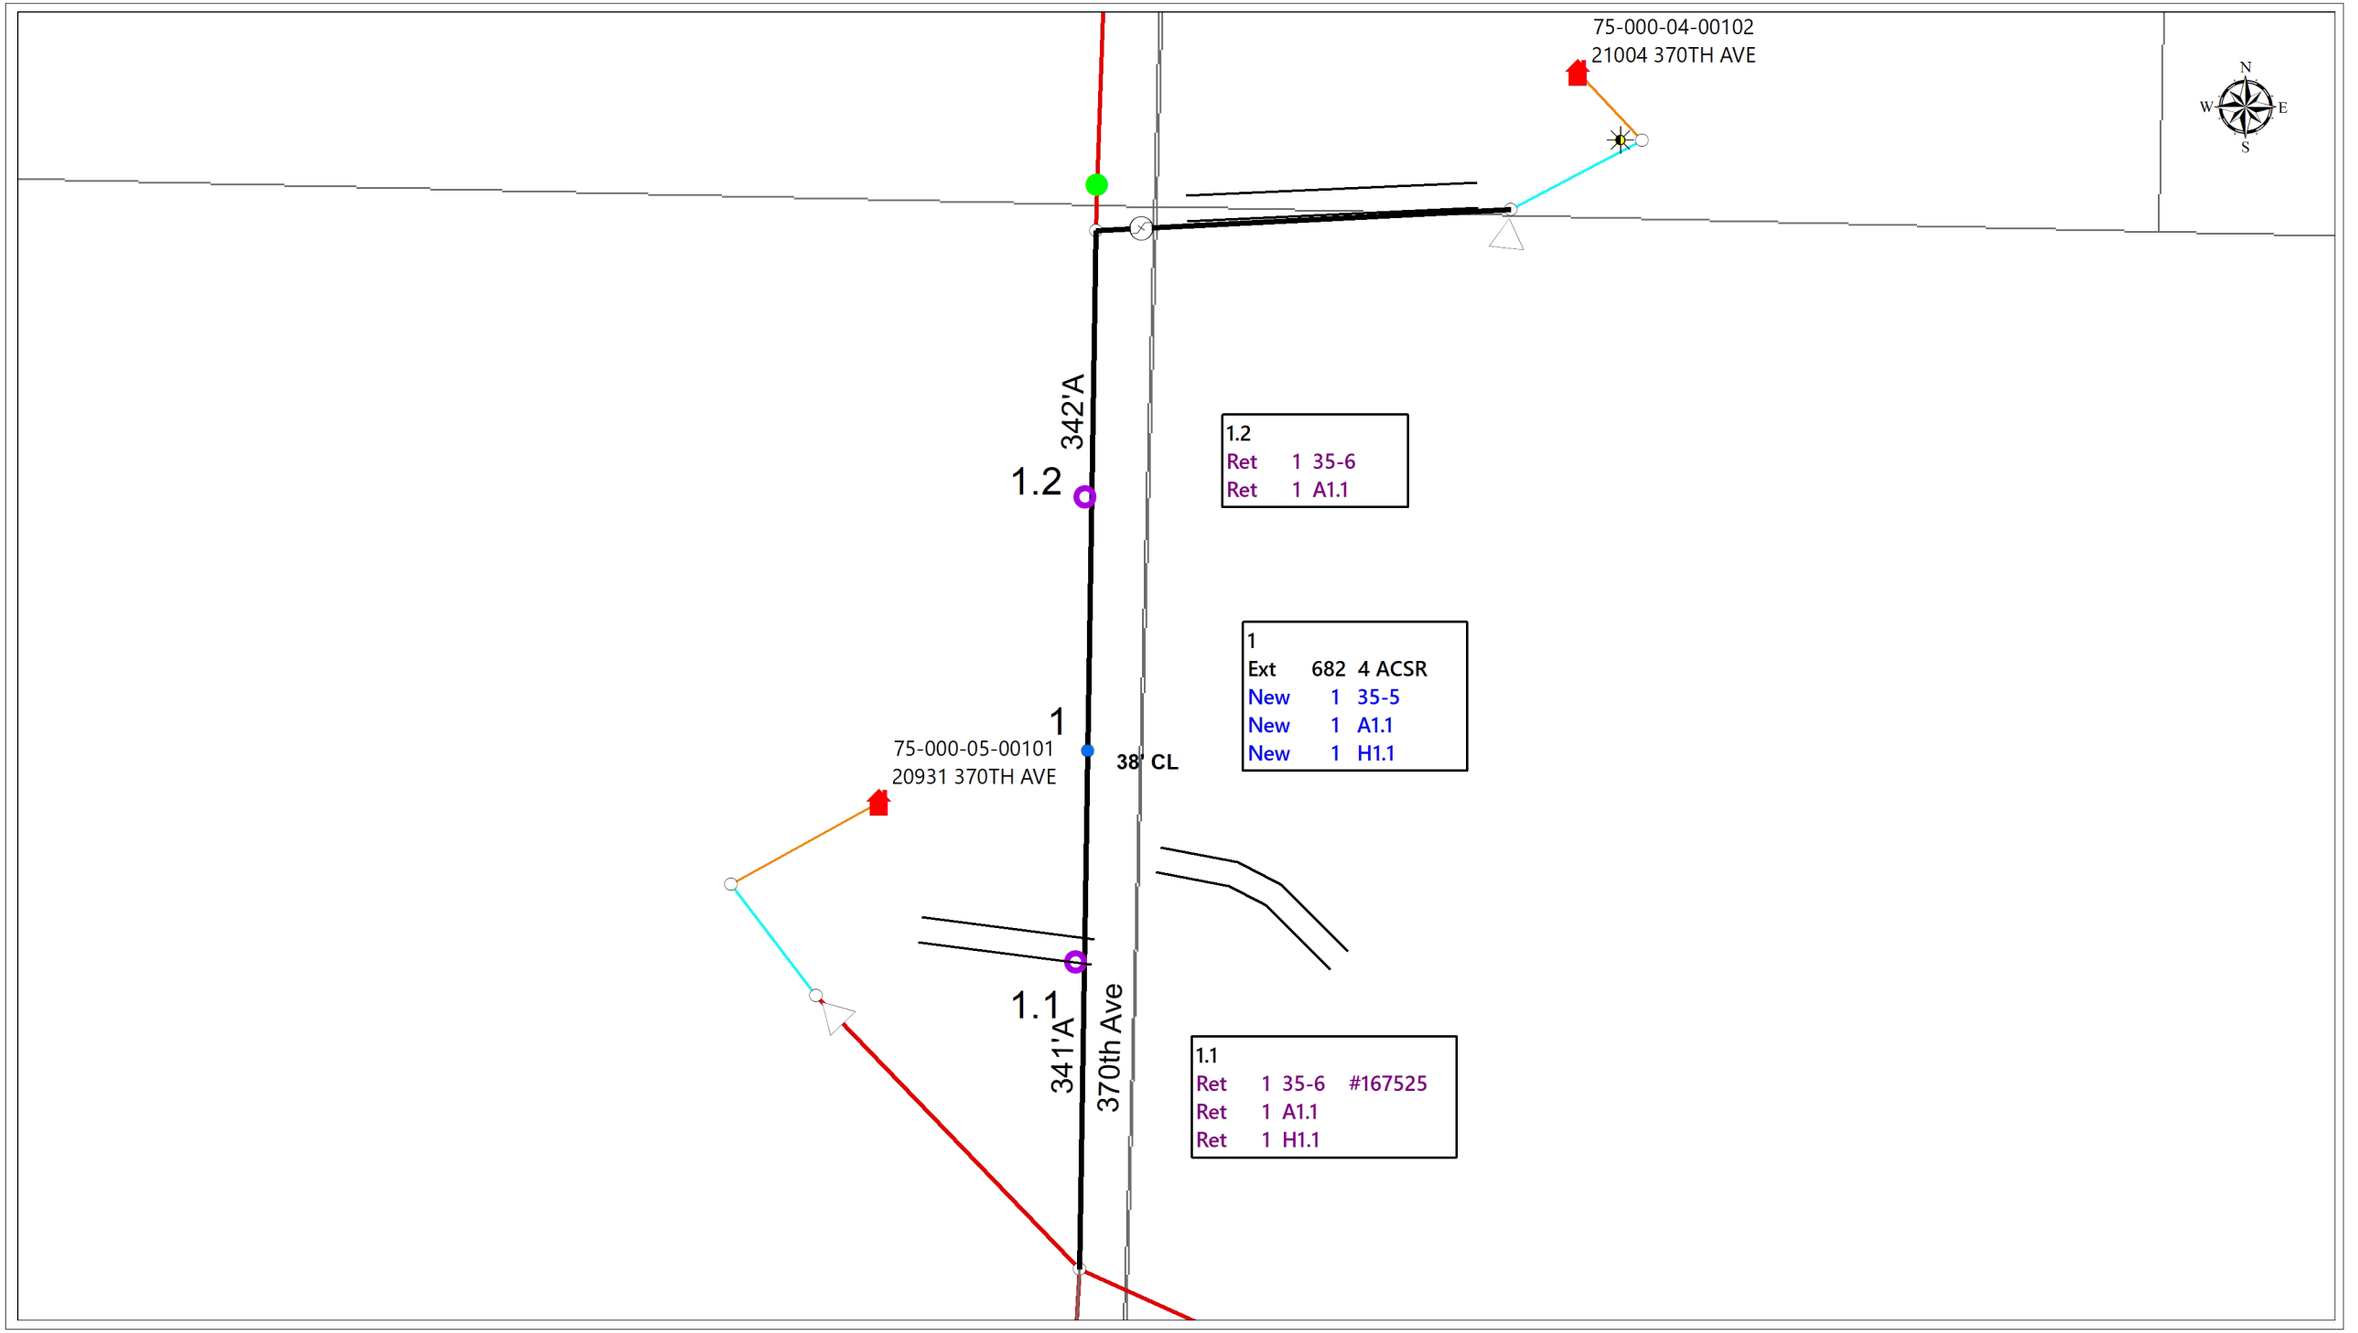
75-000-04-00102
21004 370TH AVE
N
W
E
S
342'A
1.2
1.2
Ret 1 35-6
Ret 1 A1.1
1
Ext 682 4 ACSR
New 1 35-5
New 1 A1.1
New 1 H1.1
1
75-000-05-00101
20931 370TH AVE
38' CL
1.1
341'A
370th Ave
1.1
Ret 1 35-6 #167525
Ret 1 A1.1
Ret 1 H1.1