


© Bolton & Menk, Inc. 2022. All Rights Reserved.
 H:\ROYALTON_CI_MIN\081126540\CAO\126540.dwg 12/15/2022 4:15:40 PM

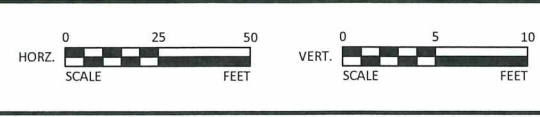

I HEREBY CERTIFY THAT THIS PLAN, SPECIFICATION, OR REPORT WAS PREPARED BY ME OR UNDER MY DIRECT SUPERVISION AND THAT I AM A DULY LICENSED PROFESSIONAL ENGINEER UNDER THE LAWS OF THE STATE OF MINNESOTA.
Phillip Martin
 PHILLIP MARTIN
 LIC. NO. 25378 DATE 12/15/2022





7656 DESIGN ROAD, SUITE 200
 BAXTER, MINNESOTA 56425
 Phone: (218) 825-0684
 Email: Baxter@bolton-menk.com
 www.bolton-menk.com


DESIGNED	NO.	ISSUED FOR	DATE
AJV			
DRAWN			
AJV			
CHECKED			
PMM			
CLIENT PROJ. NO.			
081.126540			

CITY OF ROYALTON, MINNESOTA
 2023 UTILITY IMPROVEMENTS
 CR 234 UTILITIES PLAN & PROFILE

SHEET
 27
 OF
 67

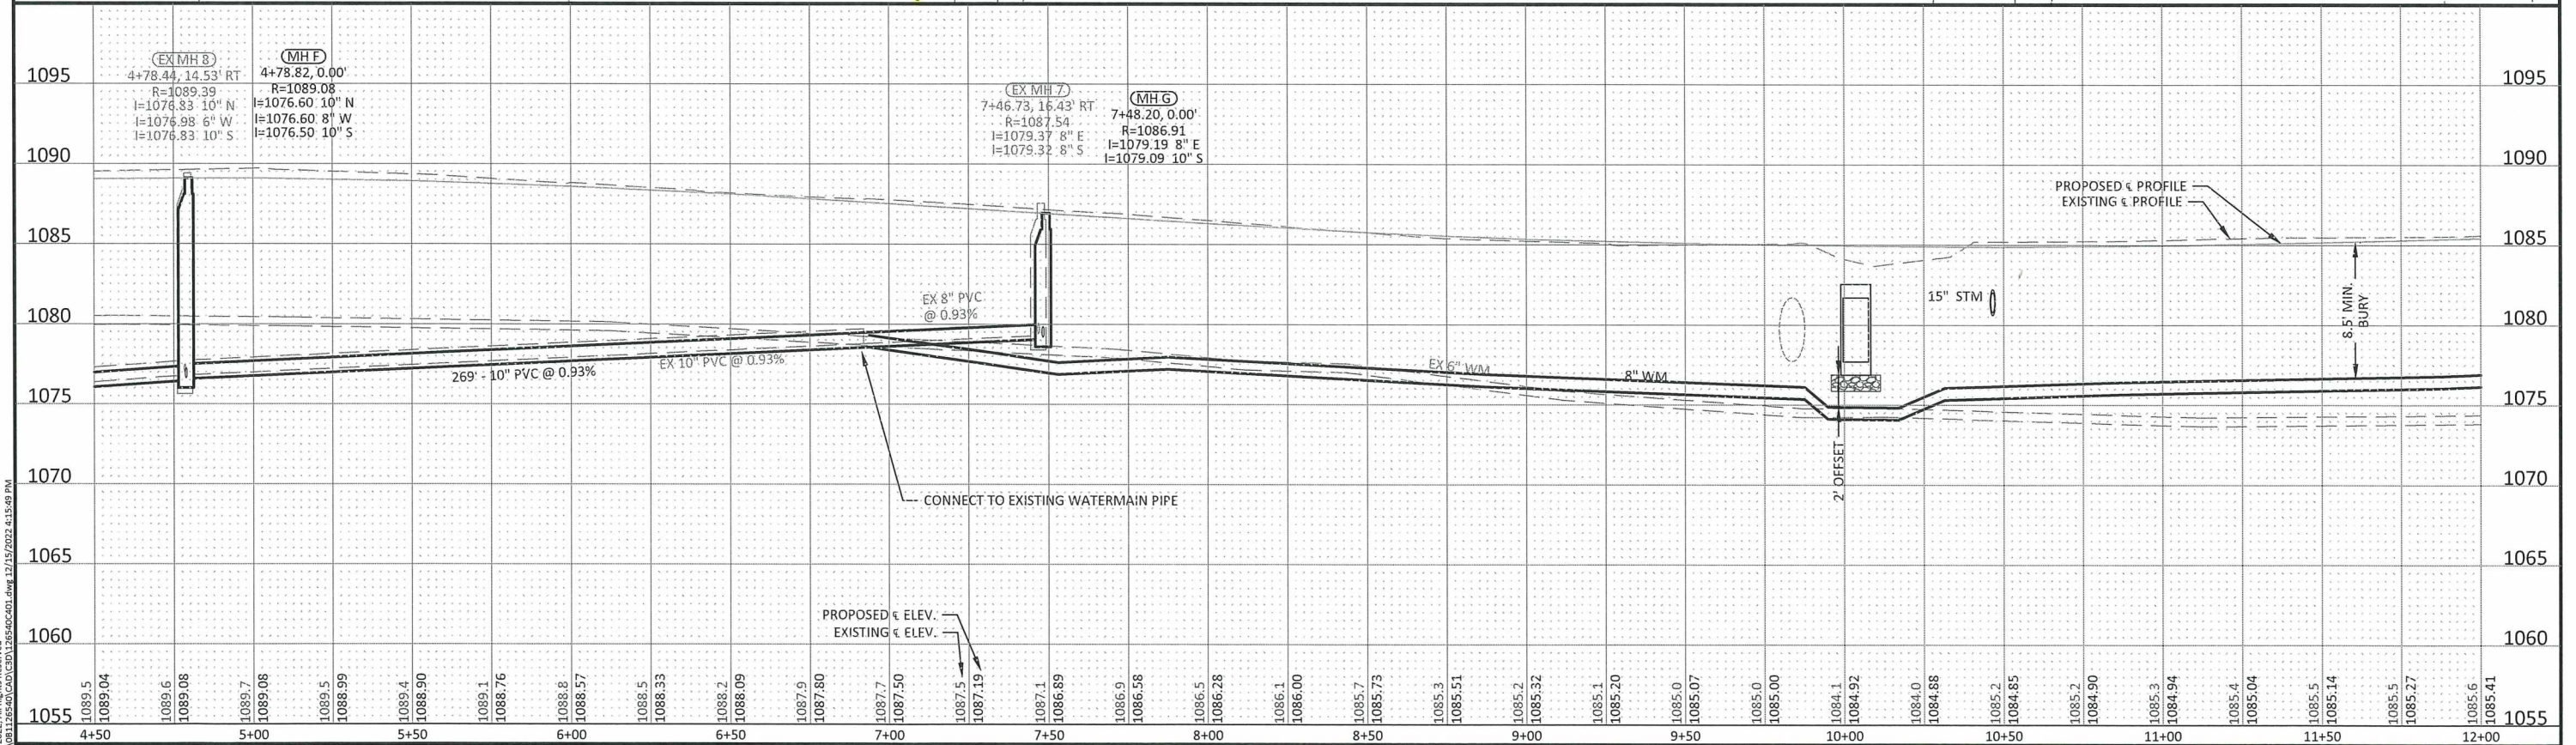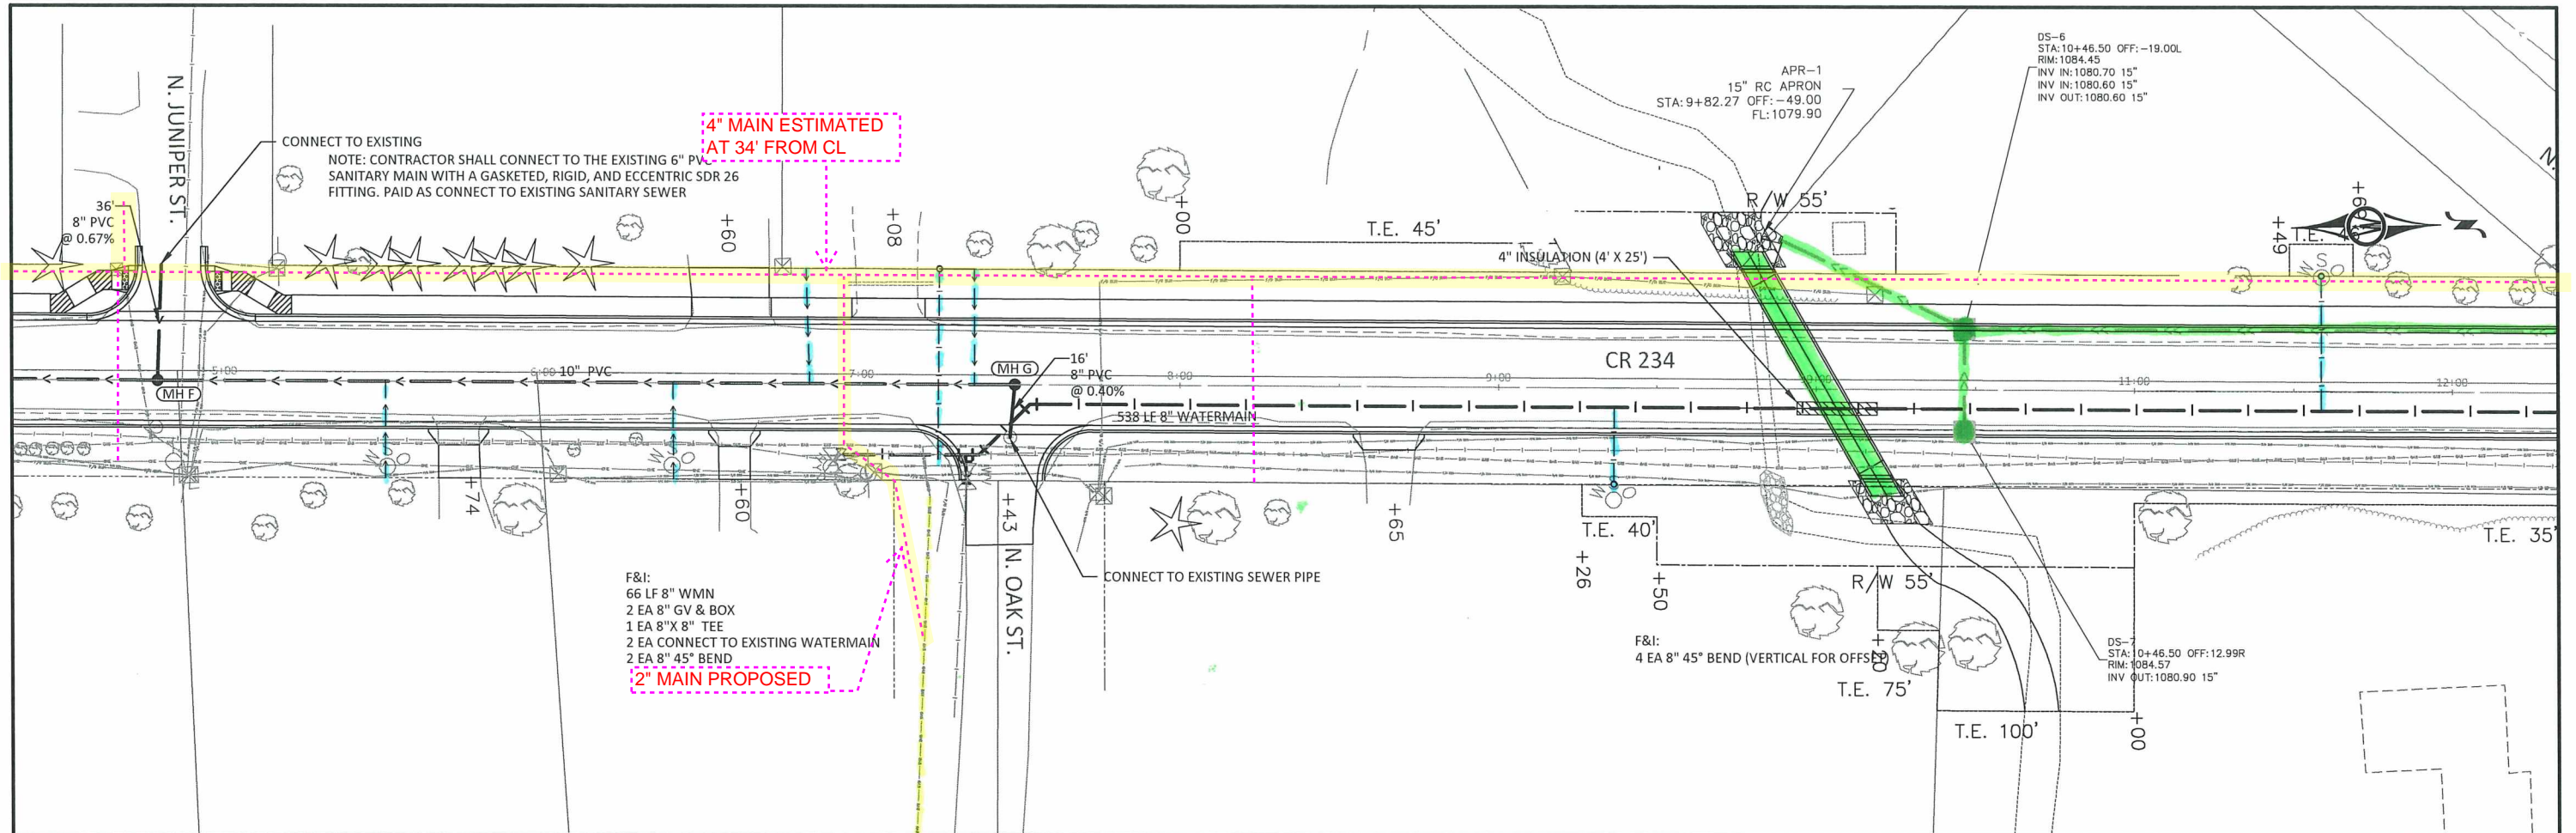

© Bolton & Menk, Inc. 2022. All Rights Reserved. P:\ROYALTON_CITY_MH\081126540\CAO\126540.dwg, 12/15/2022, 4:15:49 PM

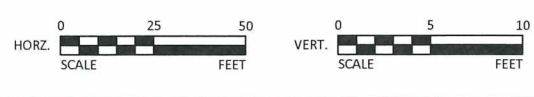

I HEREBY CERTIFY THAT THIS PLAN, SPECIFICATION, OR REPORT WAS PREPARED BY ME OR UNDER MY DIRECT SUPERVISION AND THAT I AM A DULY LICENSED PROFESSIONAL ENGINEER UNDER THE LAWS OF THE STATE OF MINNESOTA.



Phillip Martin
PHILLIP MARTIN
LIC. NO. 25378 DATE 12/15/2022



7656 DESIGN ROAD, SUITE 200
BAXTER, MINNESOTA 56425
Phone: (218) 825-0684
Email: Baxter@bolton-menk.com
www.bolton-menk.com

DESIGNED	NO.	ISSUED FOR	DATE
AJV			
DRAWN			
AJV			
CHECKED			
PMM			
CLIENT PROJ. NO.	081.126540		

CITY OF ROYALTON, MINNESOTA
2023 UTILITY IMPROVEMENTS
CR 234 UTILITIES PLAN & PROFILE

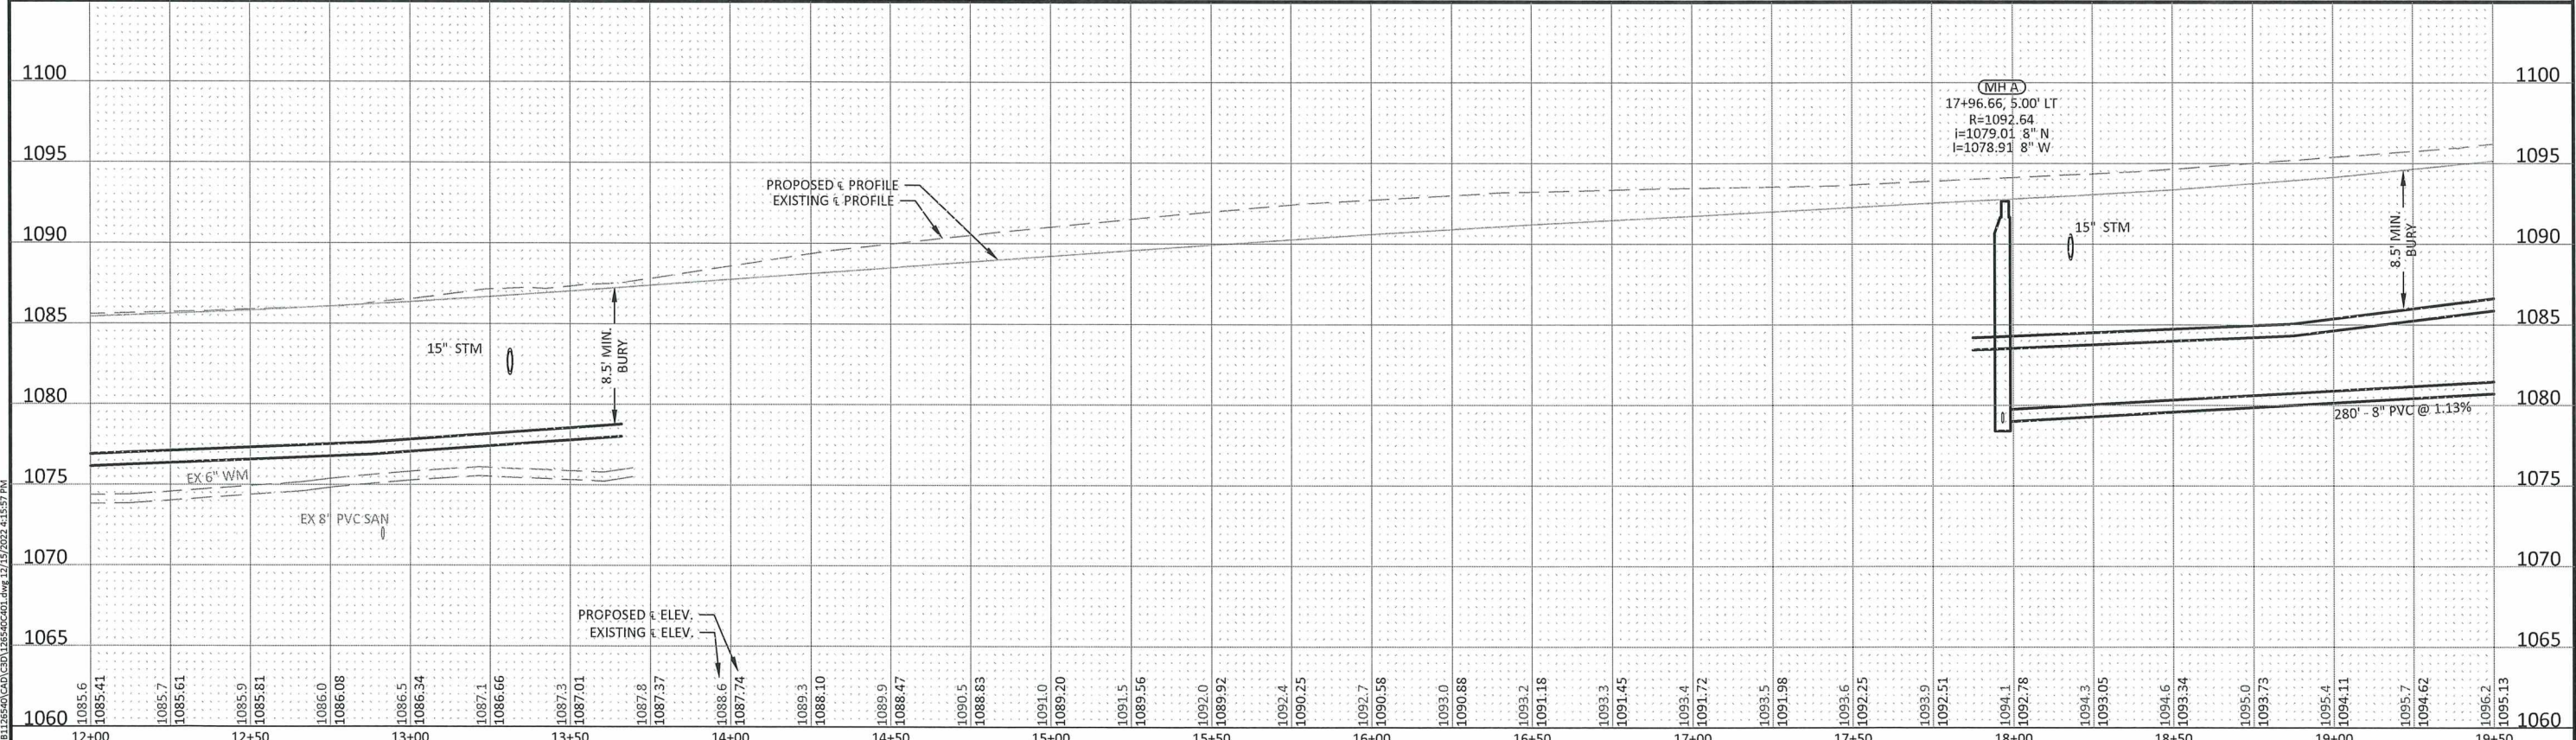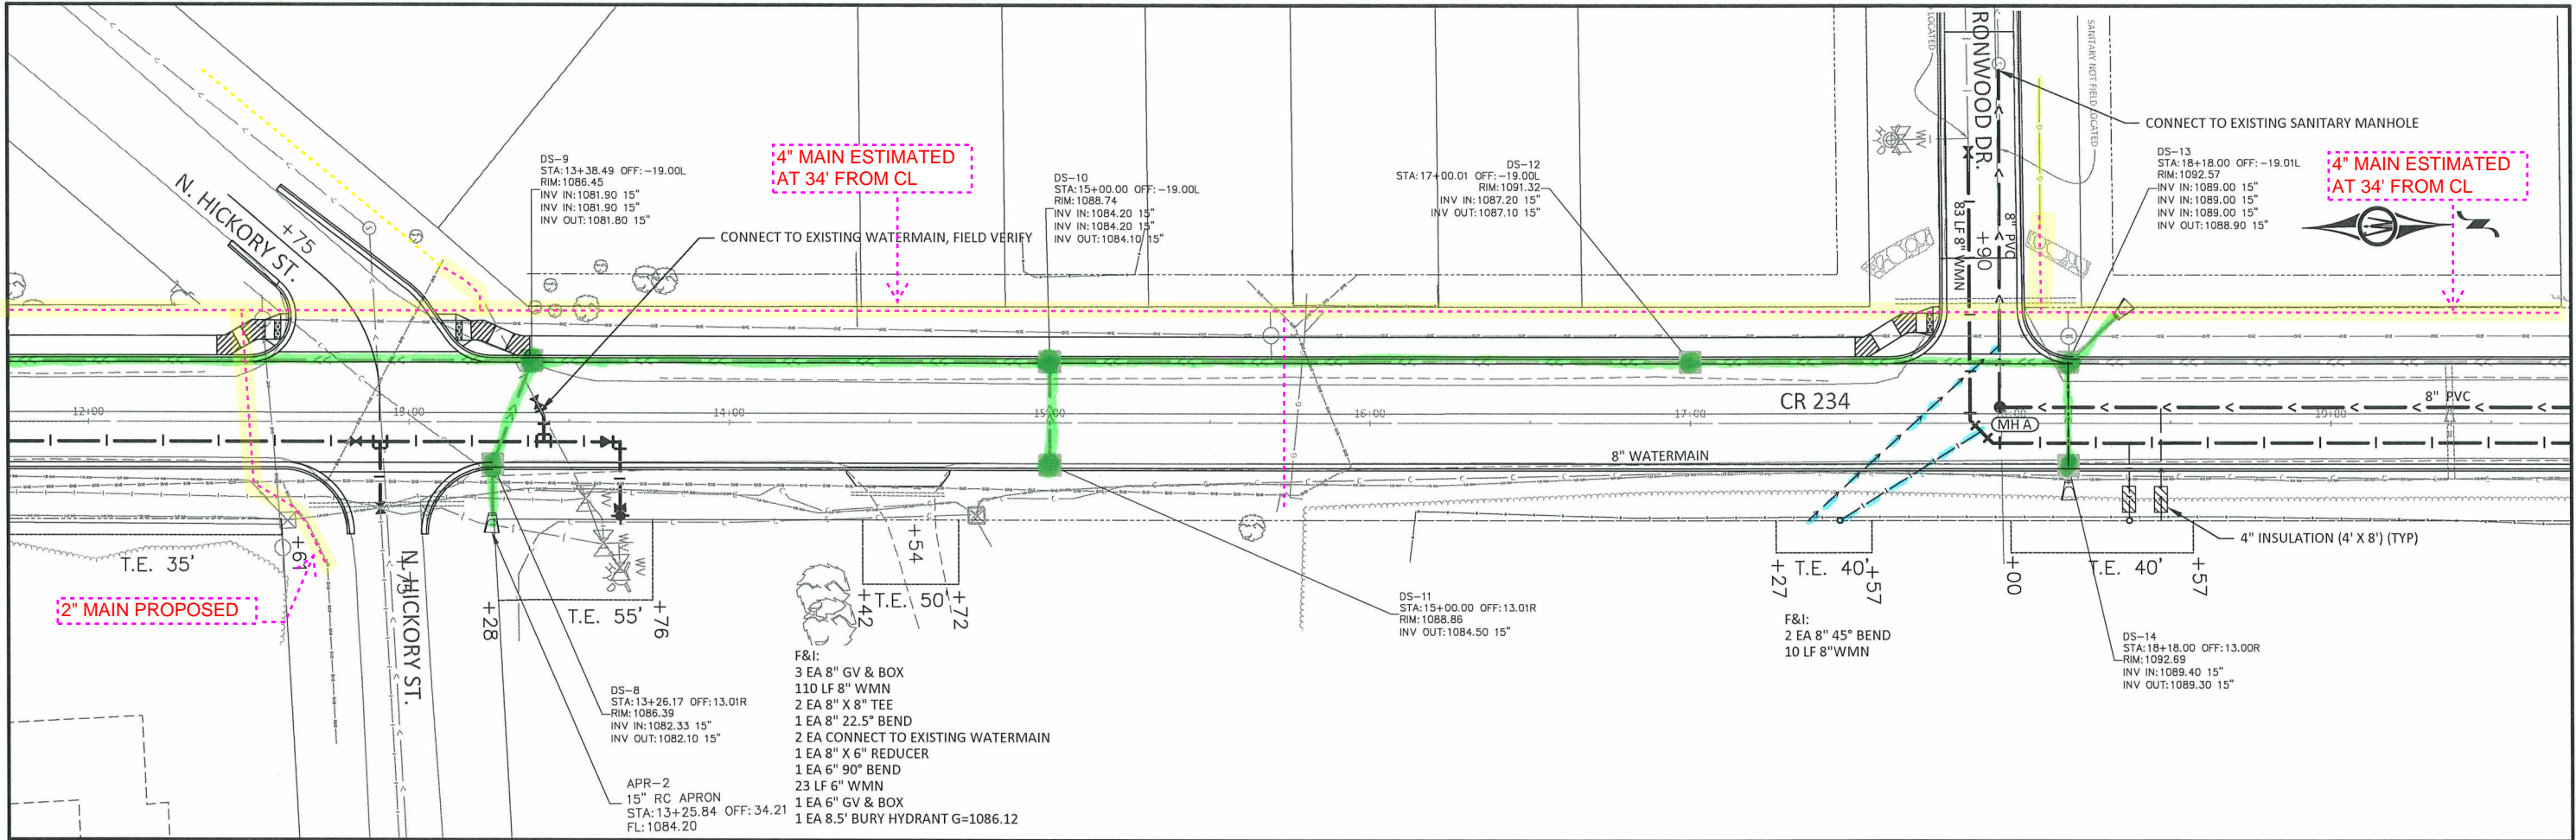

© Bolton & Menk, Inc. 2022. All Rights Reserved. H:\ROYALTON_CITY\126540\CAD\3D\126540C01.dwg 12/15/2022 4:15:57 PM



I HEREBY CERTIFY THAT THIS PLAN, SPECIFICATION, OR REPORT WAS PREPARED BY ME OR UNDER MY DIRECT SUPERVISION AND THAT I AM A DULY LICENSED PROFESSIONAL ENGINEER UNDER THE LAWS OF THE STATE OF MINNESOTA.

Phillip Martin
 PHILLIP MARTIN
 LIC. NO. 25378 DATE 12/15/2022





7656 DESIGN ROAD, SUITE 200
 BAXTER, MINNESOTA 56425
 Phone: (218) 825-0684
 Email: baxter@bolton-menk.com
 www.bolton-menk.com


DESIGNED	AJV	DATE	
DRAWN	AJV		
CHECKED	PMM		
CLIENT PROJ. NO.	081.126540		

CITY OF ROYALTON, MINNESOTA
 2023 UTILITY IMPROVEMENTS
 CR 234 UTILITIES PLAN & PROFILE

SHEET
 29
 OF
 67

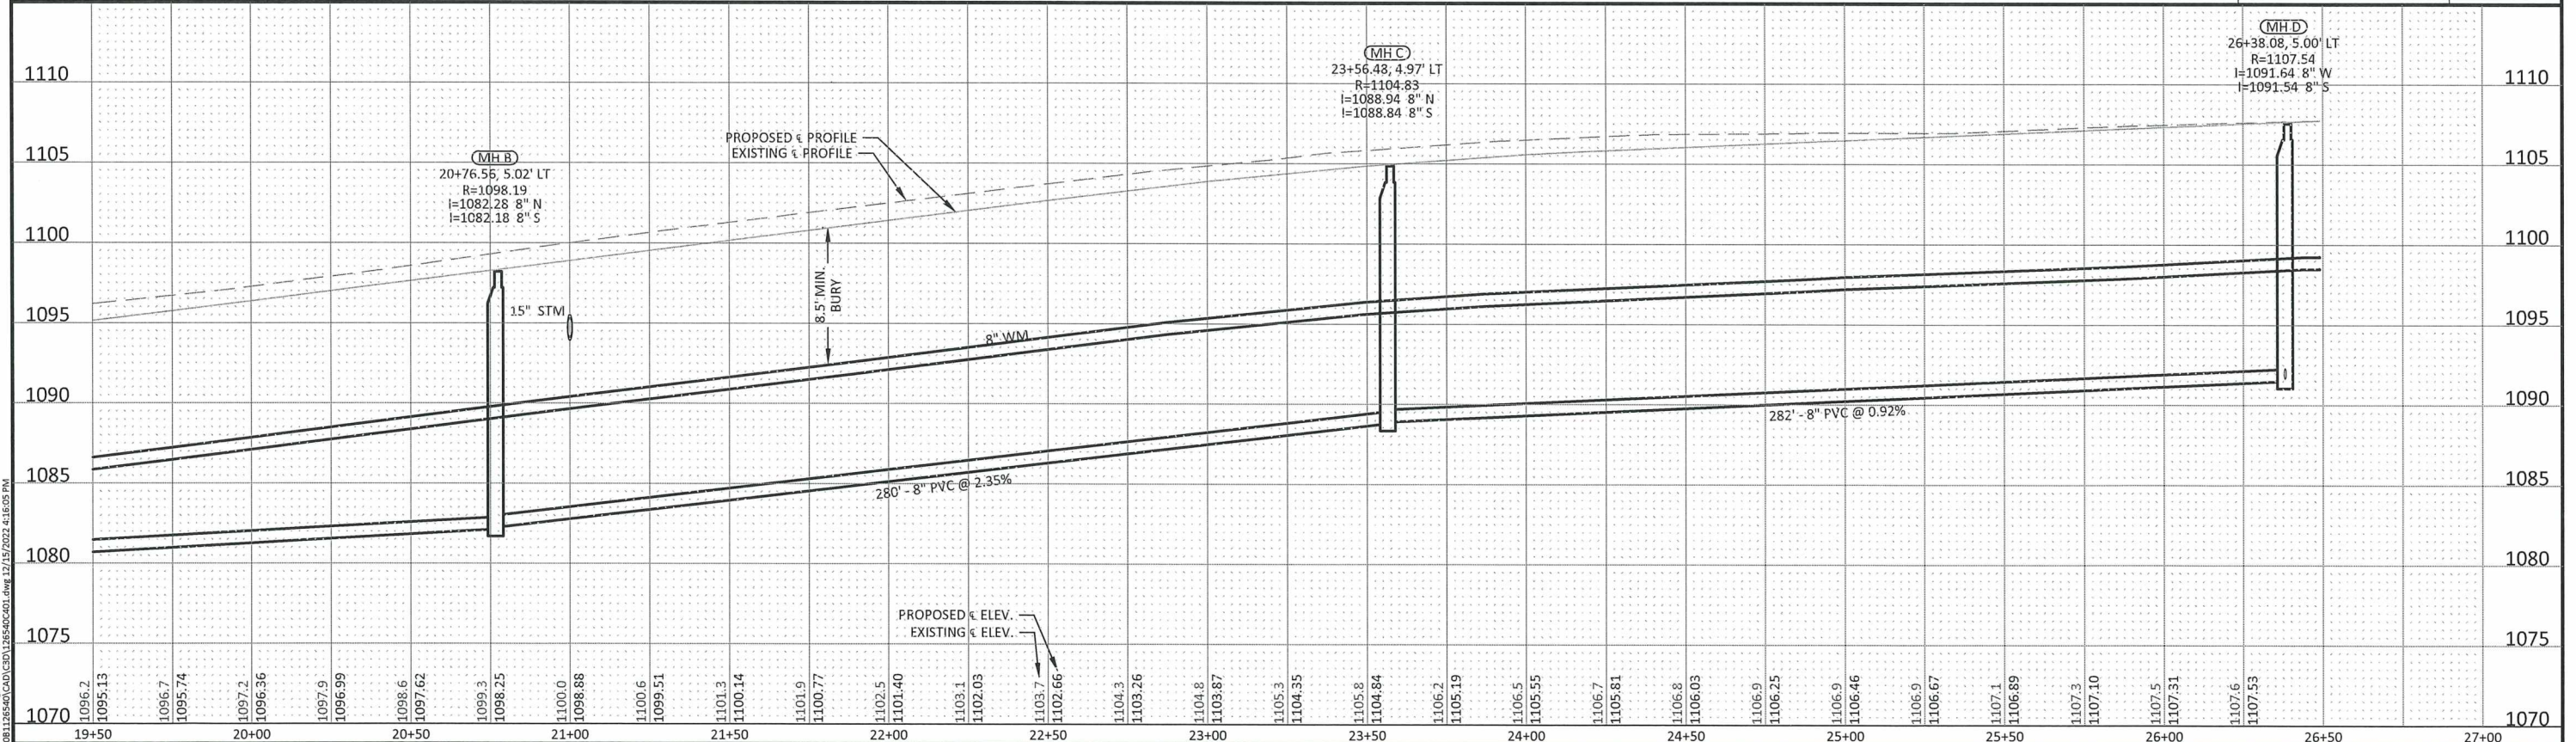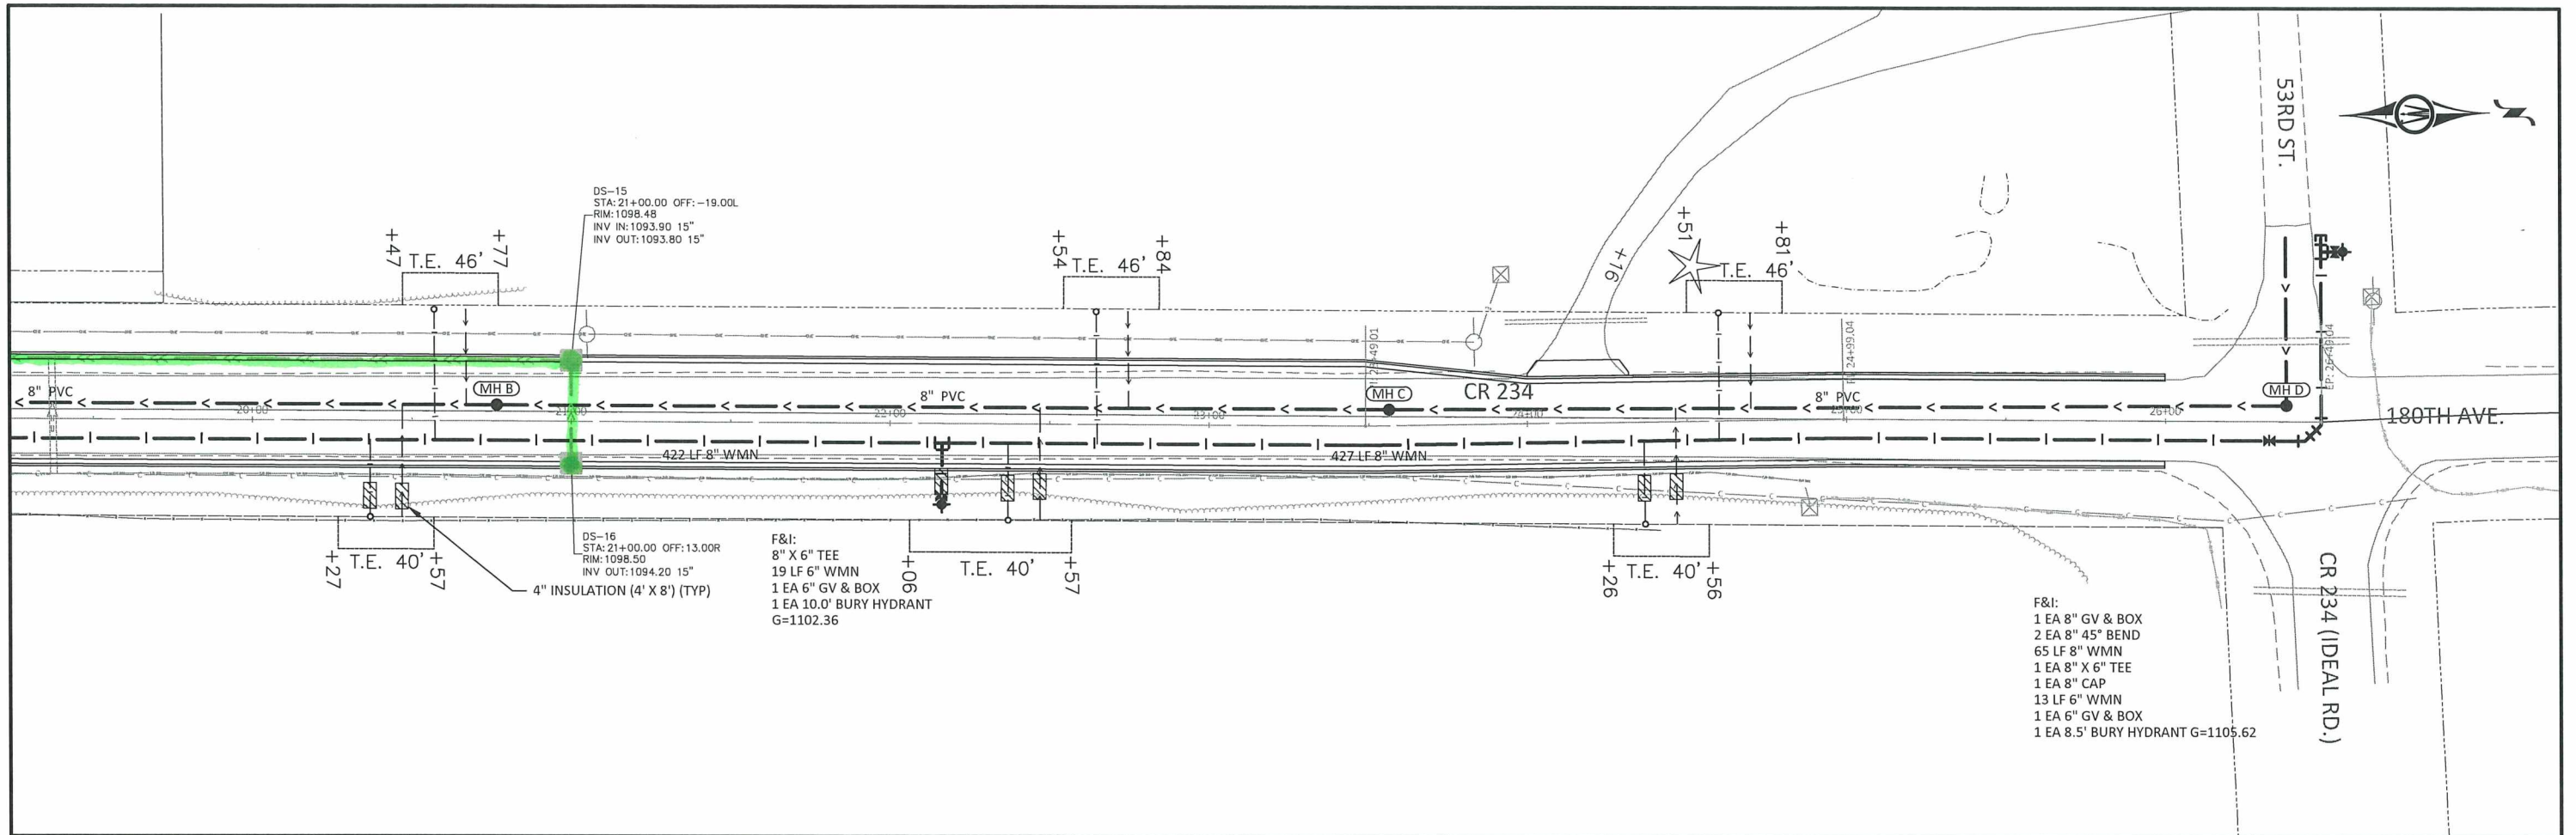

© Bolton & Menk, Inc. 2022. All Rights Reserved. P:\ROYALTON_CITY_MH\081126540\CAO\126540C01.dwg 12/15/2022 4:16:05 PM

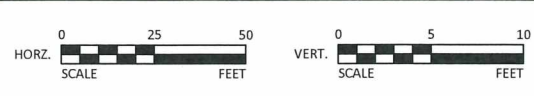

I HEREBY CERTIFY THAT THIS PLAN, SPECIFICATION, OR REPORT WAS PREPARED BY ME OR UNDER MY DIRECT SUPERVISION AND THAT I AM A DULY LICENSED PROFESSIONAL ENGINEER UNDER THE LAWS OF THE STATE OF MINNESOTA.

Phillip Martin
 PHILLIP MARTIN
 LIC. NO. 25378 DATE 12/15/2022



7656 DESIGN ROAD, SUITE 200
 BAXTER, MINNESOTA 56425
 Phone: (218) 825-0684
 Email: Baxter@bolton-menk.com
 www.bolton-menk.com

DESIGNED	DRAWN	CHECKED	CLIENT PROJ. NO.
AJV	AJV	PMM	081.126540
NO.	ISSUED FOR	DATE	

CITY OF ROYALTON, MINNESOTA
 2023 UTILITY IMPROVEMENTS
 CR 234 UTILITIES PLAN & PROFILE