






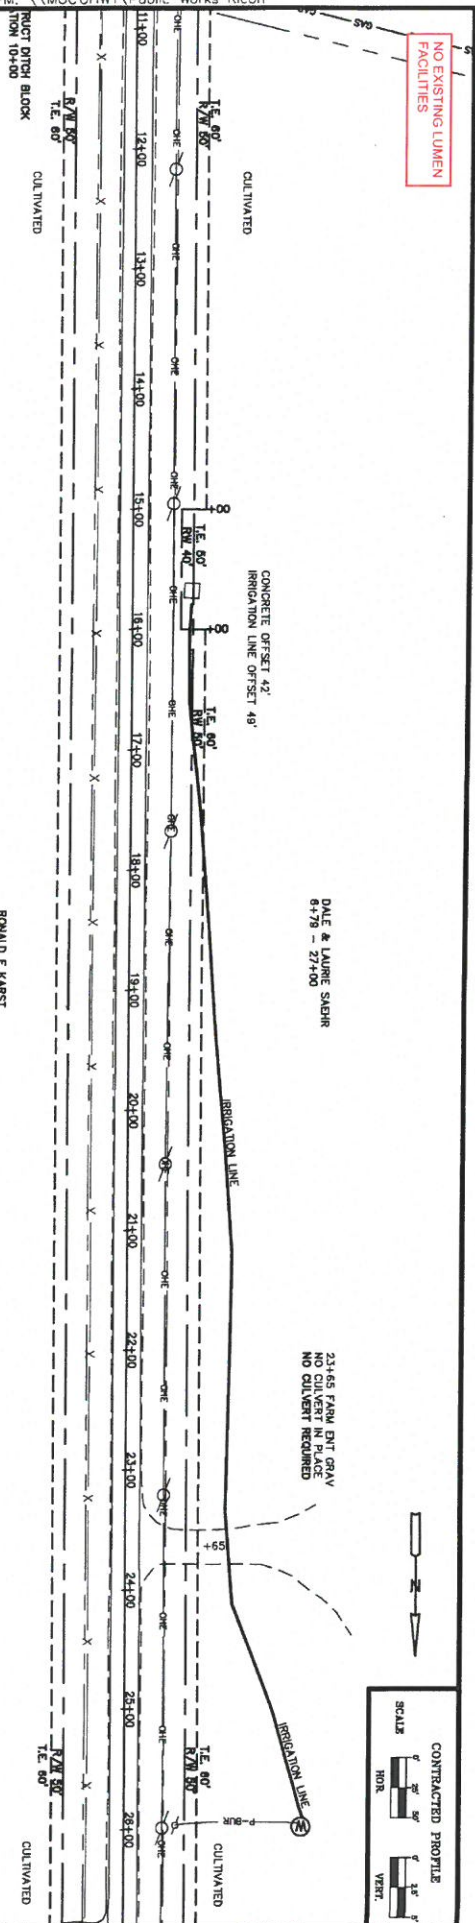


NO EXISTING LUMEN FACILITIES



**DRAFT**

NO CULVERT IN PLACE  
NO CULVERT REQUIRED

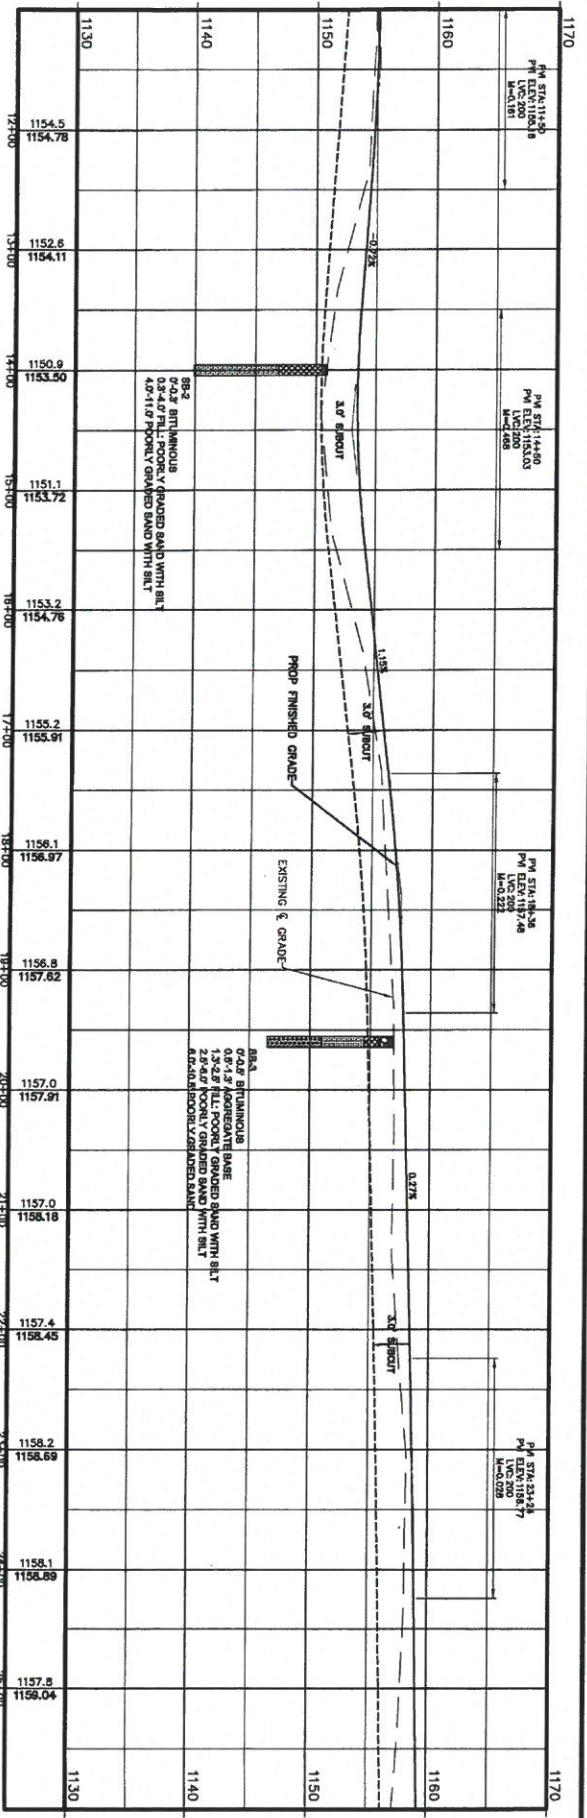

CONTRACTED PROFILE

SCALE: HORIZ. 1" = 20', VERT. 1" = 1'


ANTHONY E. HENNEN LIC. NO. 54395 DATE COUNTY PROJECT NO. 049-253-003 SHEET NO. 6 OF 20 SHEETS

NO EXISTING LUMEN FACILITIES



LLOYD P & SHARON J HOFFMAN  
 27+00 - 42+25

CONTRACTED PROFILE  
 SCALE  
 HOR. 1" = 40'  
 VERT. 1" = 4'

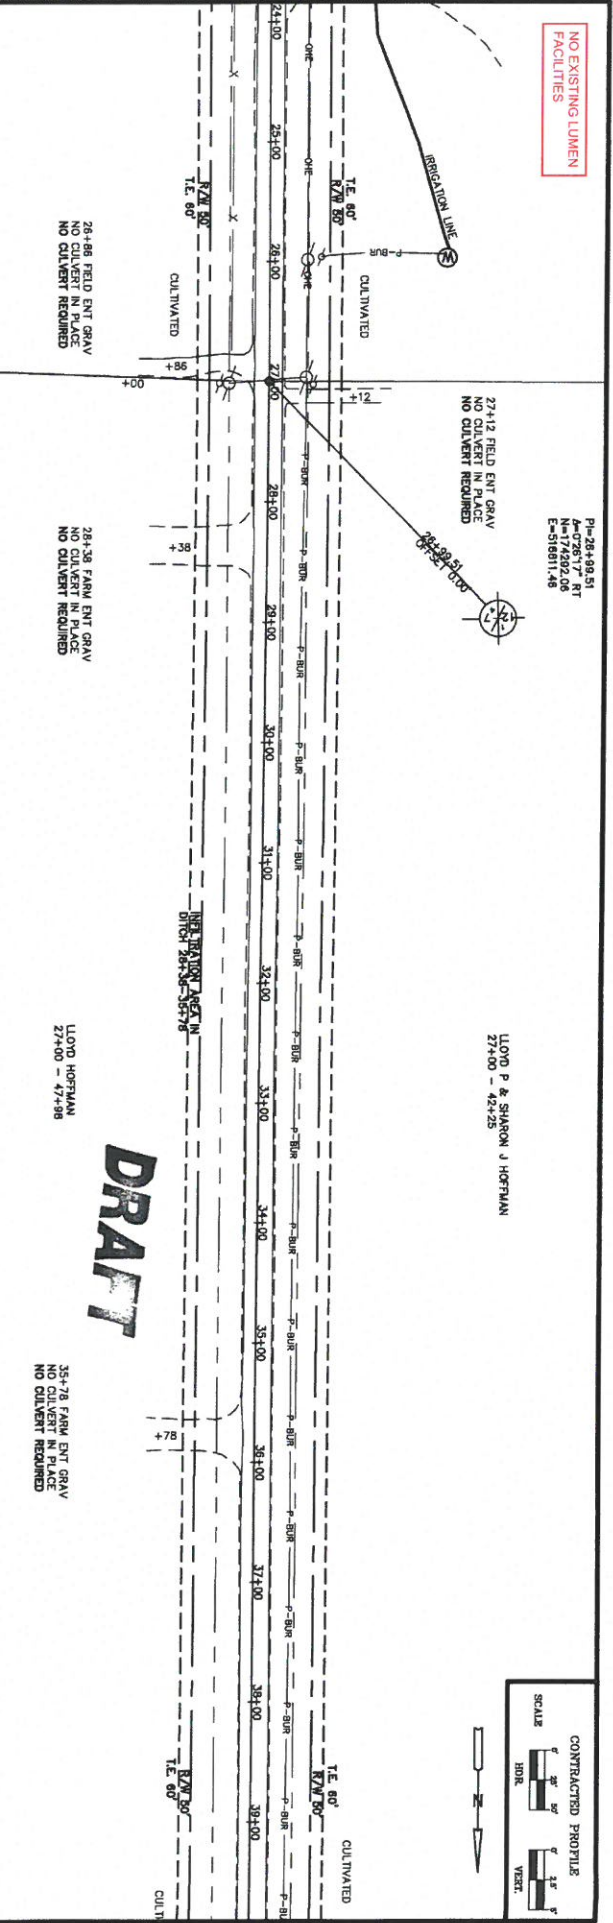


**DRAFT**

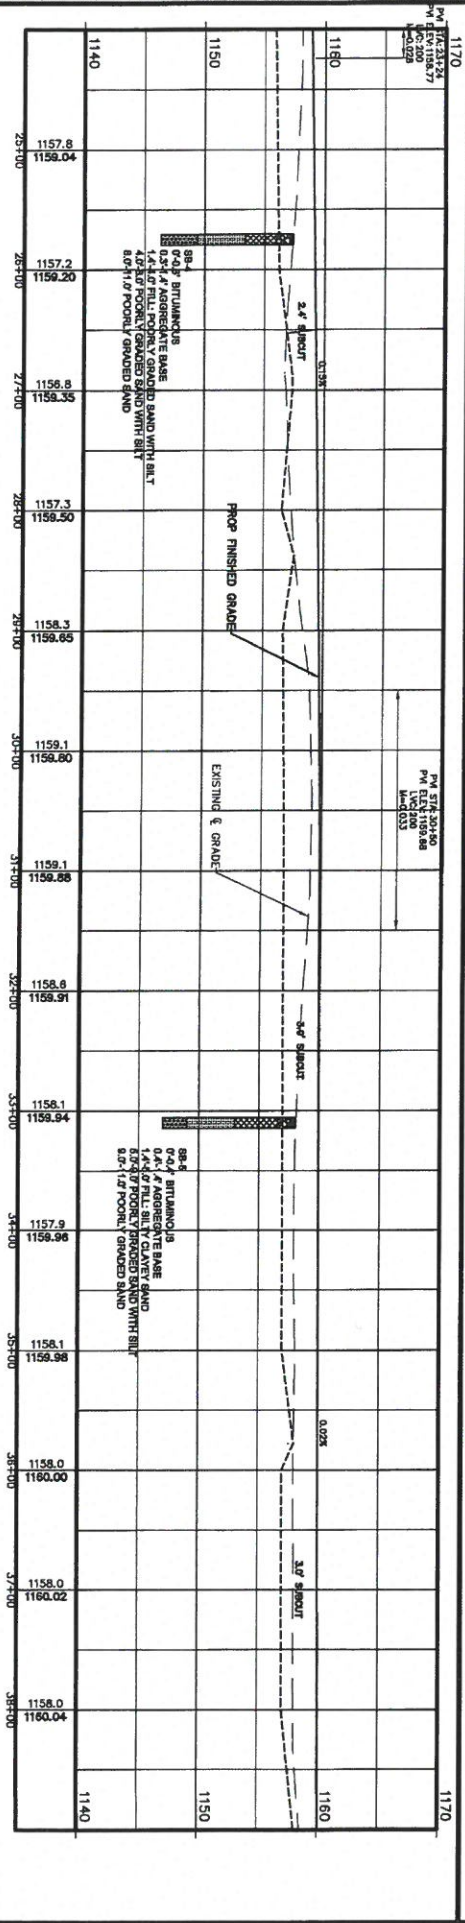



PLAN & PROFILE

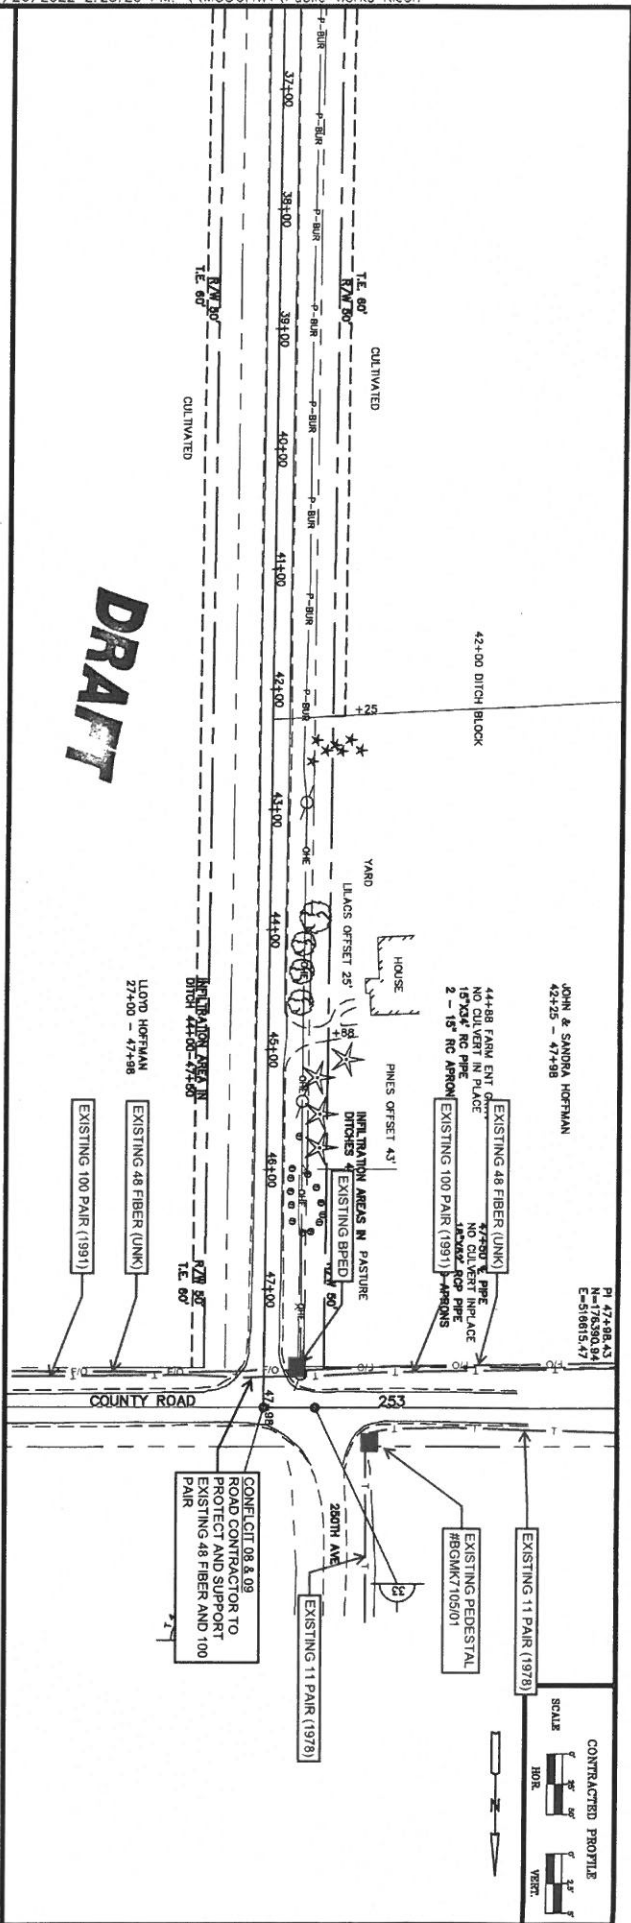

**DRAFT**

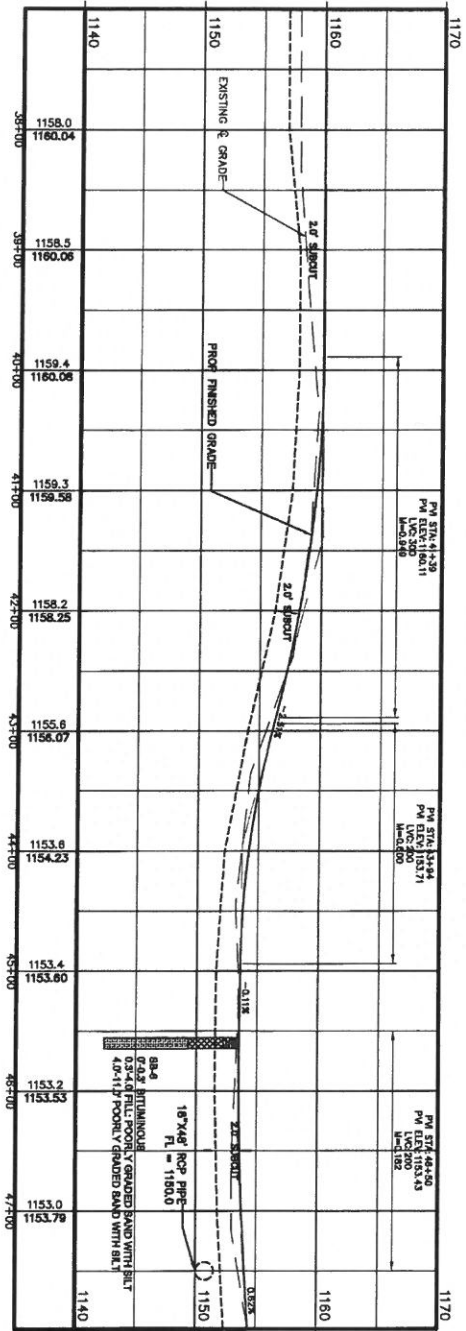

CONTRACTED PROFILE  
 SCALE  
 HOR. 1" = 40'  
 VERT. 1" = 4'

ANTHONY E. HANSEN LIC. NO. 33455 DATE \_\_\_\_\_ COUNTY PROJECT NO. 049-253-003 SHEET NO. 8 OF 20 SHEETS