Station #01:
- Install 80' pole and antenna
- Attach #2 triplex at 27' above ground
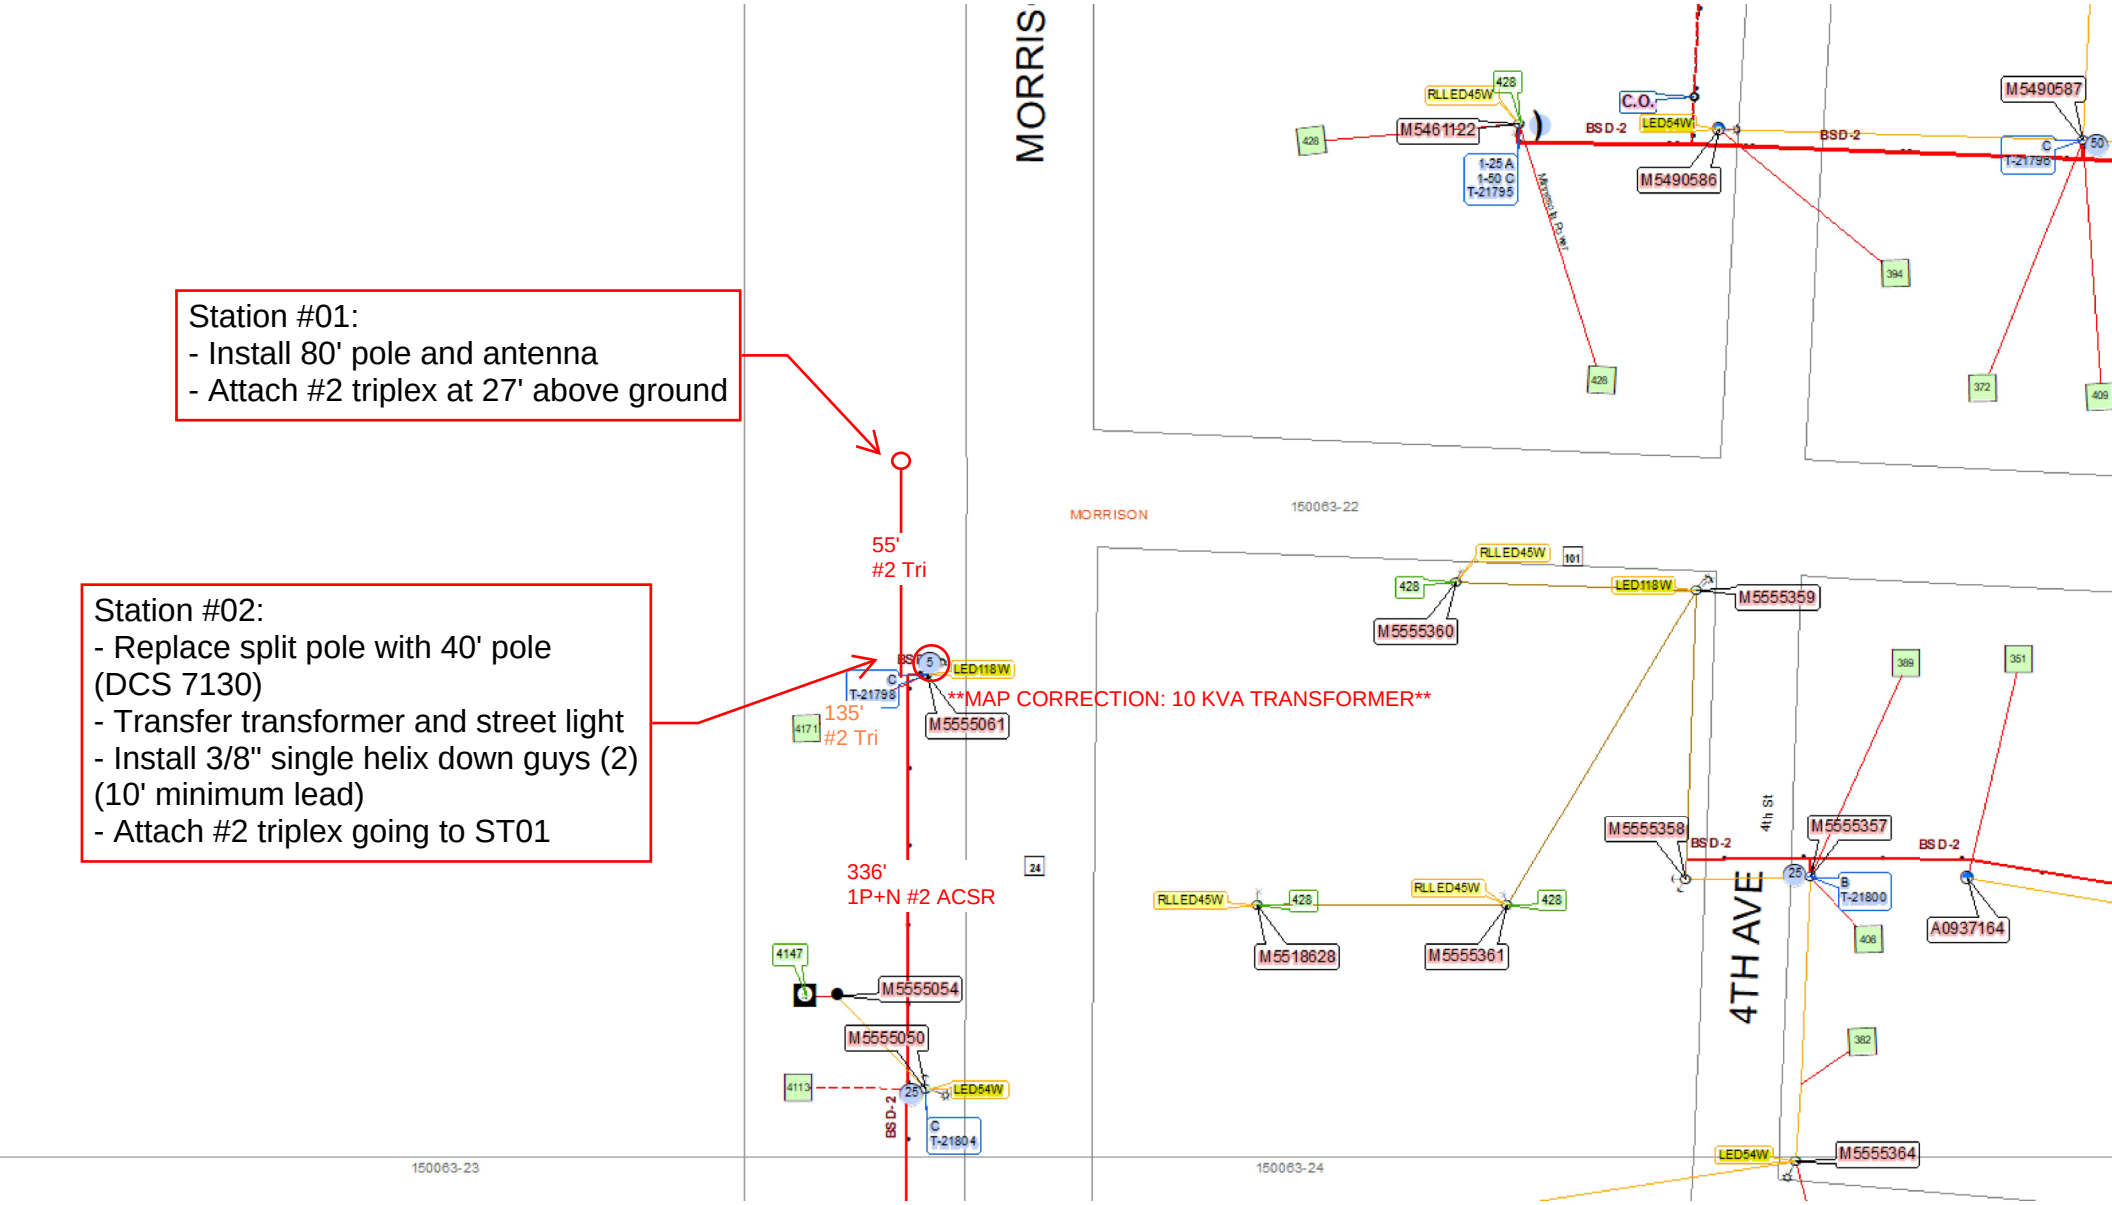
Station #02:
- Replace split pole with 40' pole (DCS 7130)
- Transfer transformer and street light
- Install 3/8" single helix down guys (2) (10' minimum lead)
- Attach #2 triplex going to ST01