


GENERAL LOCATION ONLY. DO NOT USE TO LOCATE FOR EXCAVATION. CALL 1-800-252-1166 FOR ONSITE LOCATIONS AND STAKING.

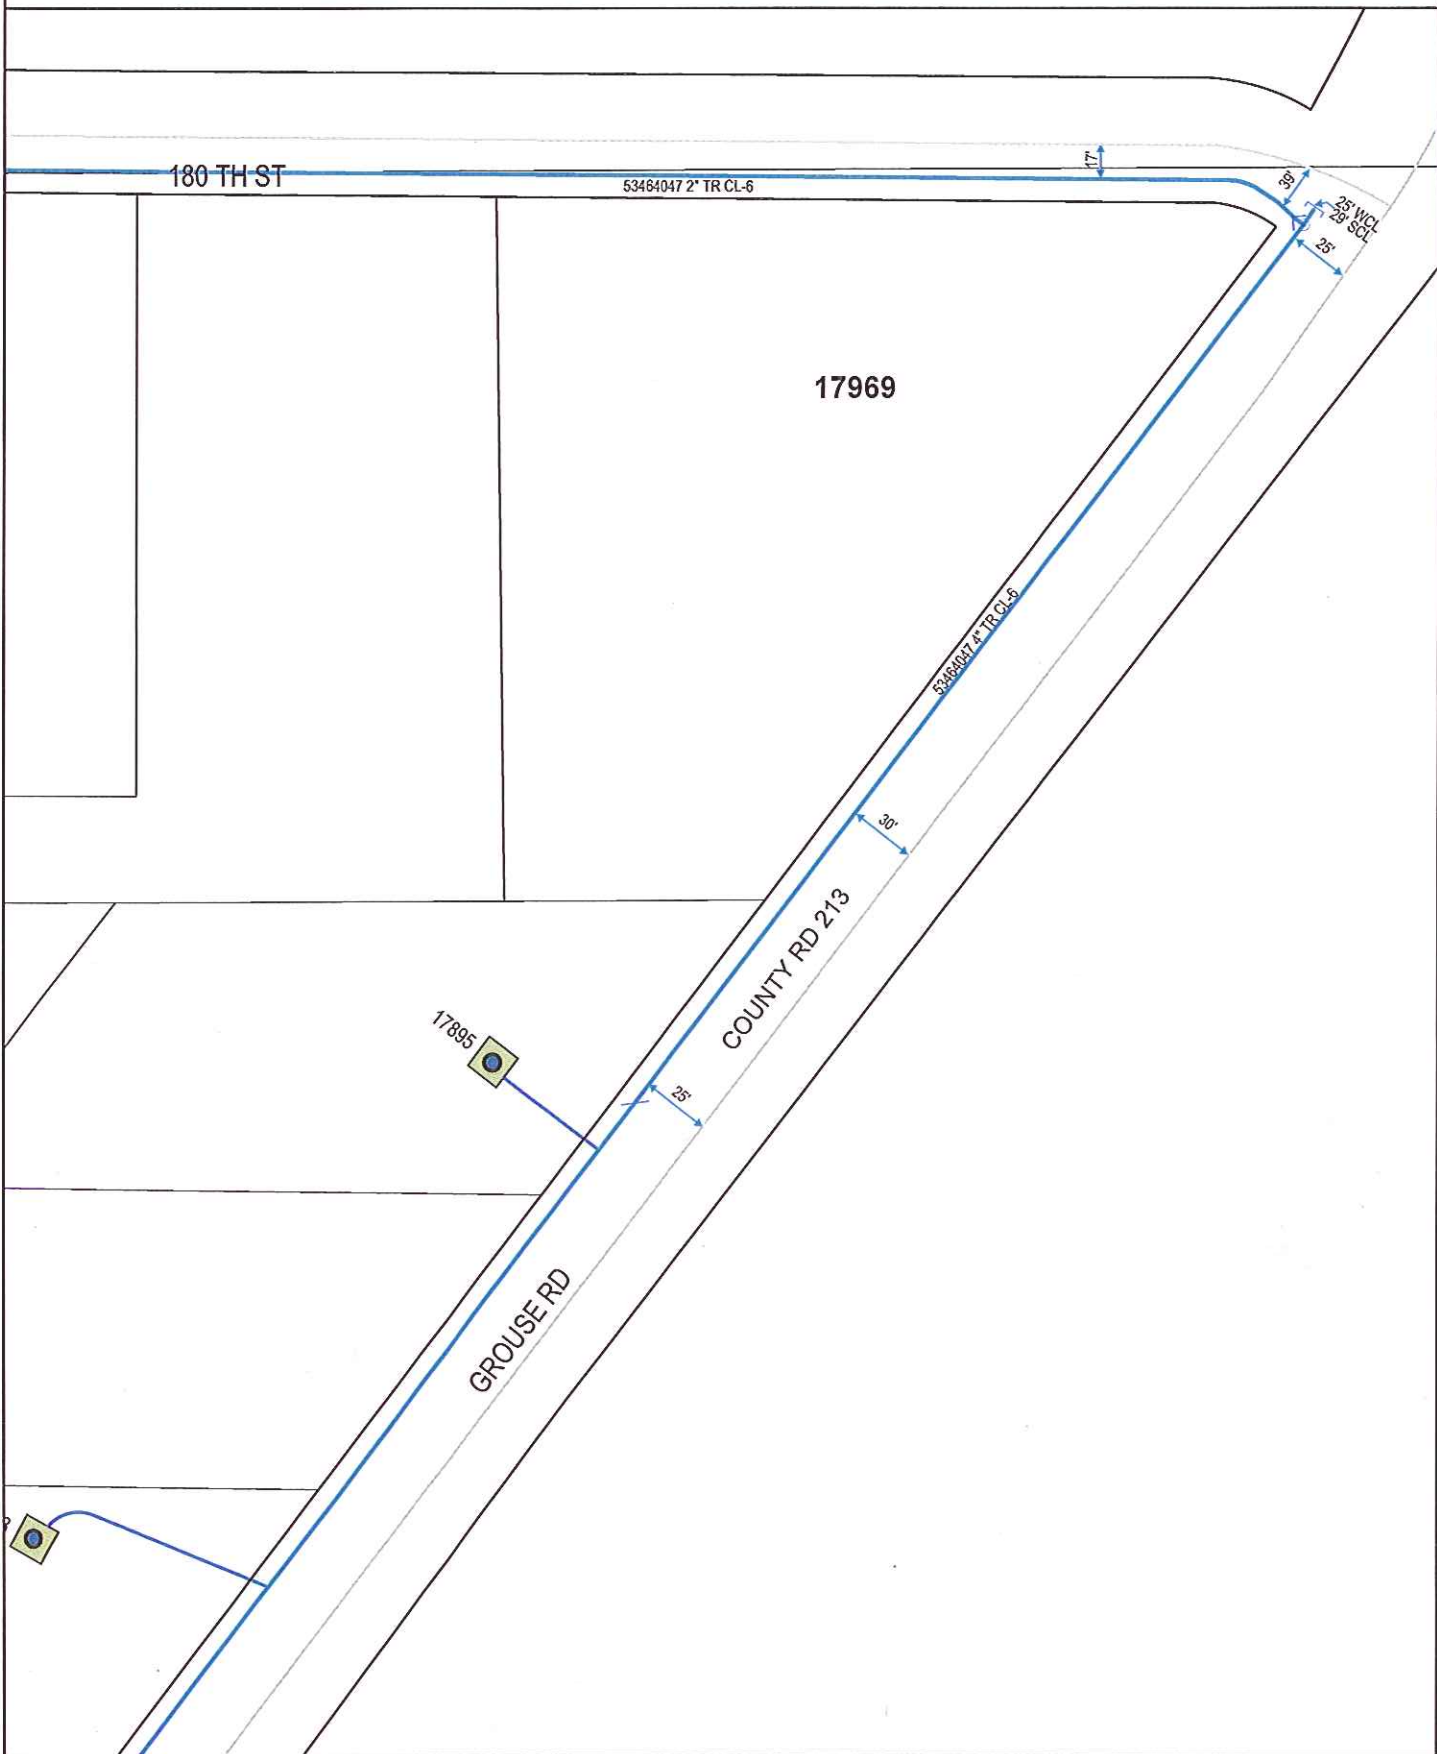

Plotted by: i216608
Plot Date: 5/11/2011

17969 GROUSE RD (COUNTY RD 213)
GREEN PRAIRIE TWP, MN

Scale: 1" : 100'
CenterPoint Energy
North