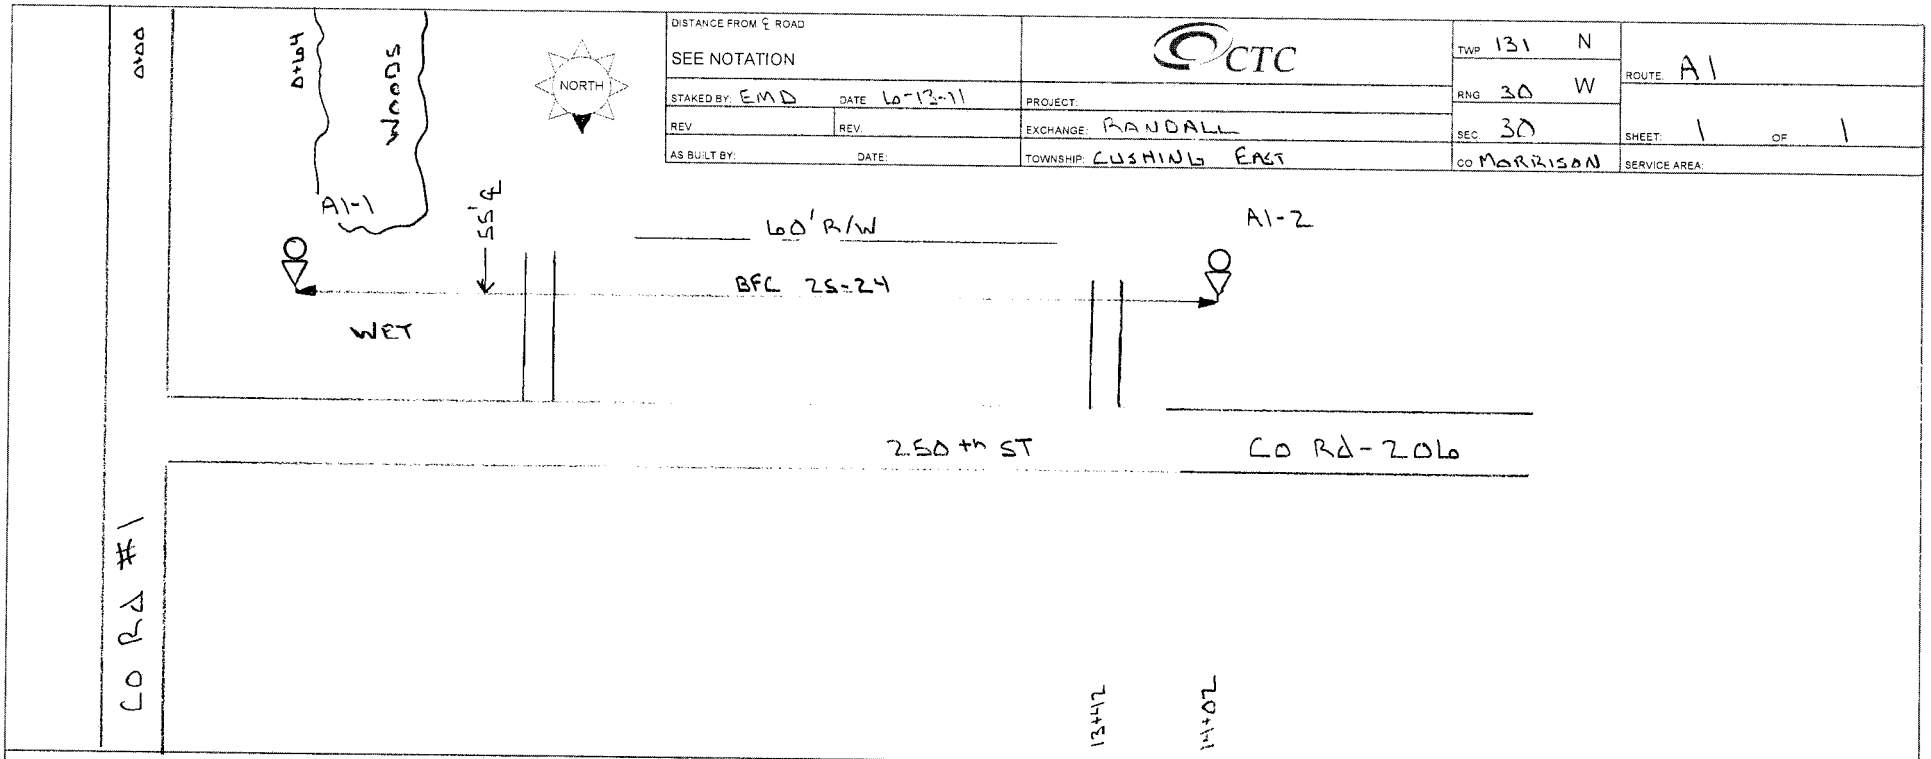

HOUSING NO.	BA	BDO	BFO	BFC	BH	BM	HBF	HO	NID	SUB NO.	SE	UD	UO	W
				25-24										BD
A1-1														1
A1-2				1378										1

CNS