


GENERAL LOCATION ONLY. DO NOT USE TO LOCATE FOR EXCAVATION. CALL 1-800-252-1166 FOR ONSITE LOCATIONS AND STAKING.

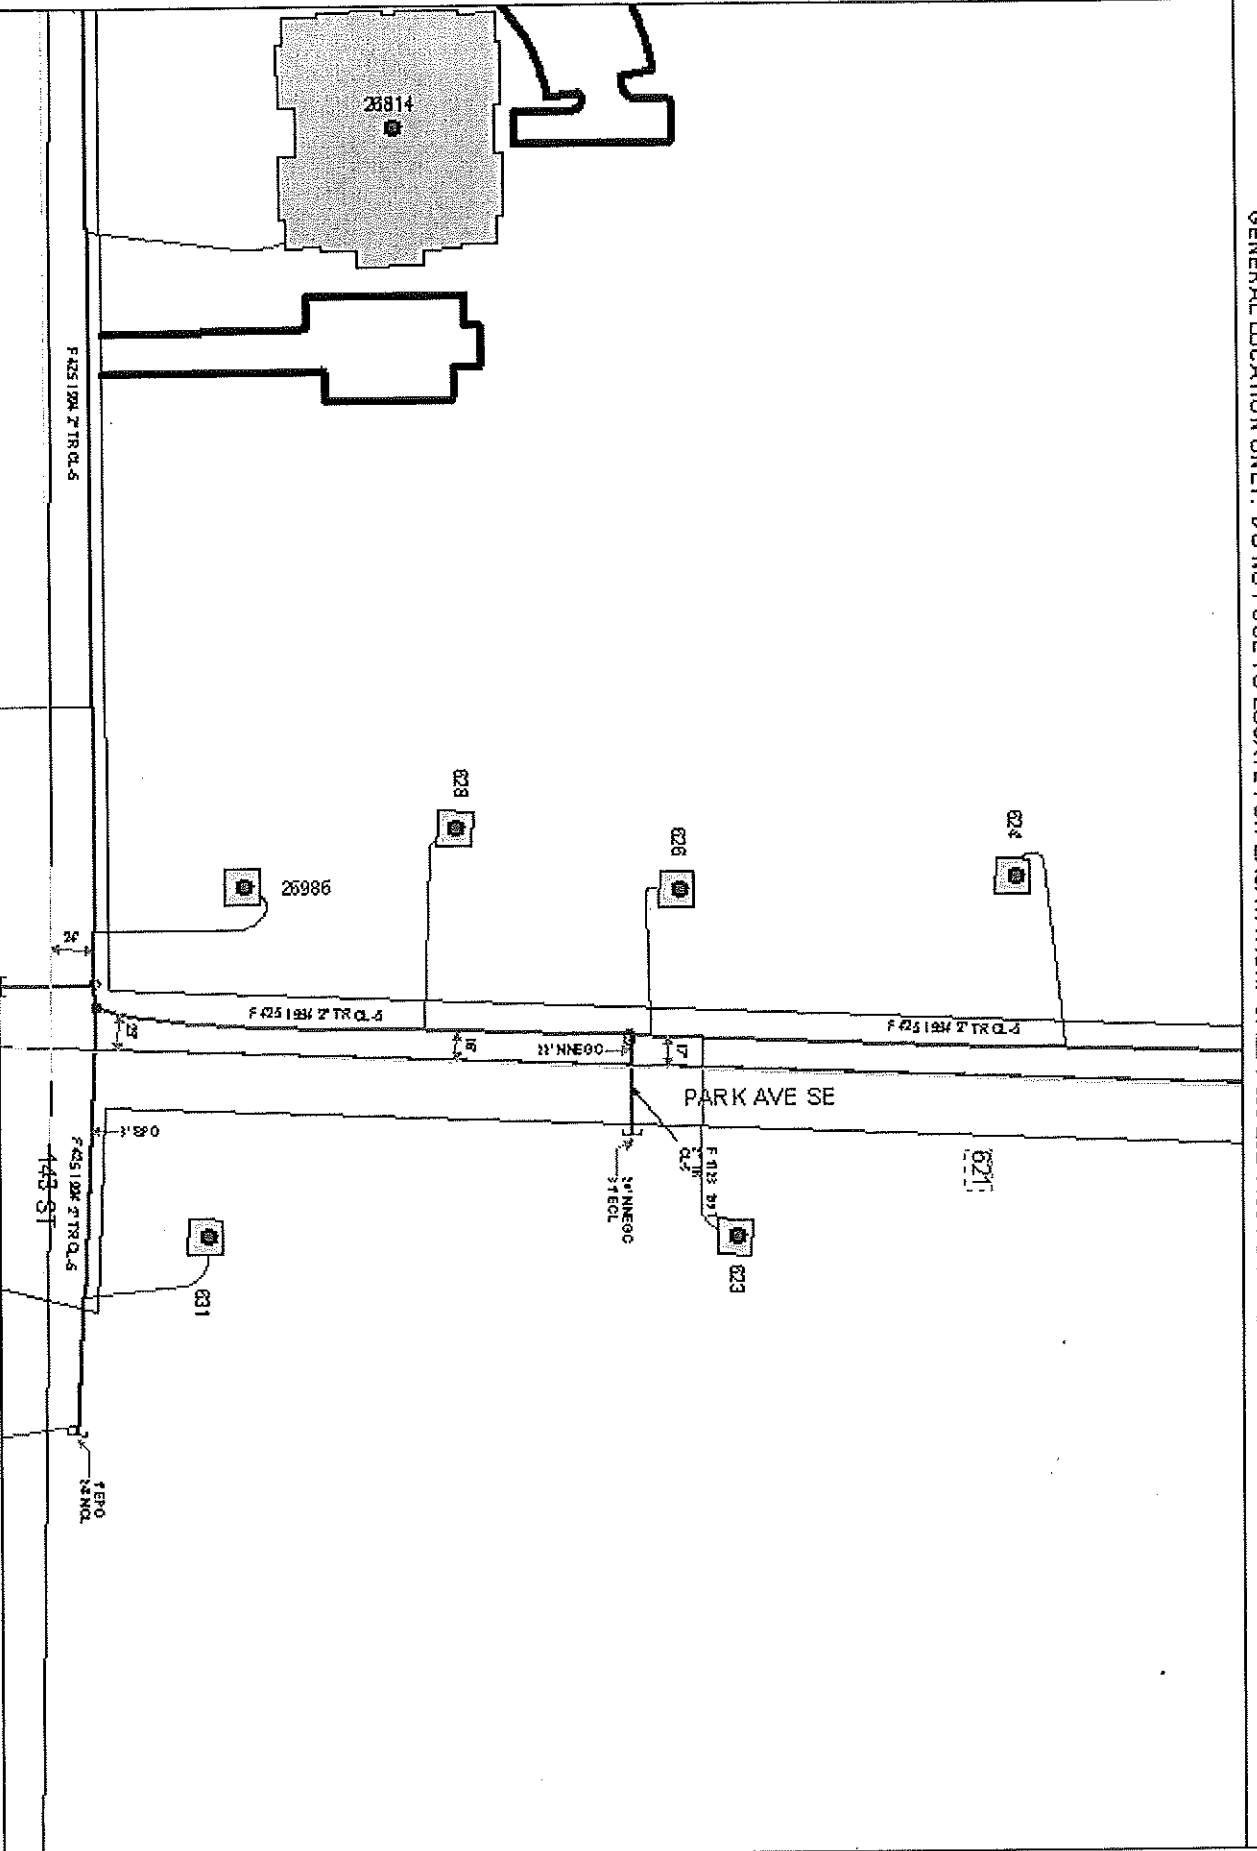

Plotted by: D218191  
Plot Date: 6/20/2011

621 PARK AVE SE  
PIERZ, MN 56364

Scale: 1" = 100'  
CenterPoint Energy  
North