


# TG - Park Rapids to Little Falls\_NPNet Expansion\_2011



### Route Info


- Mile Marker
- Splice
- HH Storage Loop
- PED Storage Loop
- Direct
- 1.25 "
- 2 "
- 1.25 " & 2 "
- Tri-Duct
- Aerial

### Field Notes

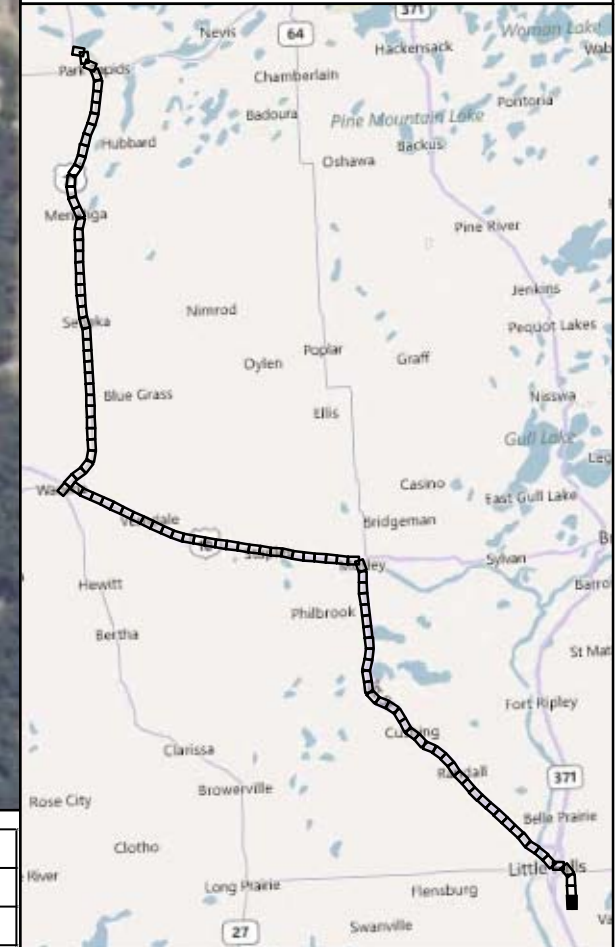

**109**

US Cable Splice Point 1

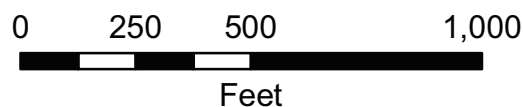

| Revision Date | Revised By |
|---------------|------------|
|               |            |

| Drawn Date | Drawn By |
|------------|----------|
|            |          |