

Staking Sheet -Overhead

74-000-05-01500

Const:

Ret:


Both:

Page: 2 of 2

W/O#:

249987

WP#:

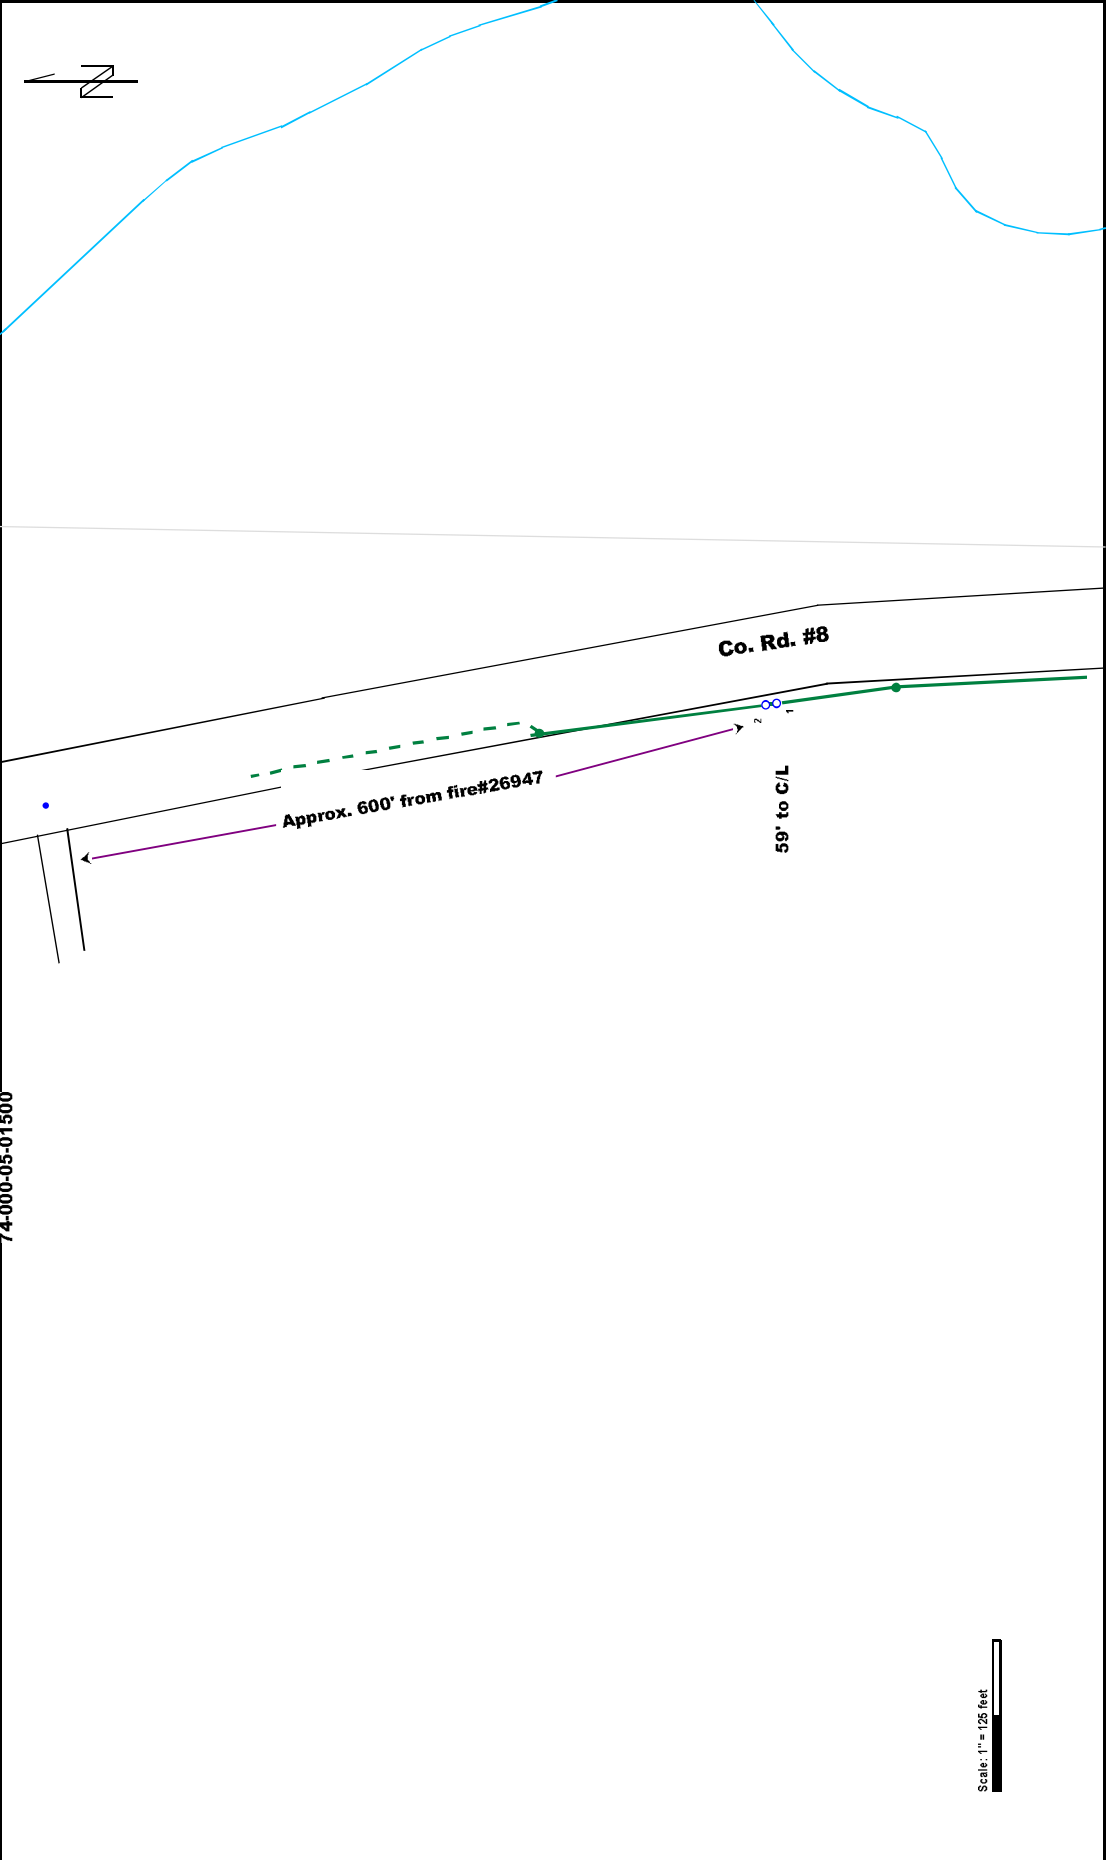

Scale: 1" = 125 feet