

NO NAME ST

Project: E.301746
 WC NAME: SWANVILLE
 WC ID: SWVLMSV
 Design Eng: Ben Buchholz
 Telephone: 3202558533
 Issue:
 Issue Date:
 Plat Ref:

CONFIDENTIAL Disclose and Distribute
 Solely To CenturyLink Employees Having
 a Need to Know.
 Reason for Reissue:

Scale: 1" = 74'
 Sheet: 016 of 1

Project: E:301746
WC NAME: SWANVILLE
WC ID: SWMLNSV


Design Eng: Ben Buchholz
Telephone: 3202558533


Issue:
Issue Date:

Plat Ref.:

CONFIDENTIAL. Disclose and Distribute
Solely To CenturyLink Employees Having
a Need to Know.

Reason for Reissue:

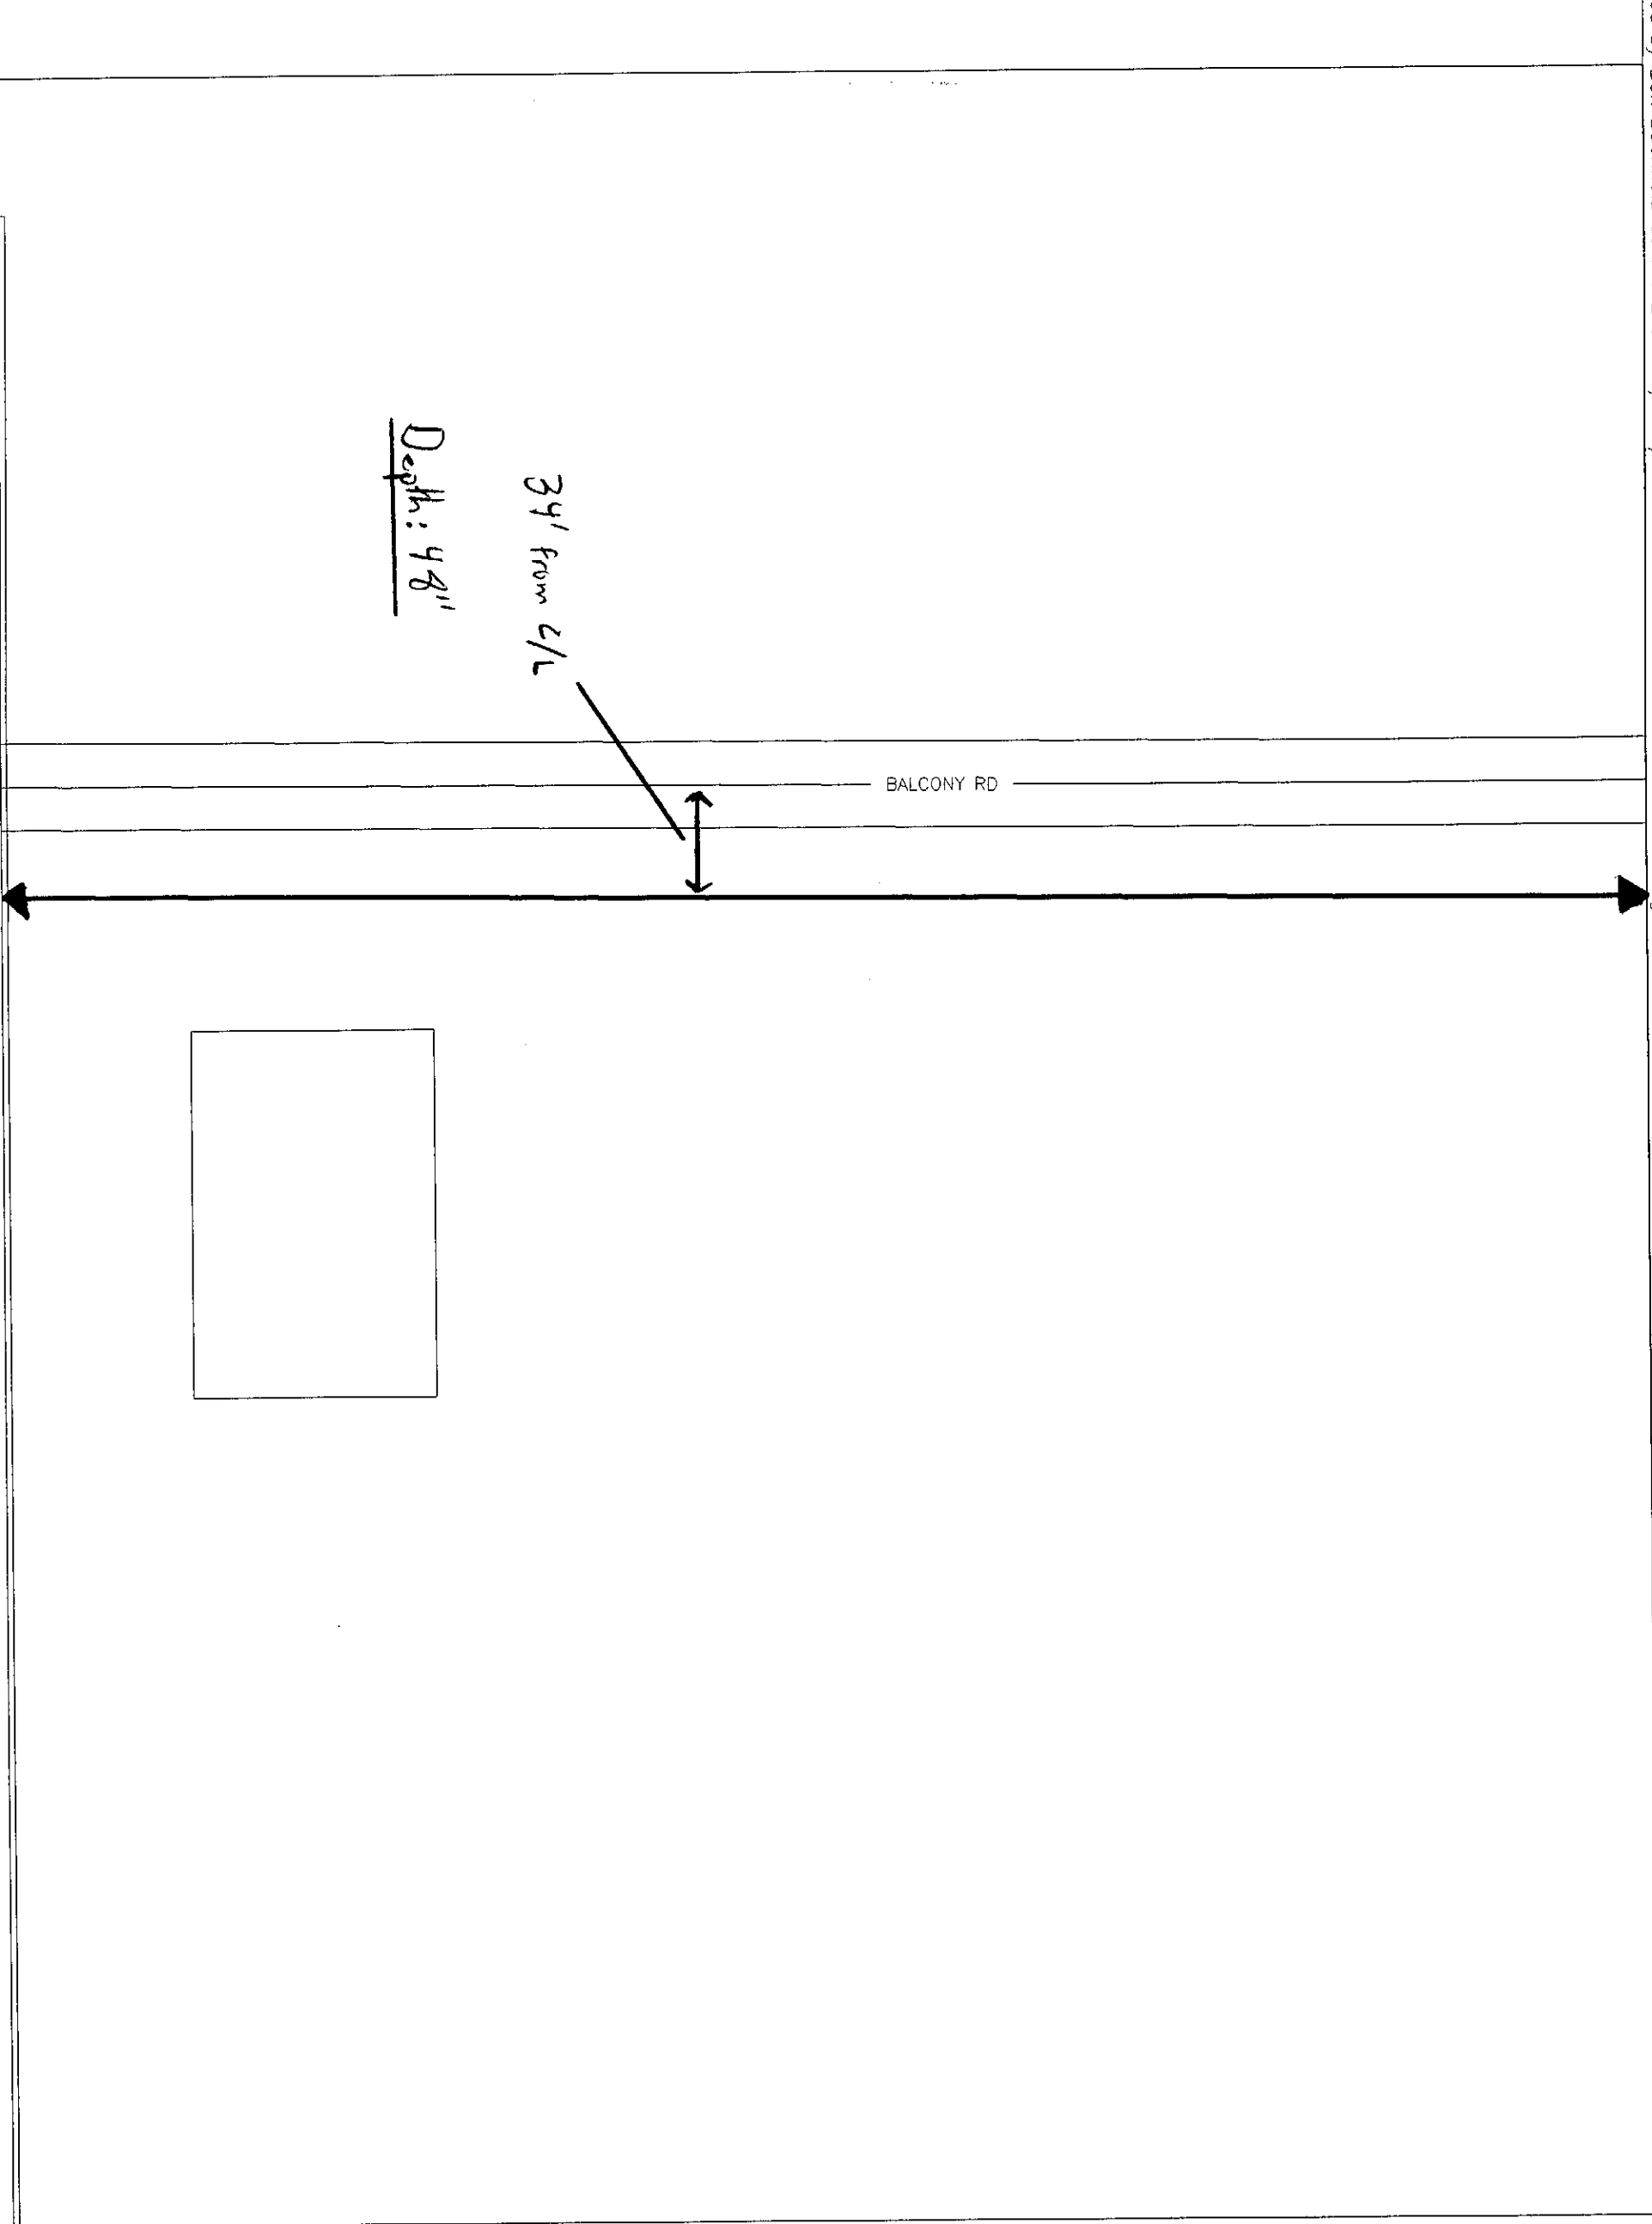


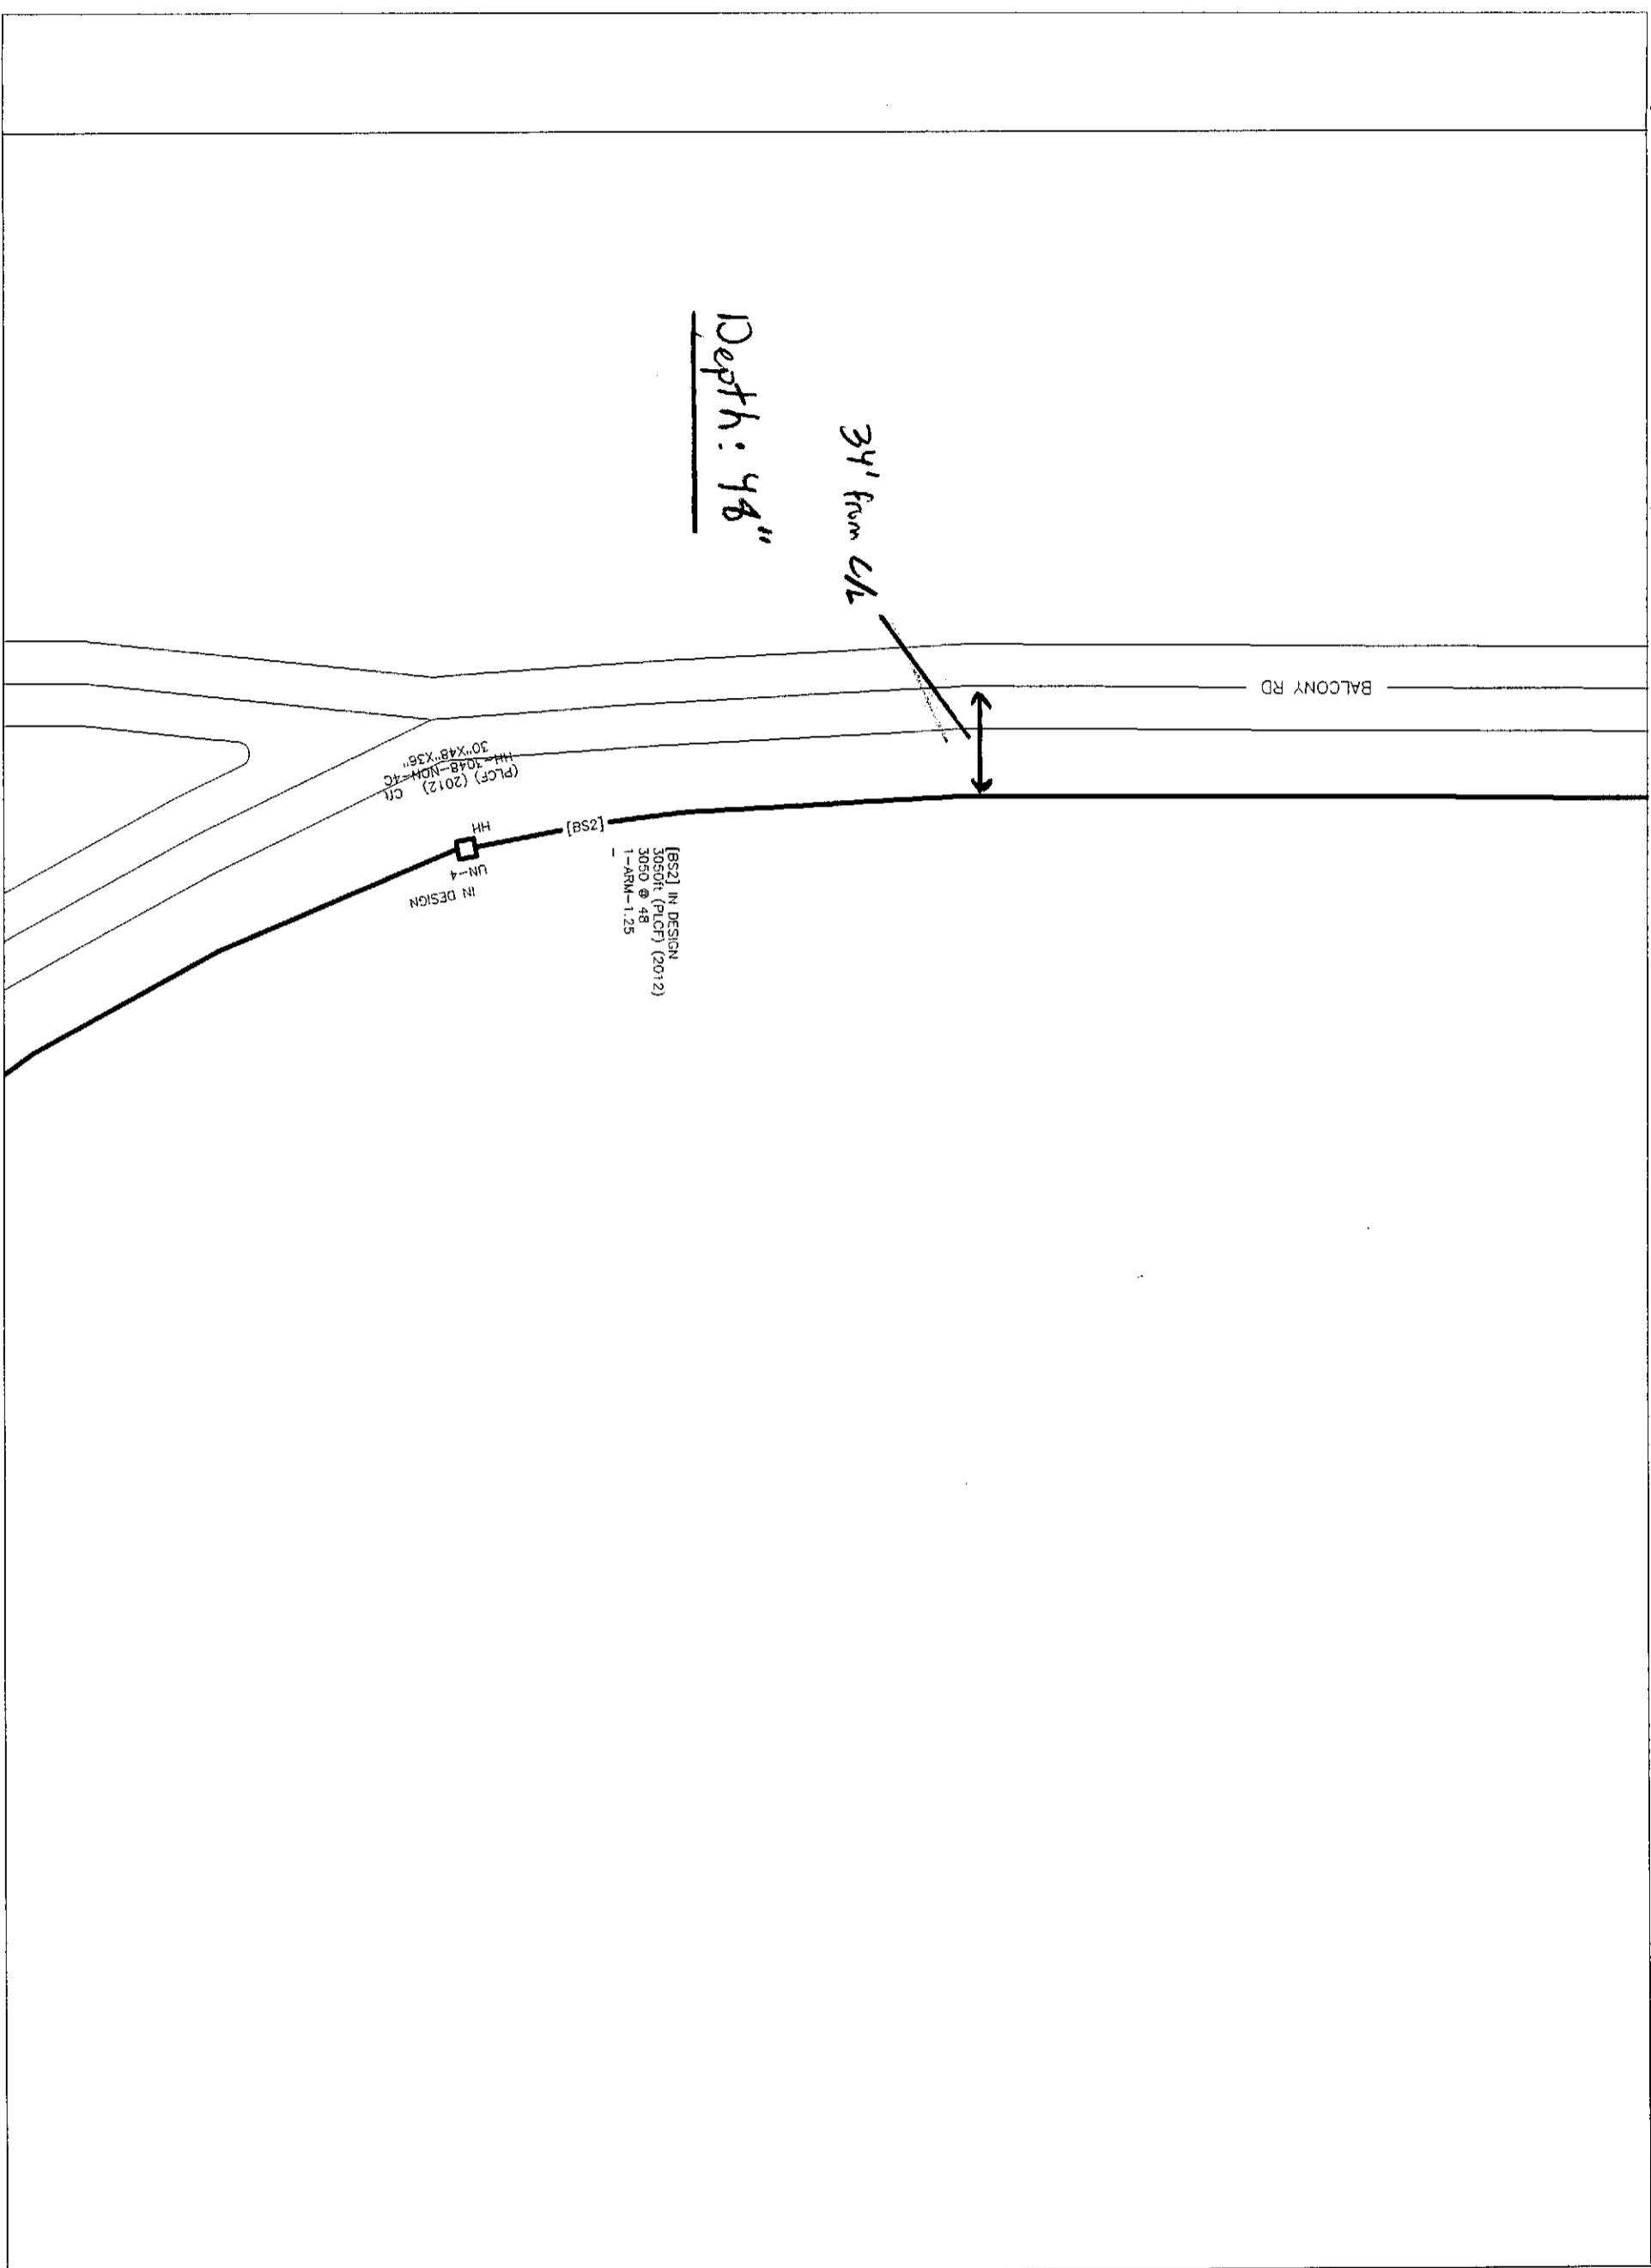

Project: E.301746
 WC NAME: SWANNILLE
 WC ID: SWYLANSV
 Design Eng: Ben Buchholz
 Telephone: 3202558533
 Issue:
 Issue Date:
 Plat Ref:


CONFIDENTIAL Disclose and Distribute
 Solely To CenturyLink Employees Having
 a Need to Know.
 Reason for Reissue:

Scale: 1" = 75'
 Sheet: 018 of 1

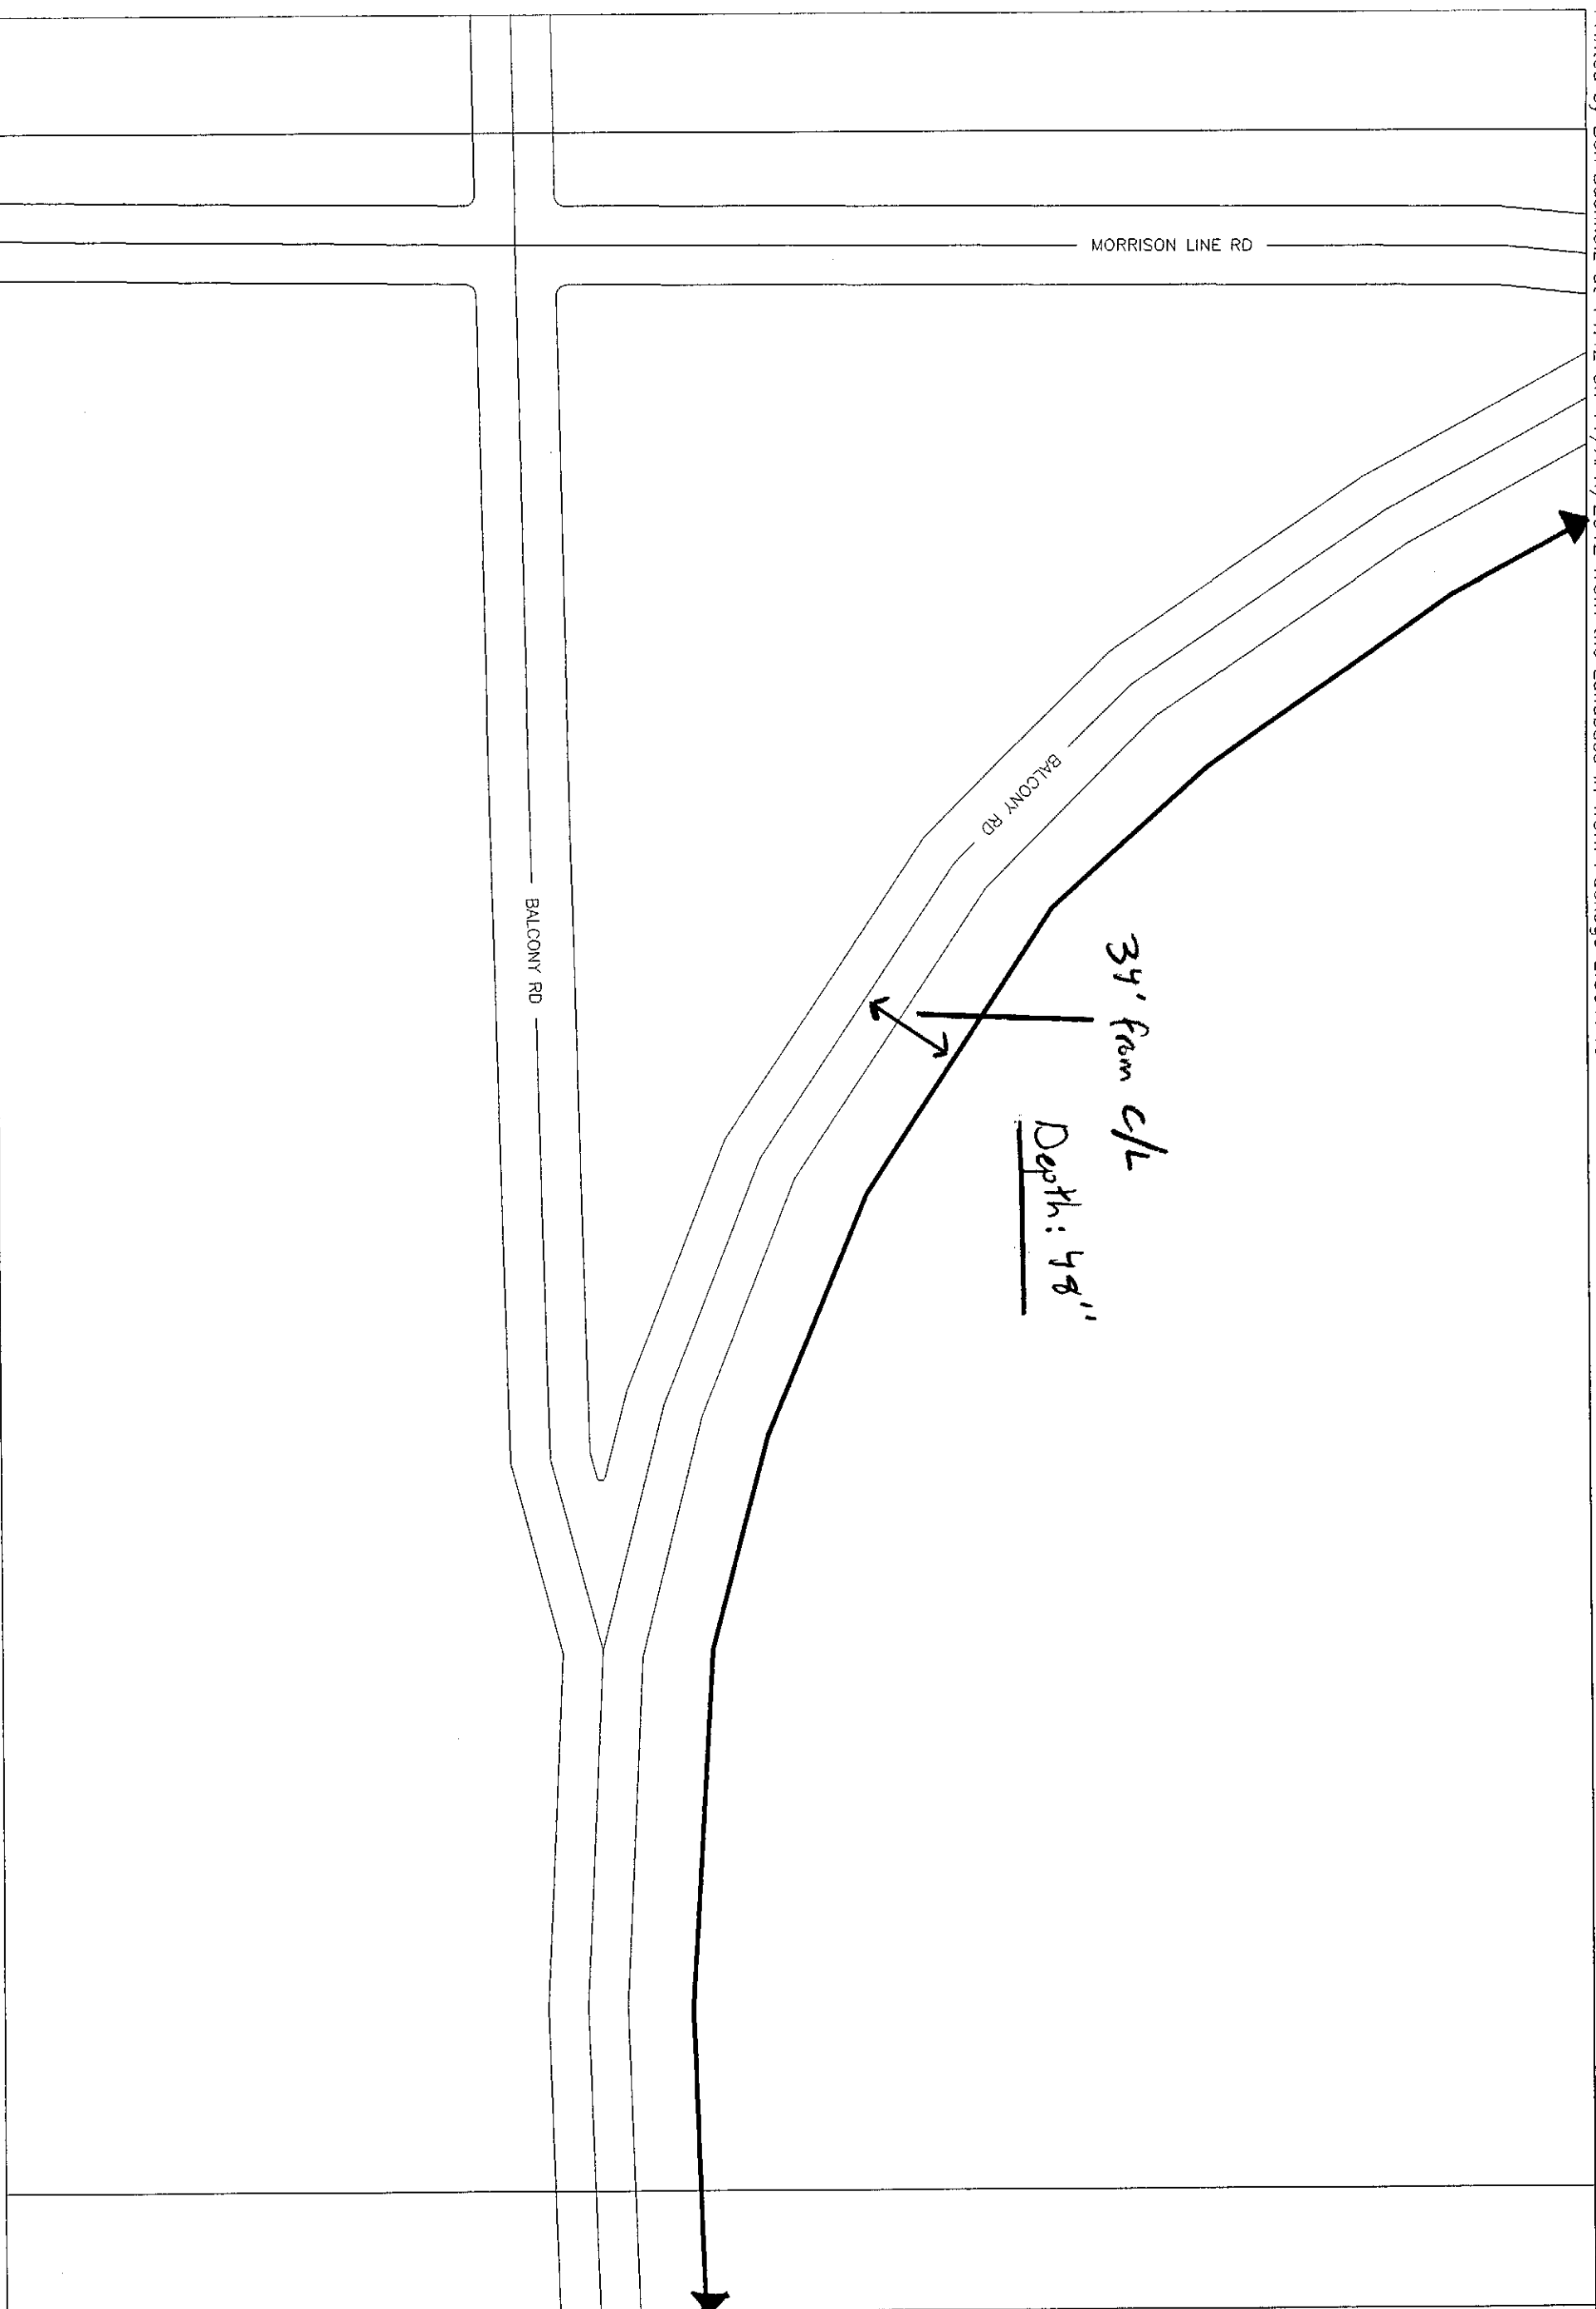

Project: E:301746
WC NAME: SWANVILLE
WC ID: SWYLMNSV
Design Eng: Ben Buchholz
Telephone: 3202558533
Issue:
Issue Date:
Plat Ref:

CONFIDENTIAL. Disclose and Distribute
Solely To CenturyLink Employees Having
a Need to Know.
Reason for Reissue:

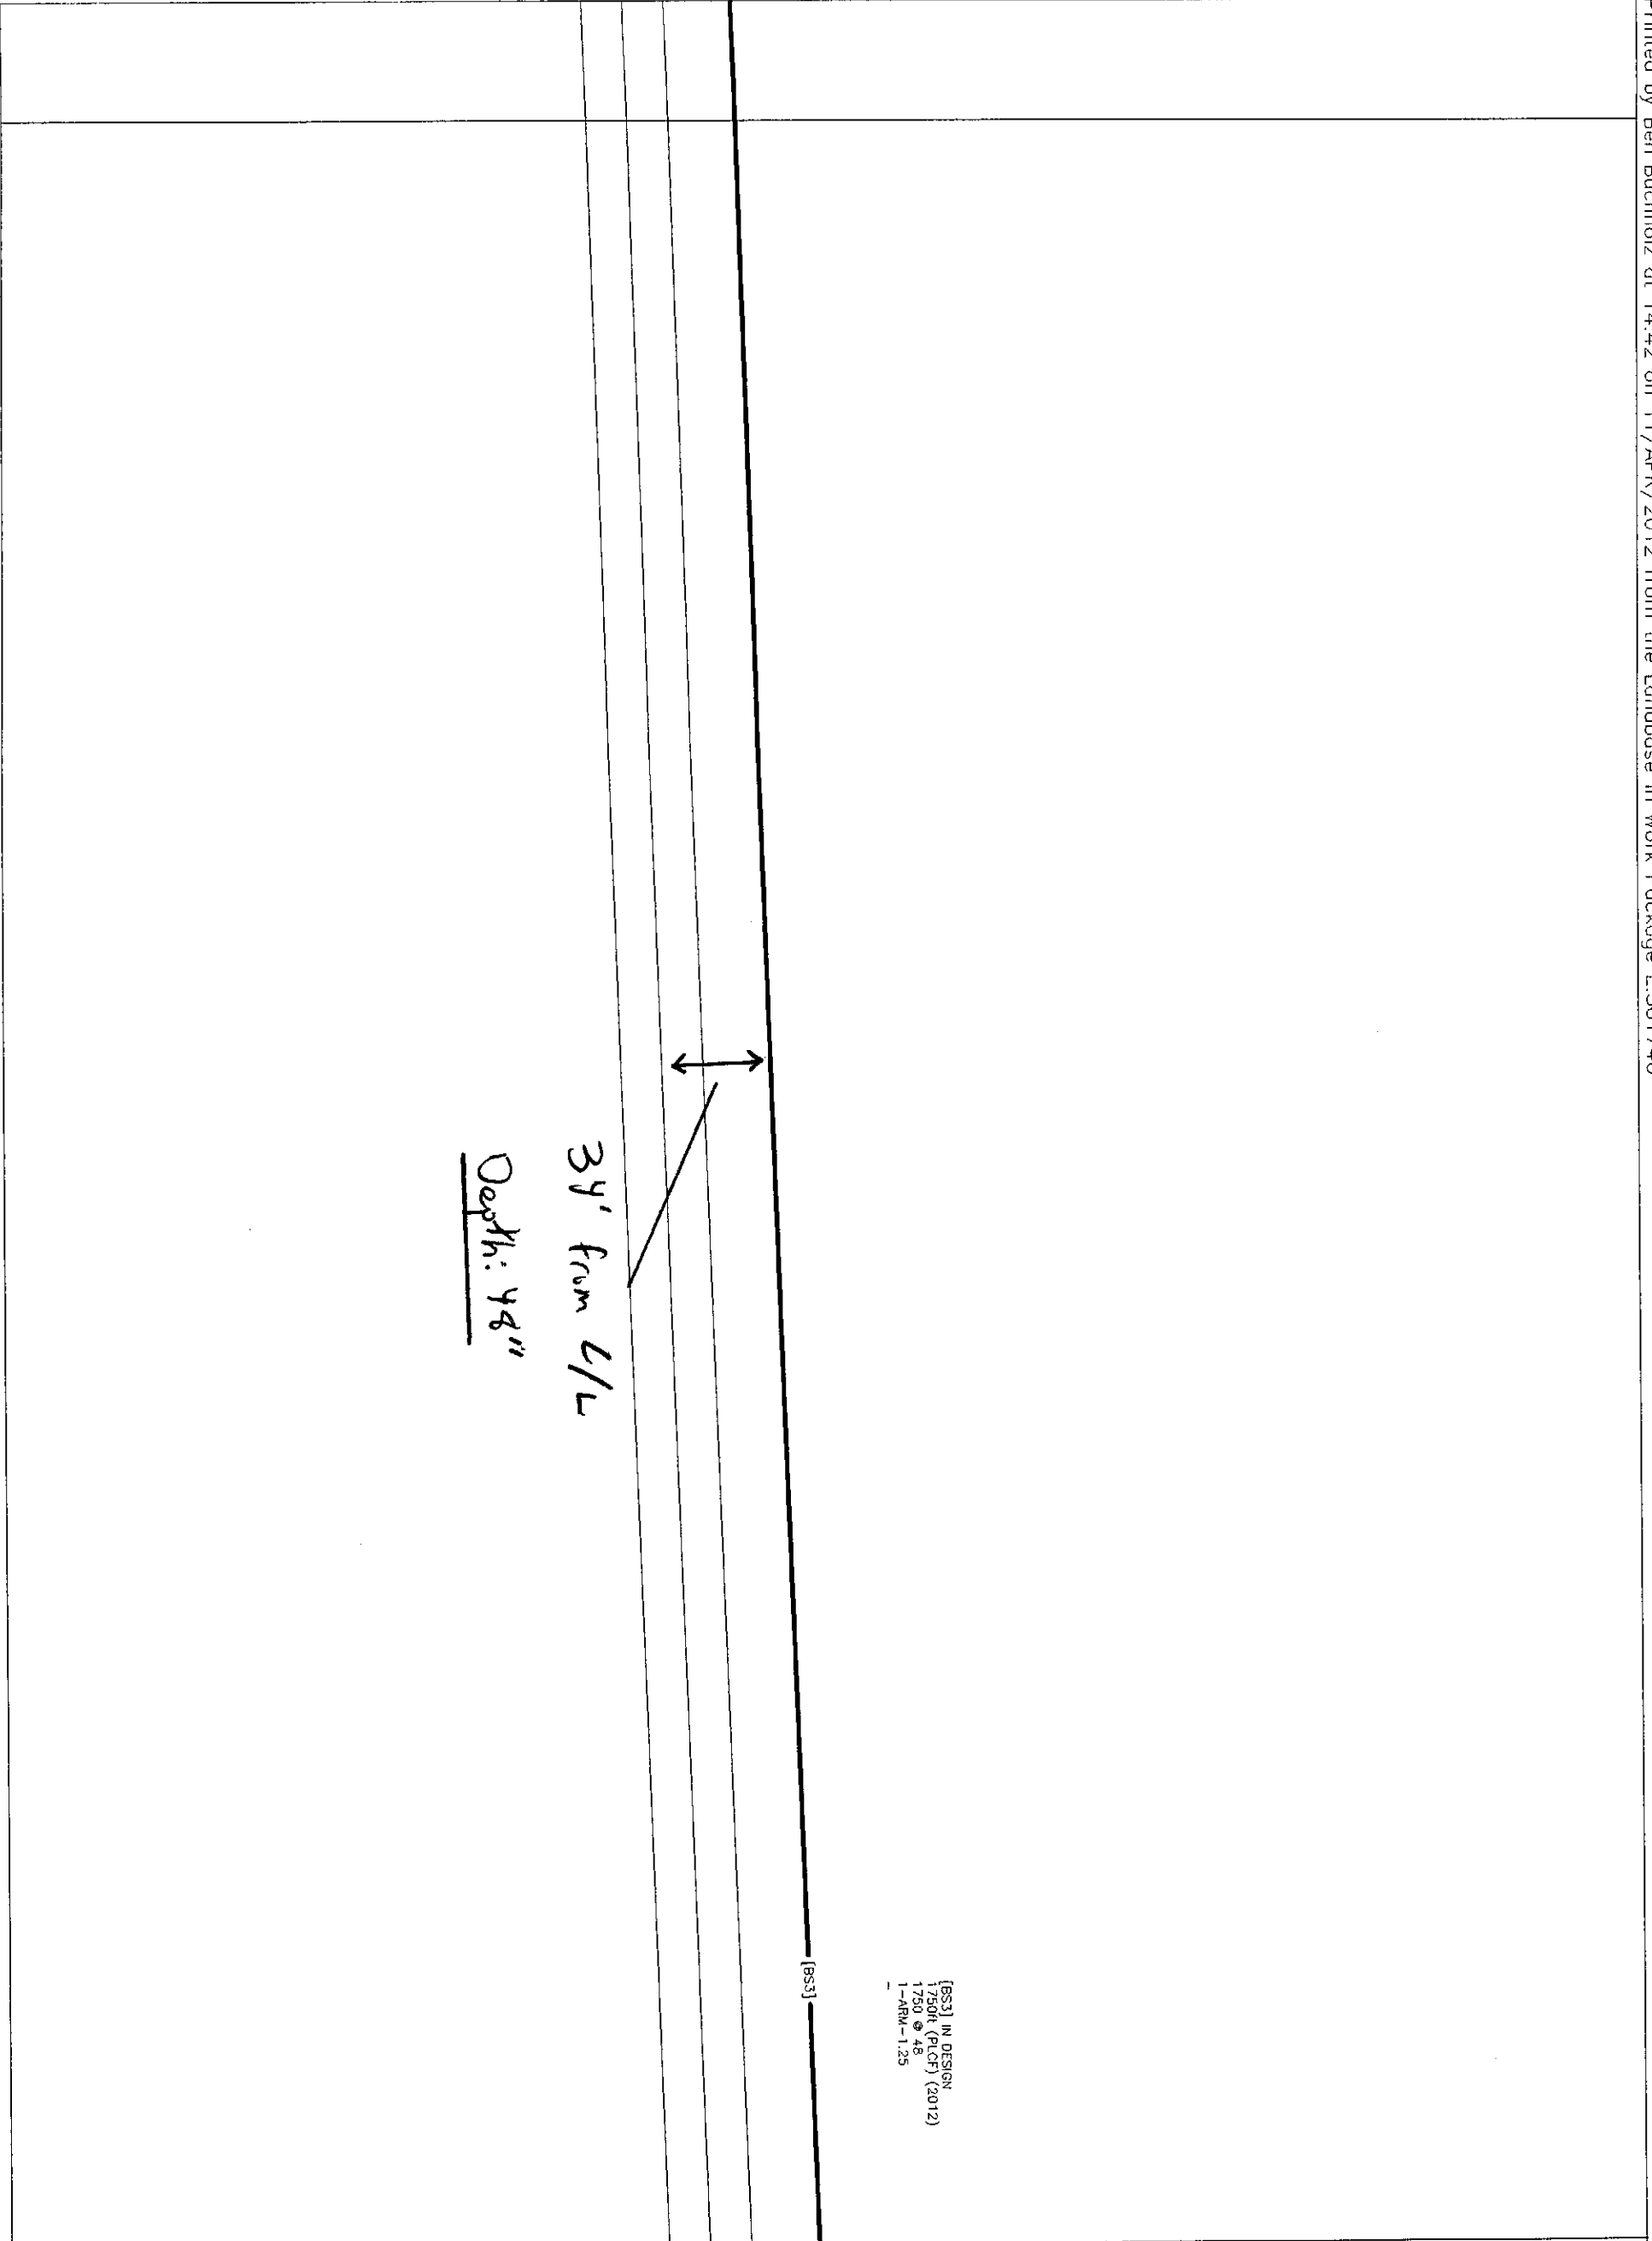


[BS3] IN DESIGN
1750H (PUCF) (2012)
1750H @ 48
1-ARM-1.25

[BS3]

Project: E.301746
WC NAME: SWANVILLE
WC ID: SWMLNSV
Design Eng: Ben Buchholz
Telephone: 3202558533
Issue:
Issue Date:
Plot Ref:

CONFIDENTIAL Disclose and Distribute
Solely To CenturyLink Employees Having
a Need to Know.
Reason for Reissue:

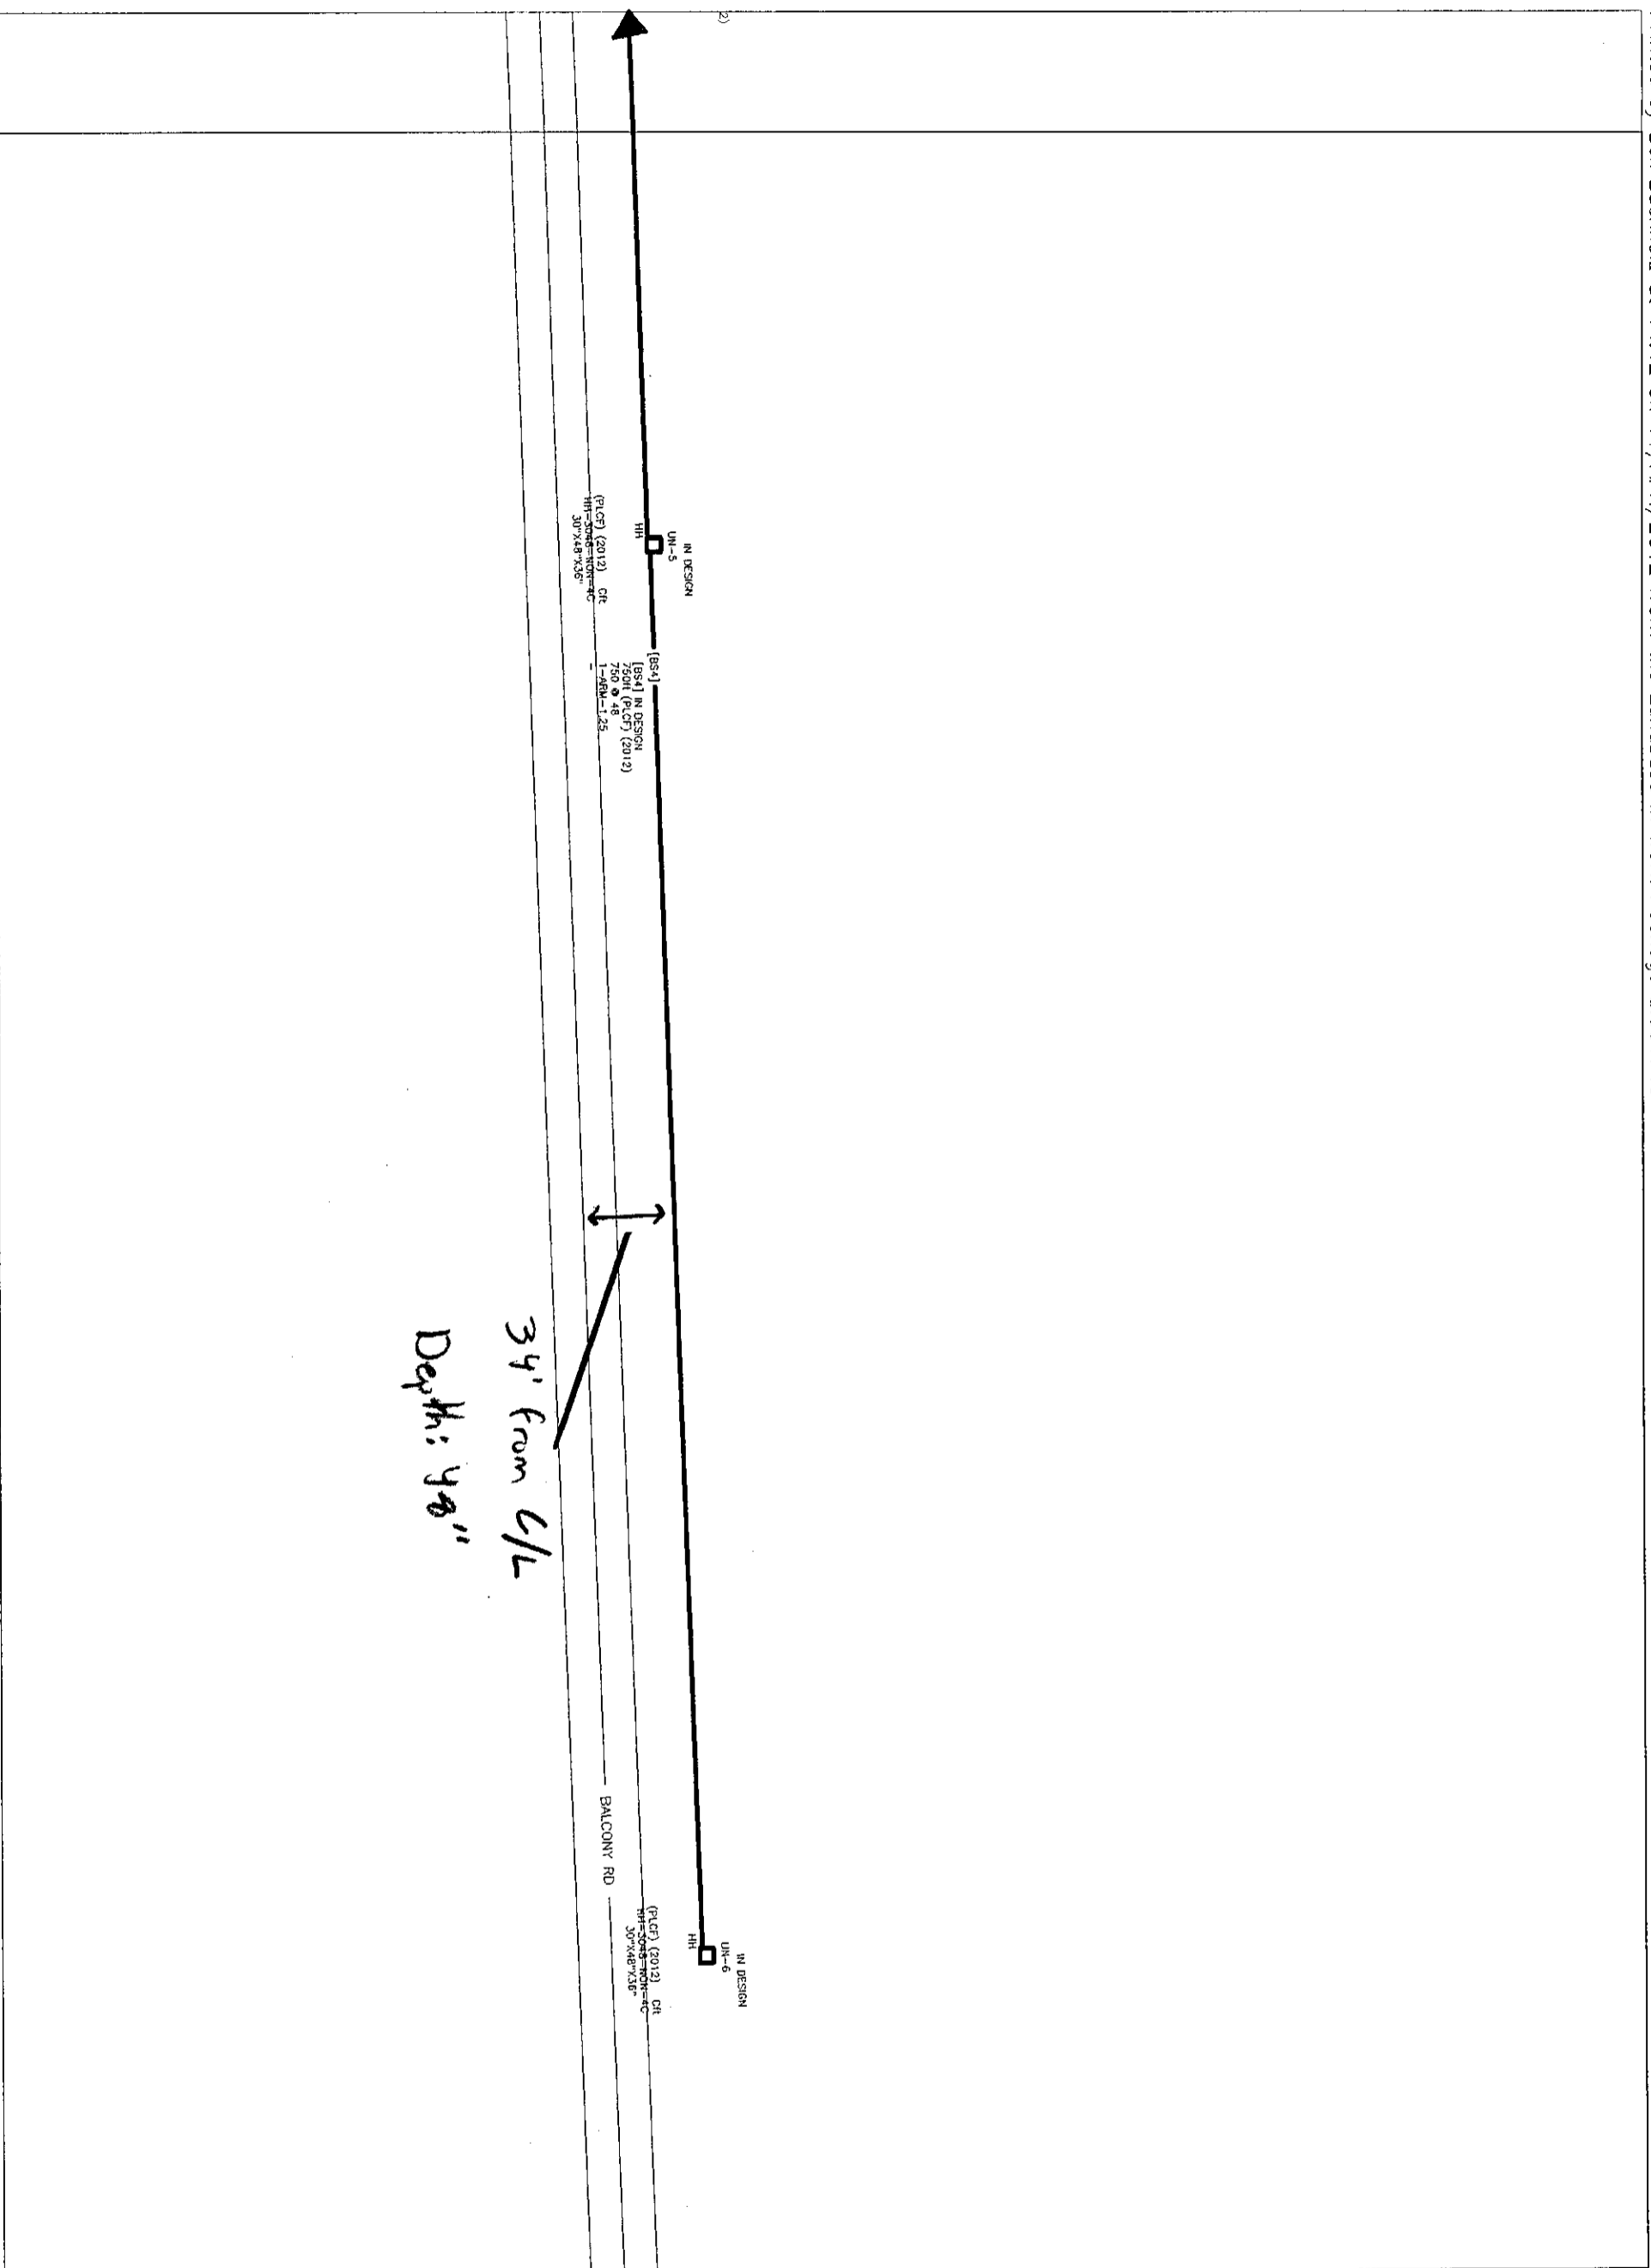

Project: E.301746

WC NAME: SWANVILLE

WC ID: SW/MLNSV

Design Eng: Ben Buchholz

Telephone: 3202558533

Issue:

Issue Date:

Plot Ref.:

CONFIDENTIAL Disclose and Distribute
Solely To CenturyLink Employees Having
a Need to Know.

Reason for Reissue: