
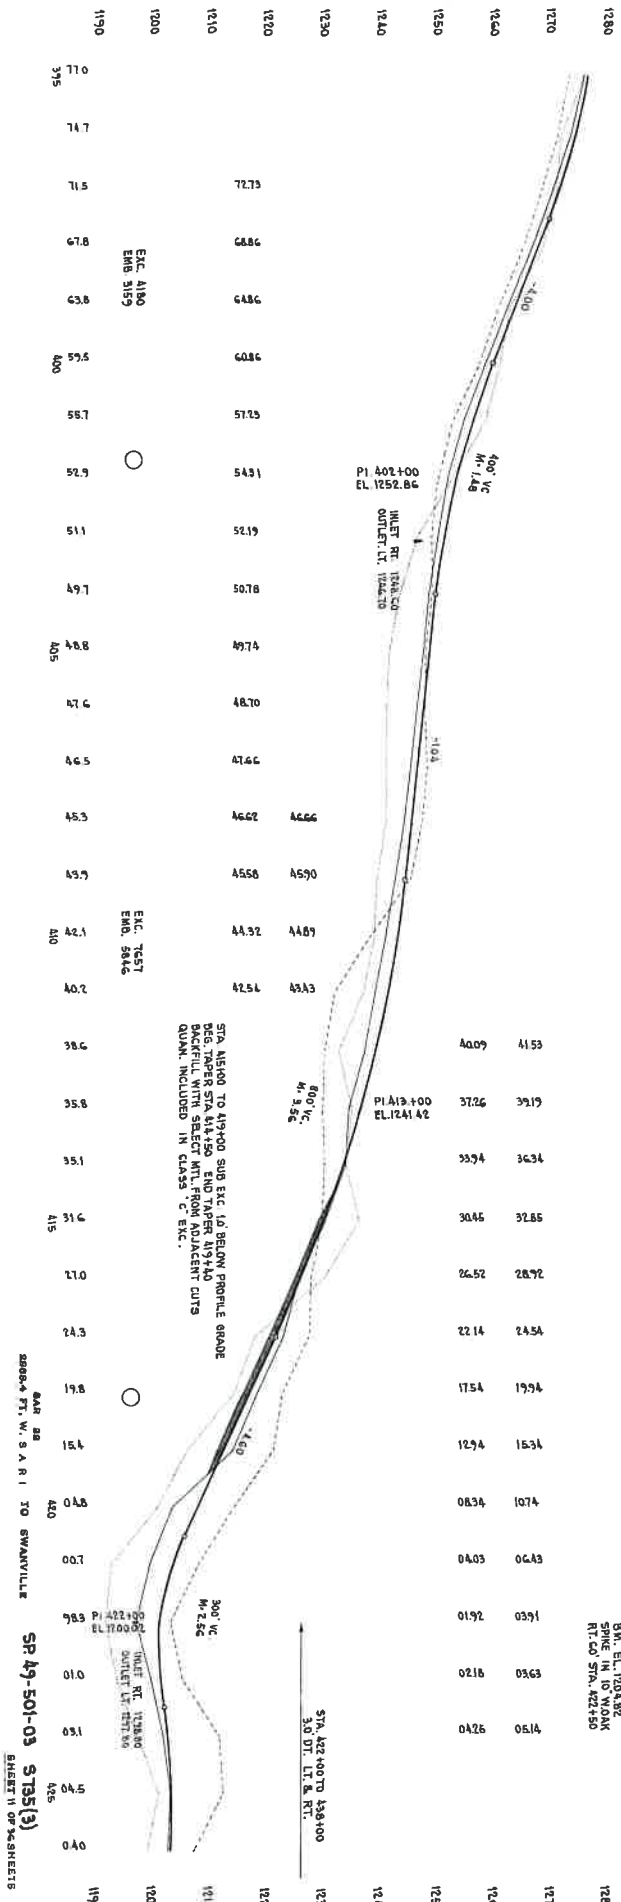


CR 15

30' off of township line
 5' off of centerline of road
 CR 15

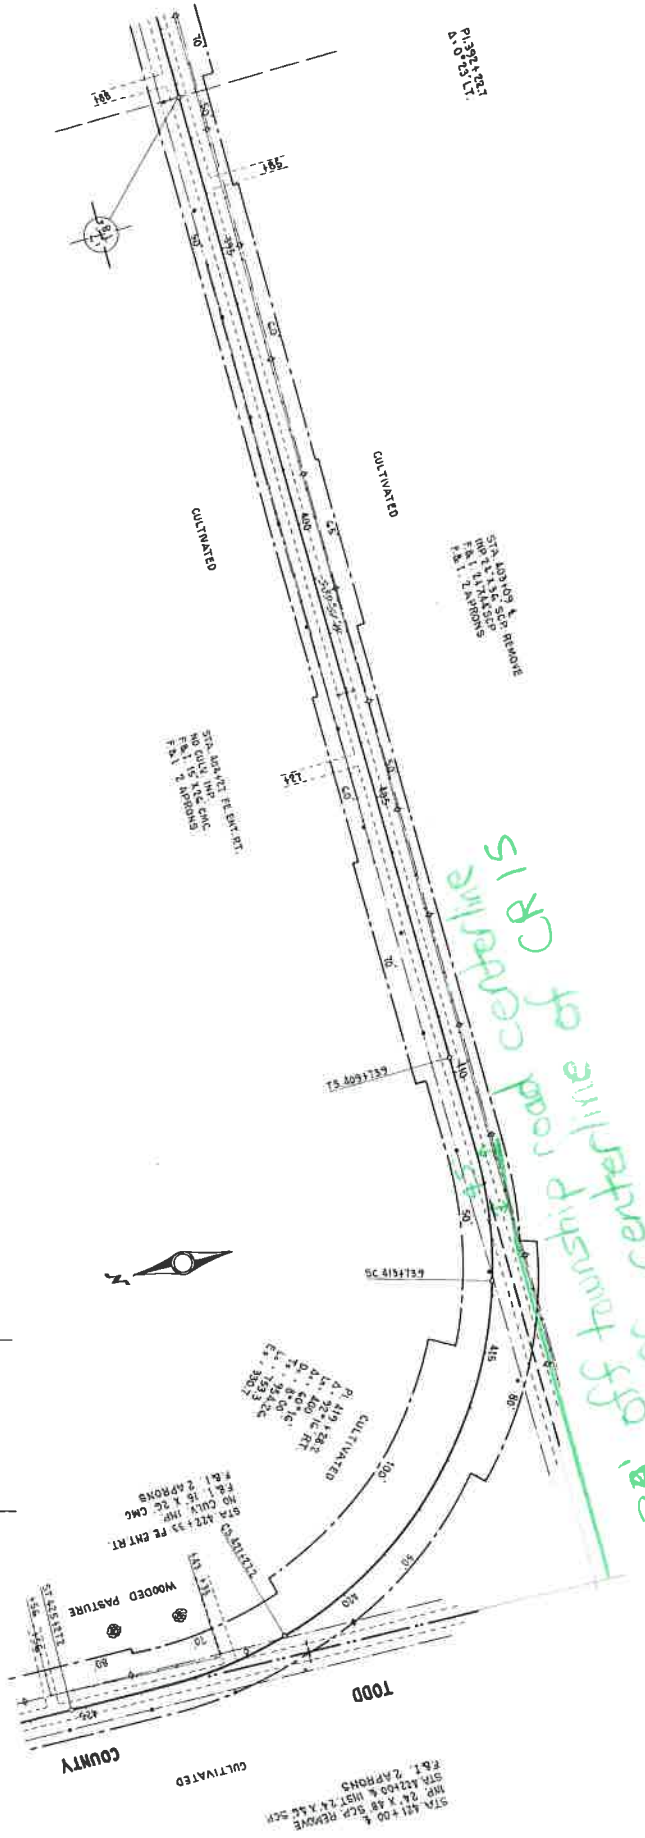

SR A9-501-03 ST35(3)
 SHEET 11 OF 35 SHEETS