GENERAL LOCATION ONLY. DO NOT USE TO LOCATE FOR EXCAVATION. CALL 1-800-252-1166 FOR ONSITE LOCATIONS AND STAKING.

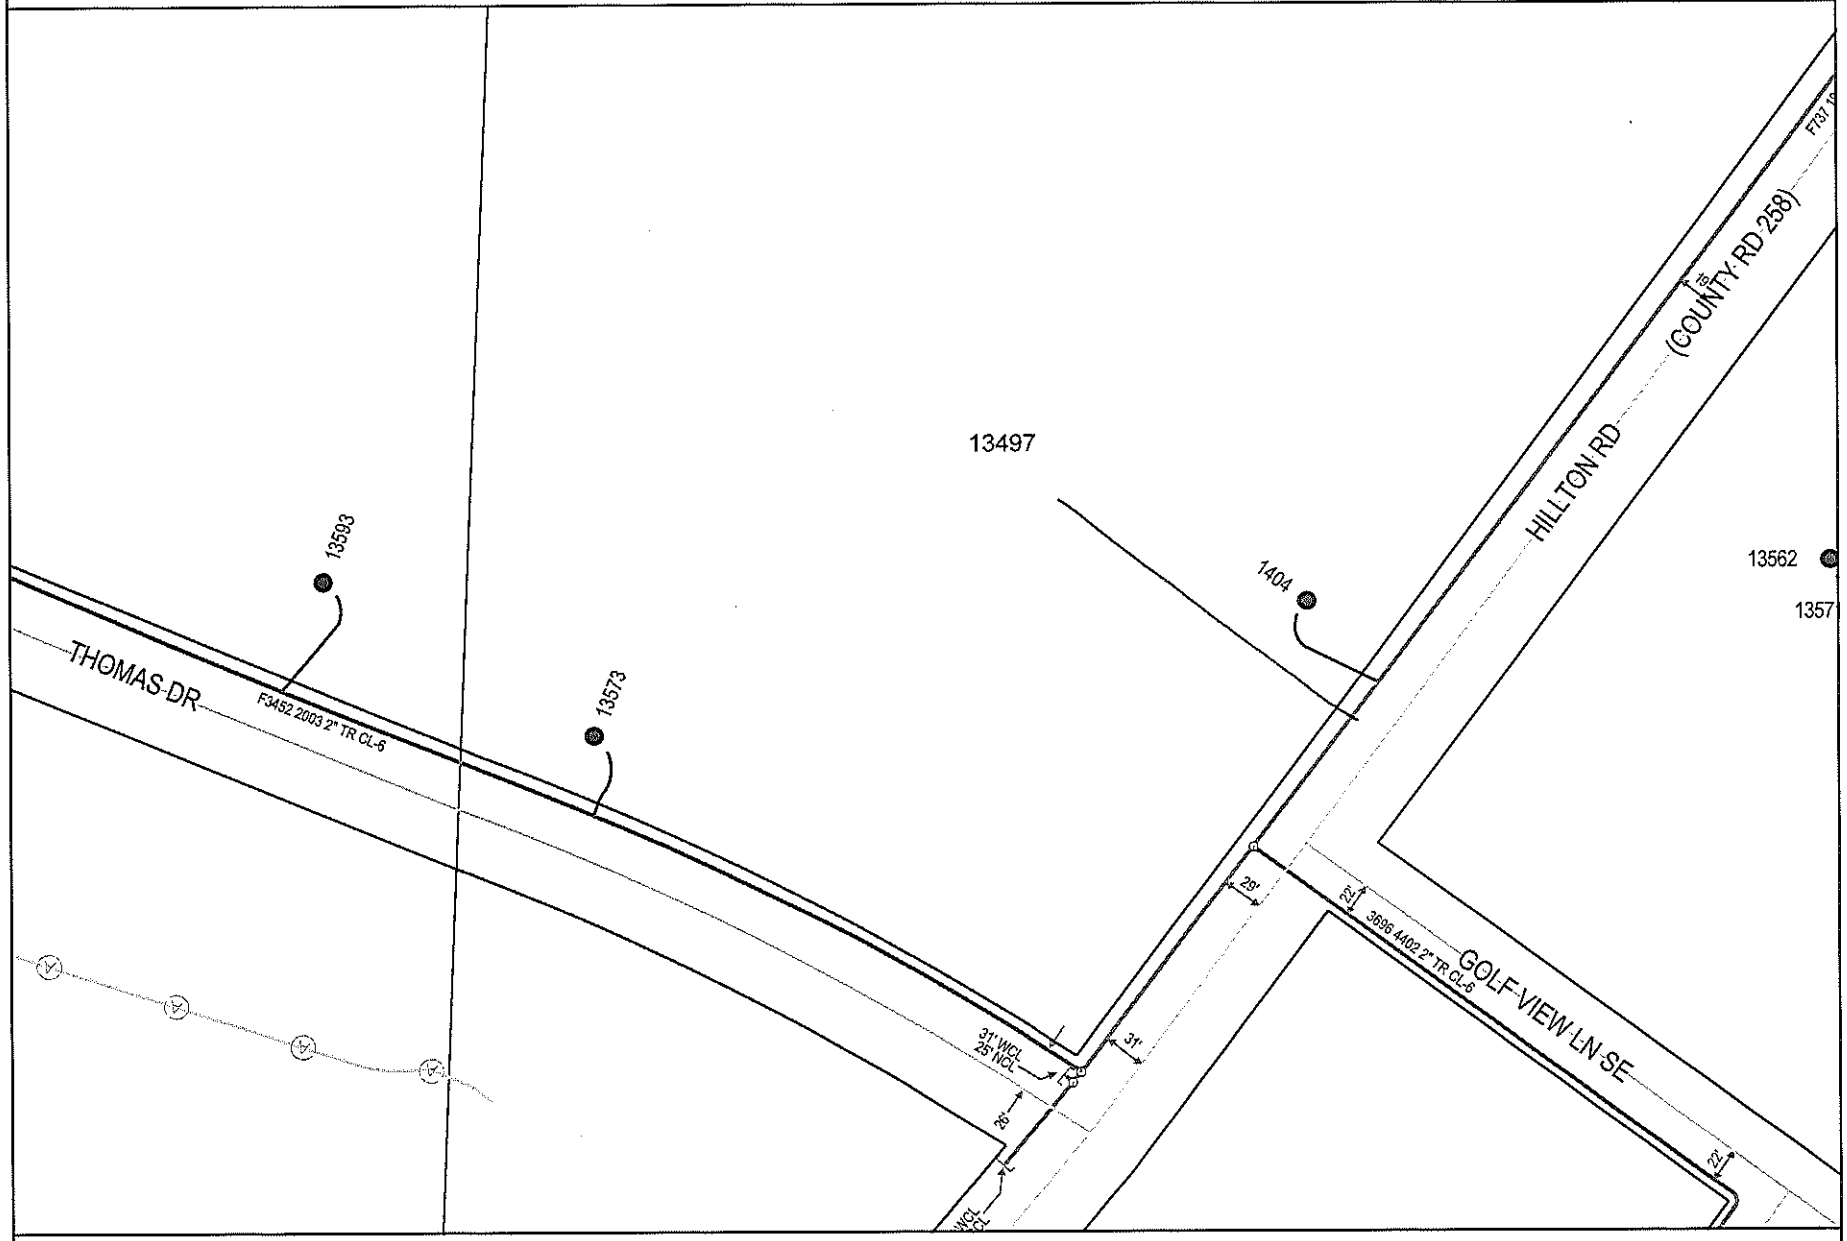

Plotted by: i216608

Plot Date: 10/16/2013

13497 HILLTON RD (AKA CR 258)

LITTLE FALLS TWP, MN 56345

Scale: 1" : 100 '

CenterPoint Energy

North