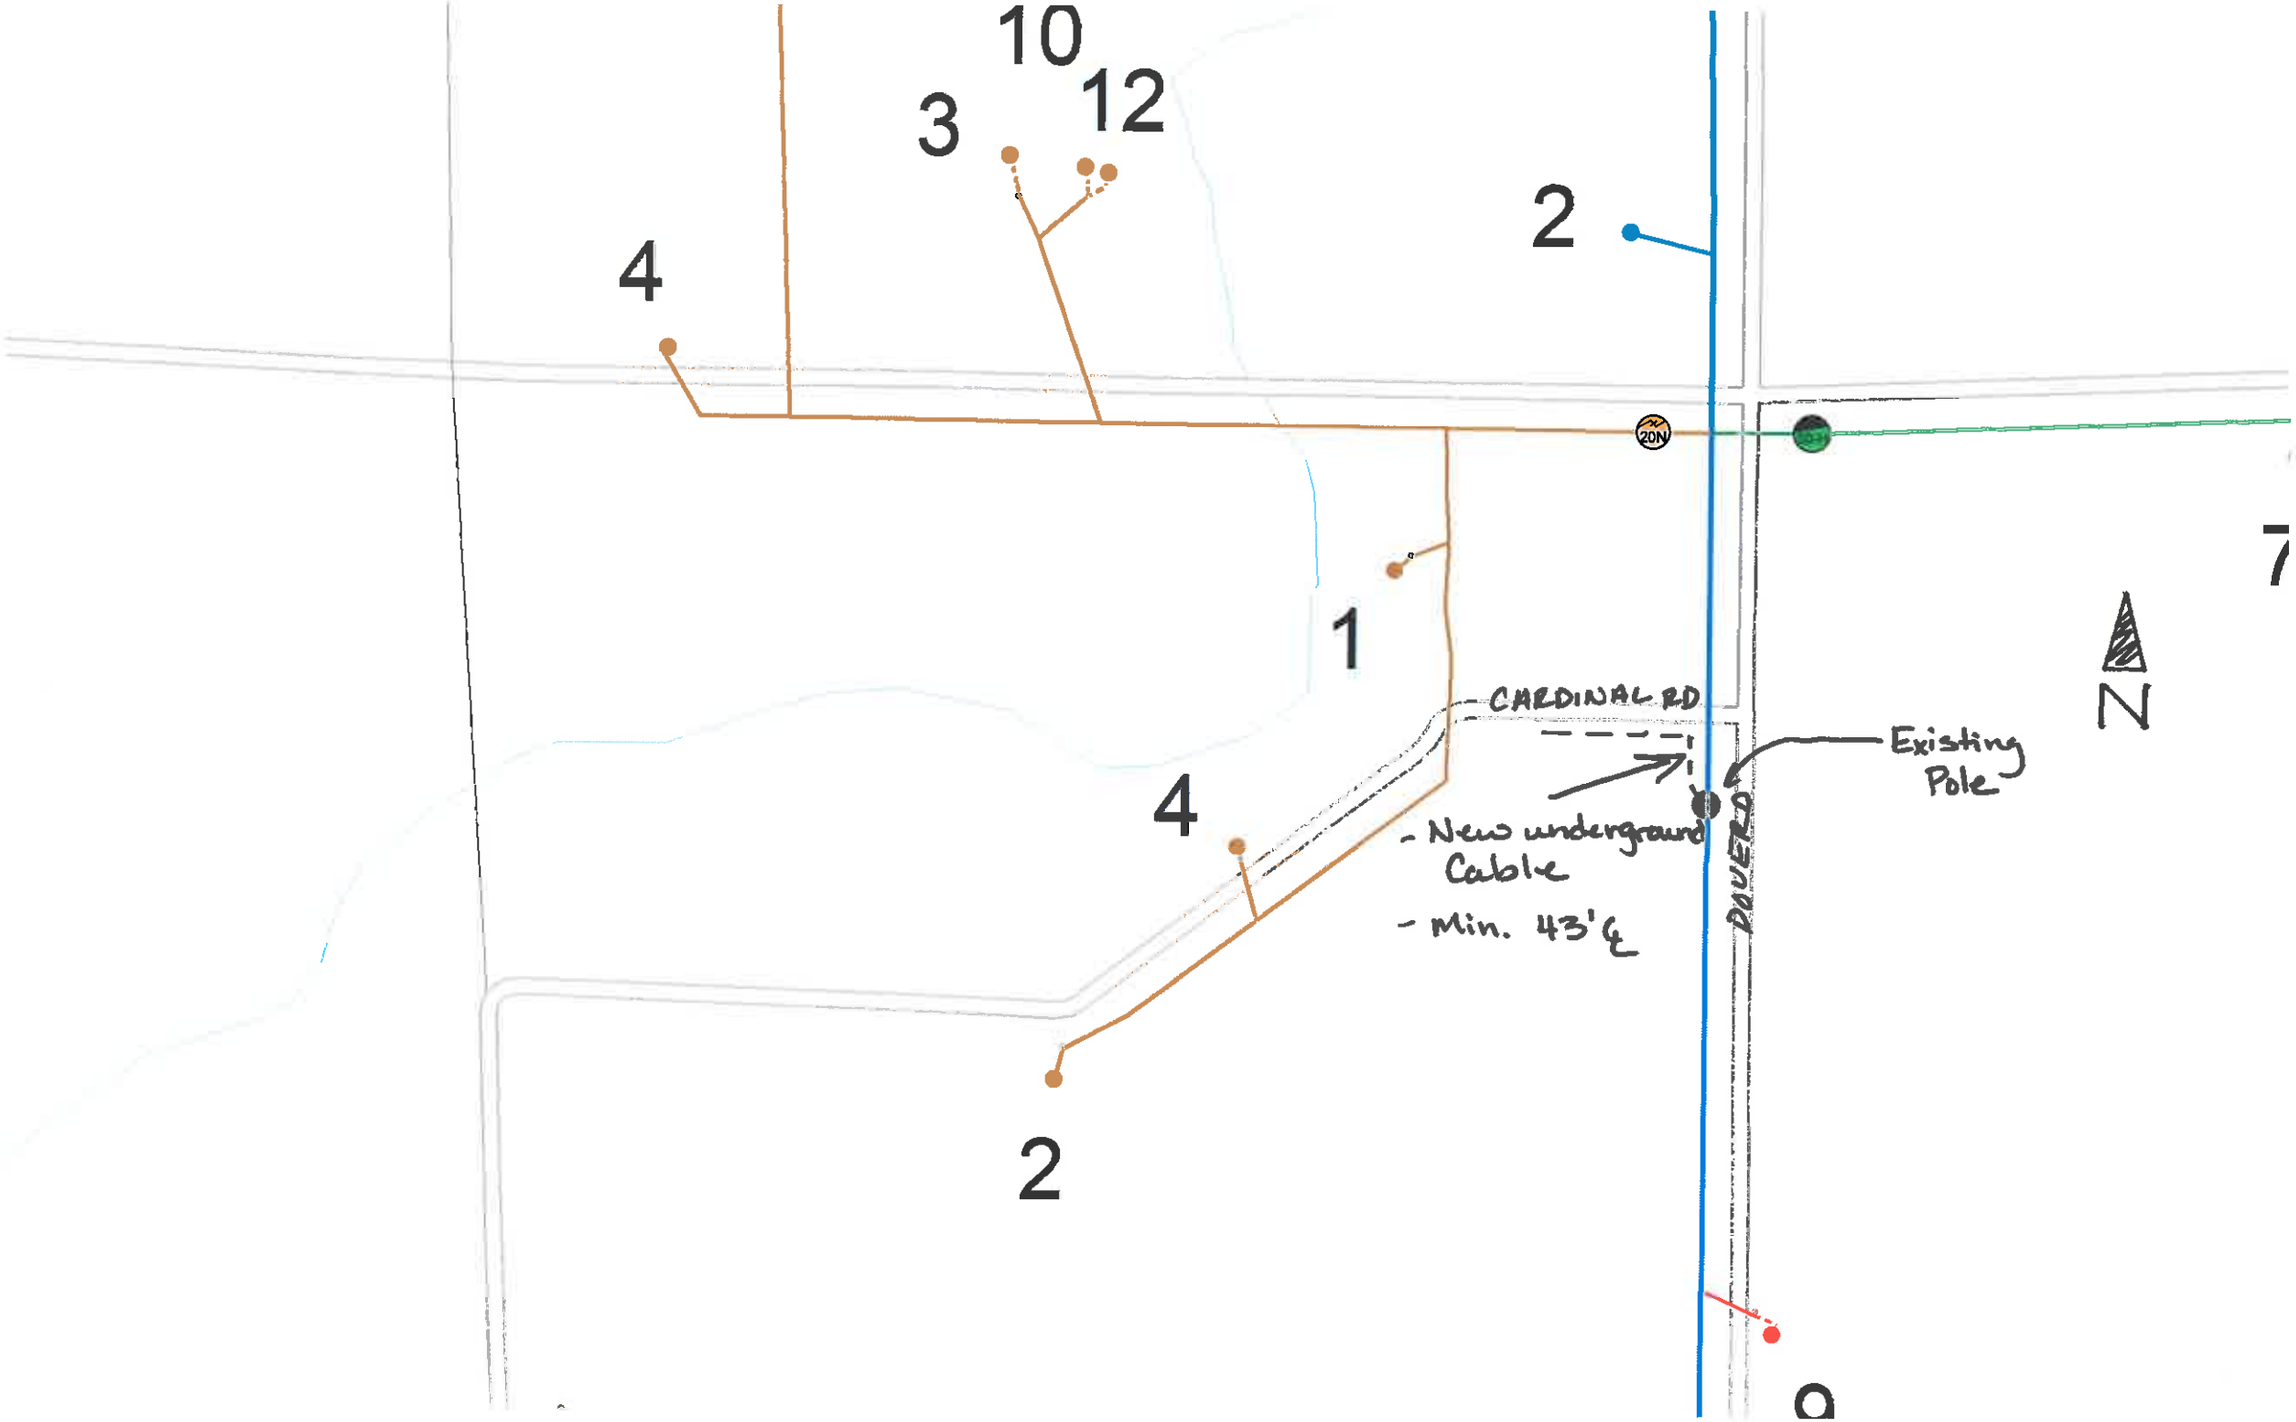
10
3
12
2
4
20N
7
1
CARDINAL RD
Existing Pole
N
4
- New underground Cable
- Min. 43'℄
2
9