


Paul + Alissa Seipel

19157 Twin Lakes Rd

507-828-5396

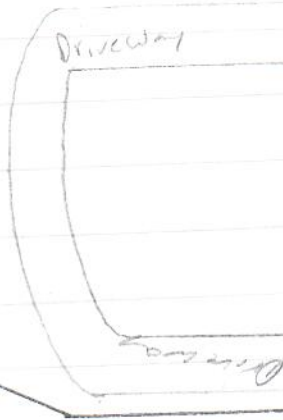

Existing 3" PE Gas Pipe

Twin Lakes Rd &

Excavation area

