


GENERAL LOCATION ONLY. DO NOT USE TO LOCATE FOR EXCAVATION. CALL 1-800-252-1166 FOR ONSITE LOCATIONS AND STAKING.

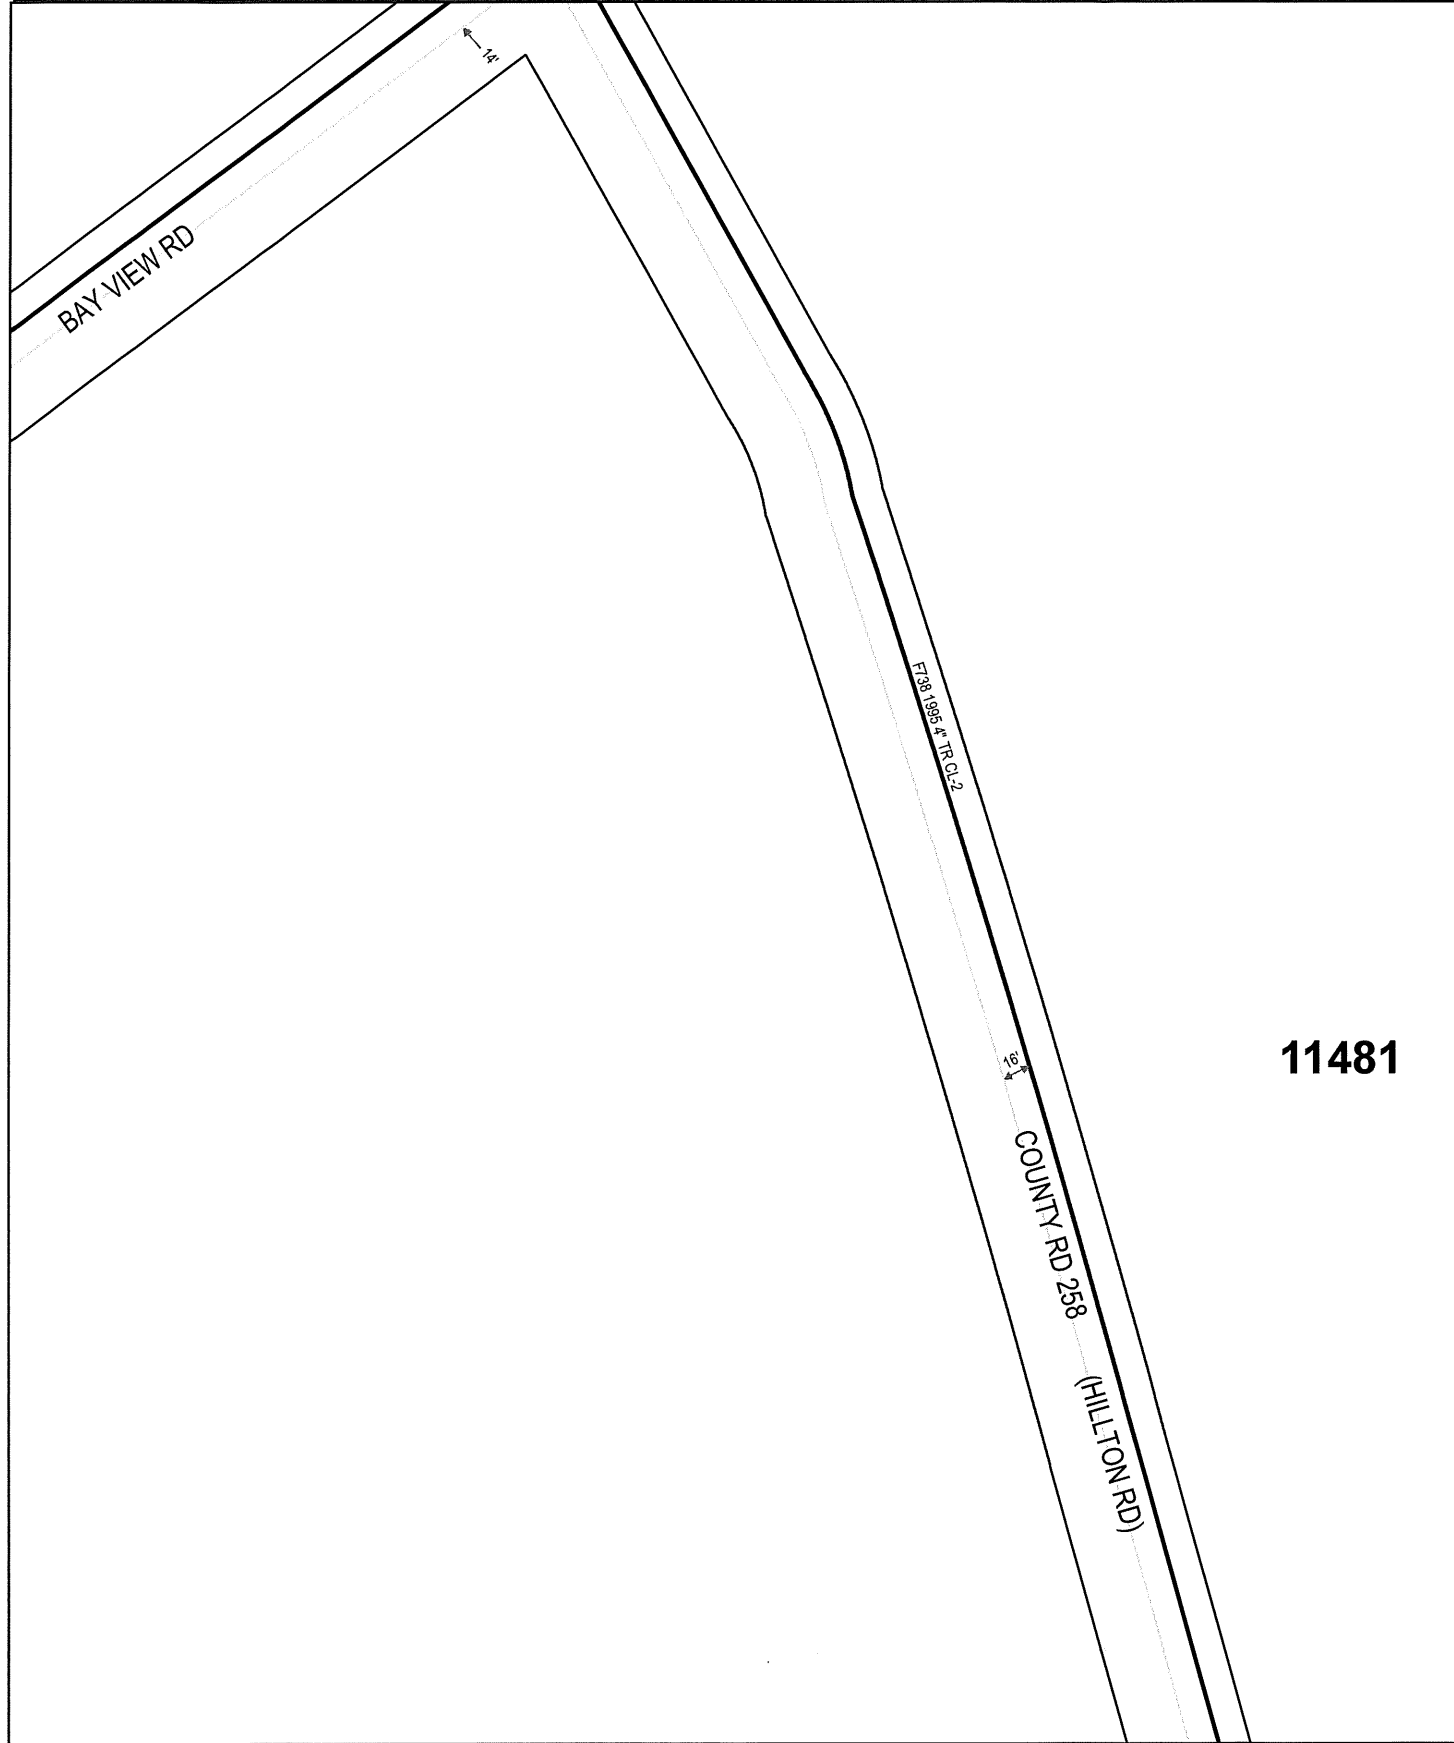

Plotted by: i222382
Plot Date: 7/11/2014

11481 SCEPANIAC DR
LITTLE FALLS, MN 56345

Scale: 1" : 100'

