


GENERAL LOCATION ONLY. DO NOT USE TO LOCATE FOR EXCAVATION. CALL 1-800-252-1166 FOR ONSITE LOCATIONS AND STAKING.

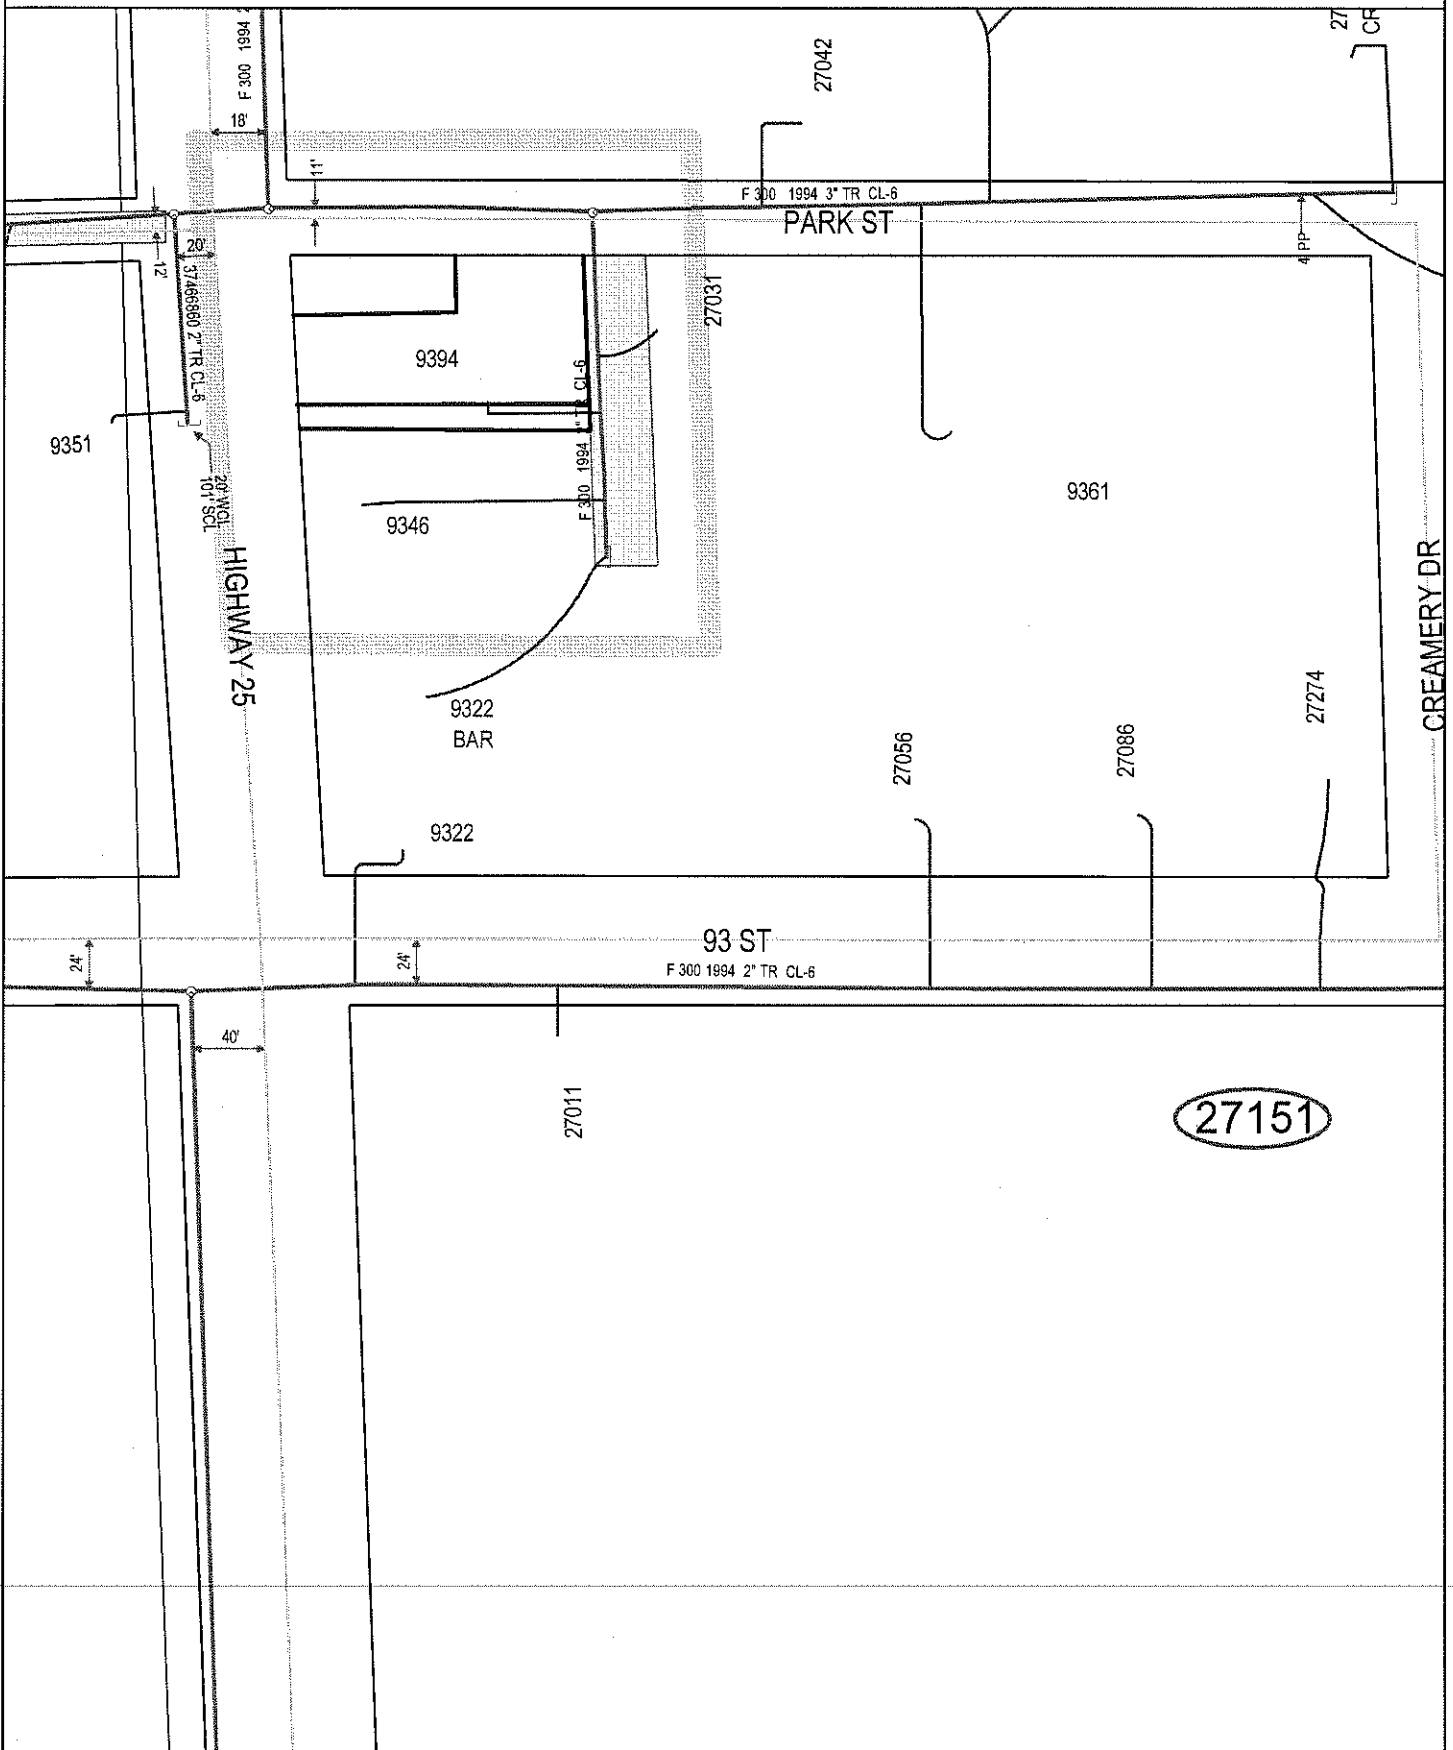

Plotted by: i222006

Plot Date: 10/29/2014

27151 93rd ST
BUCKMAN, MN 56317

Scale: 1" : 95'

