DISTANCE FROM ℄ ROAD: SEE NOTATION	CTC	TWP 41 N	ROUTE: COC9D
STAKED BY: ERR DATE: 3-11-15	PROJECT: MN 537	RNG 31 W	
REV. / REV.	EXCHANGE: Freedhem	SEC. 24 23 / 13 14	SHEET: 1 OF 12
AS BUILT BY: / DATE:	TOWNSHIP: BELLE PRAIRIE	CO. Morrison	SERVICE AREA: Freedhem

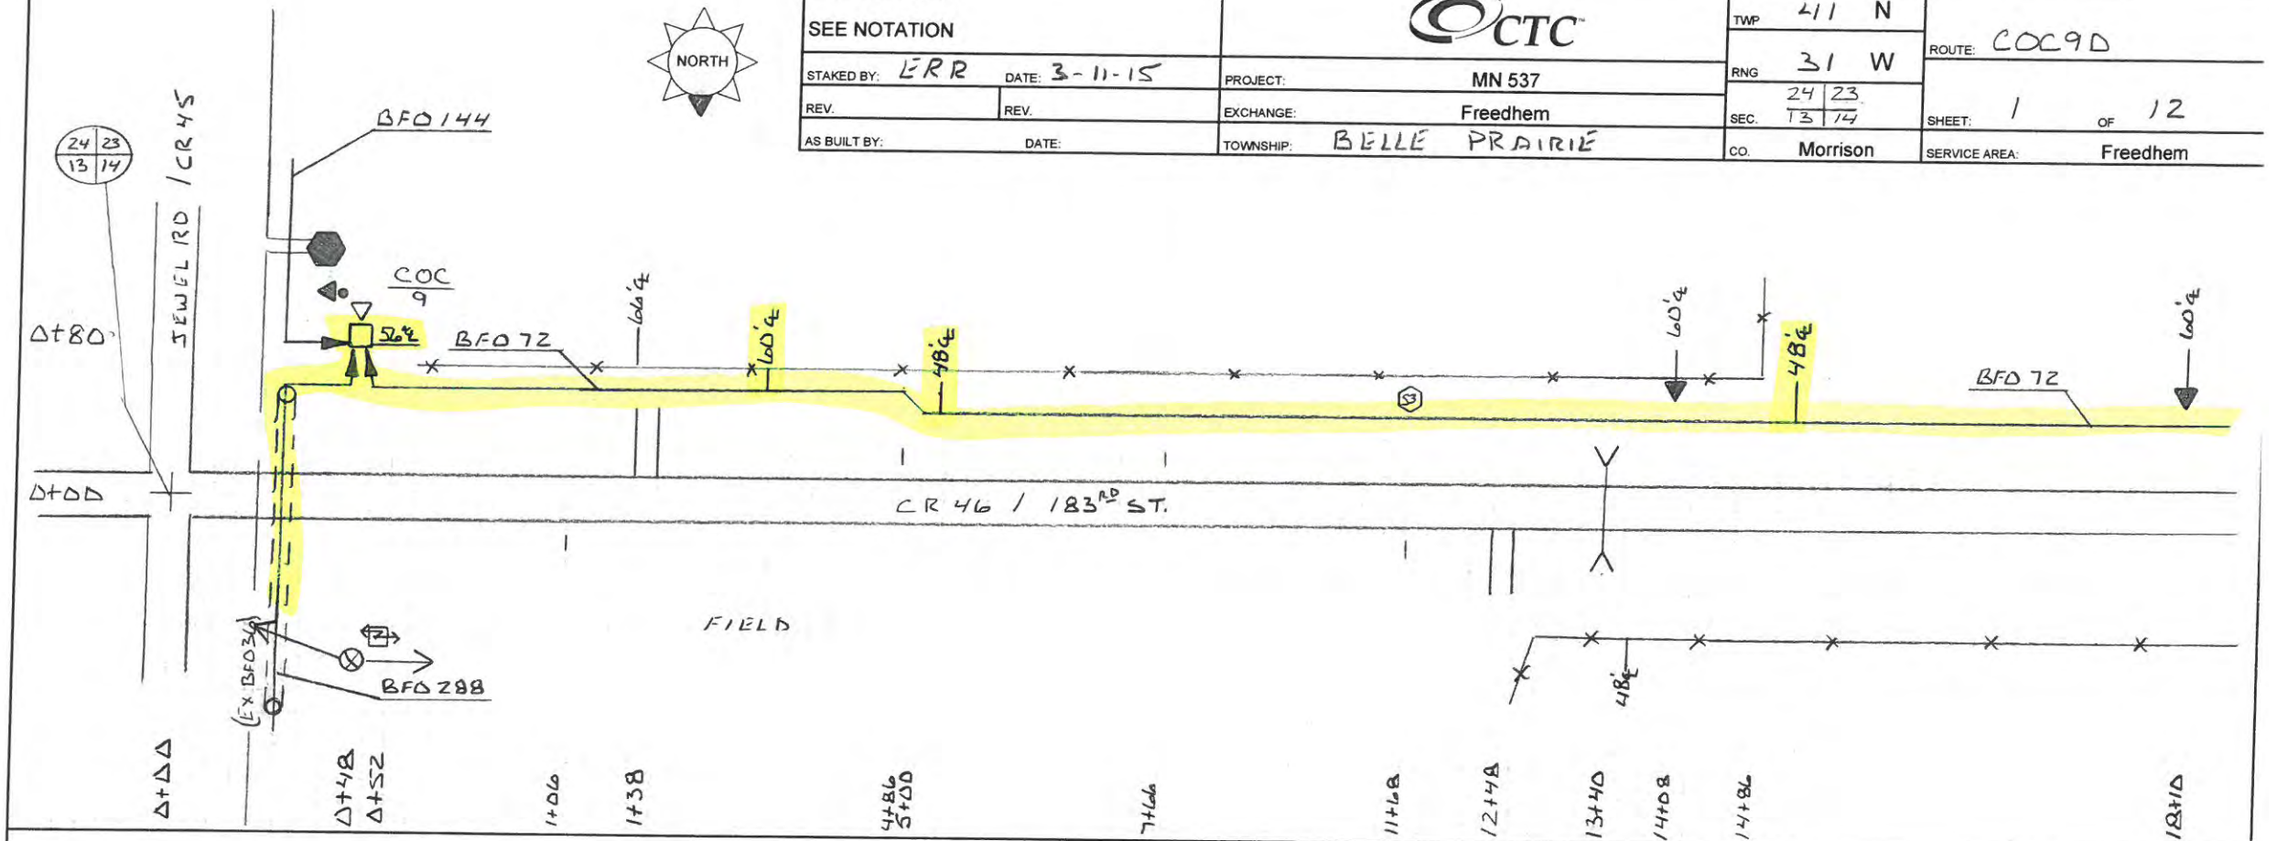

HOUSING NO.	BA	BDO	BFO	BH	BM	HBF	HO	NID	SUB NO.	SE	UD	UO	
					NO UNITS								

Prepared By: CNS 218-564-3000

DISTANCE FROM ℄ ROAD		CTC	TWP 41 N	ROUTE: COC9D
SEE NOTATION			RNG 31 W	
STAKED BY: ERR	DATE: 3-11-15	PROJECT: MN 537		
REV.	REV.	EXCHANGE: Freedhem	SEC. 23	SHEET: 2 OF 12
AS BUILT BY:	DATE:	TOWNSHIP: BELLE PRAIRIE	CO. Morrison	SERVICE AREA: Freedhem

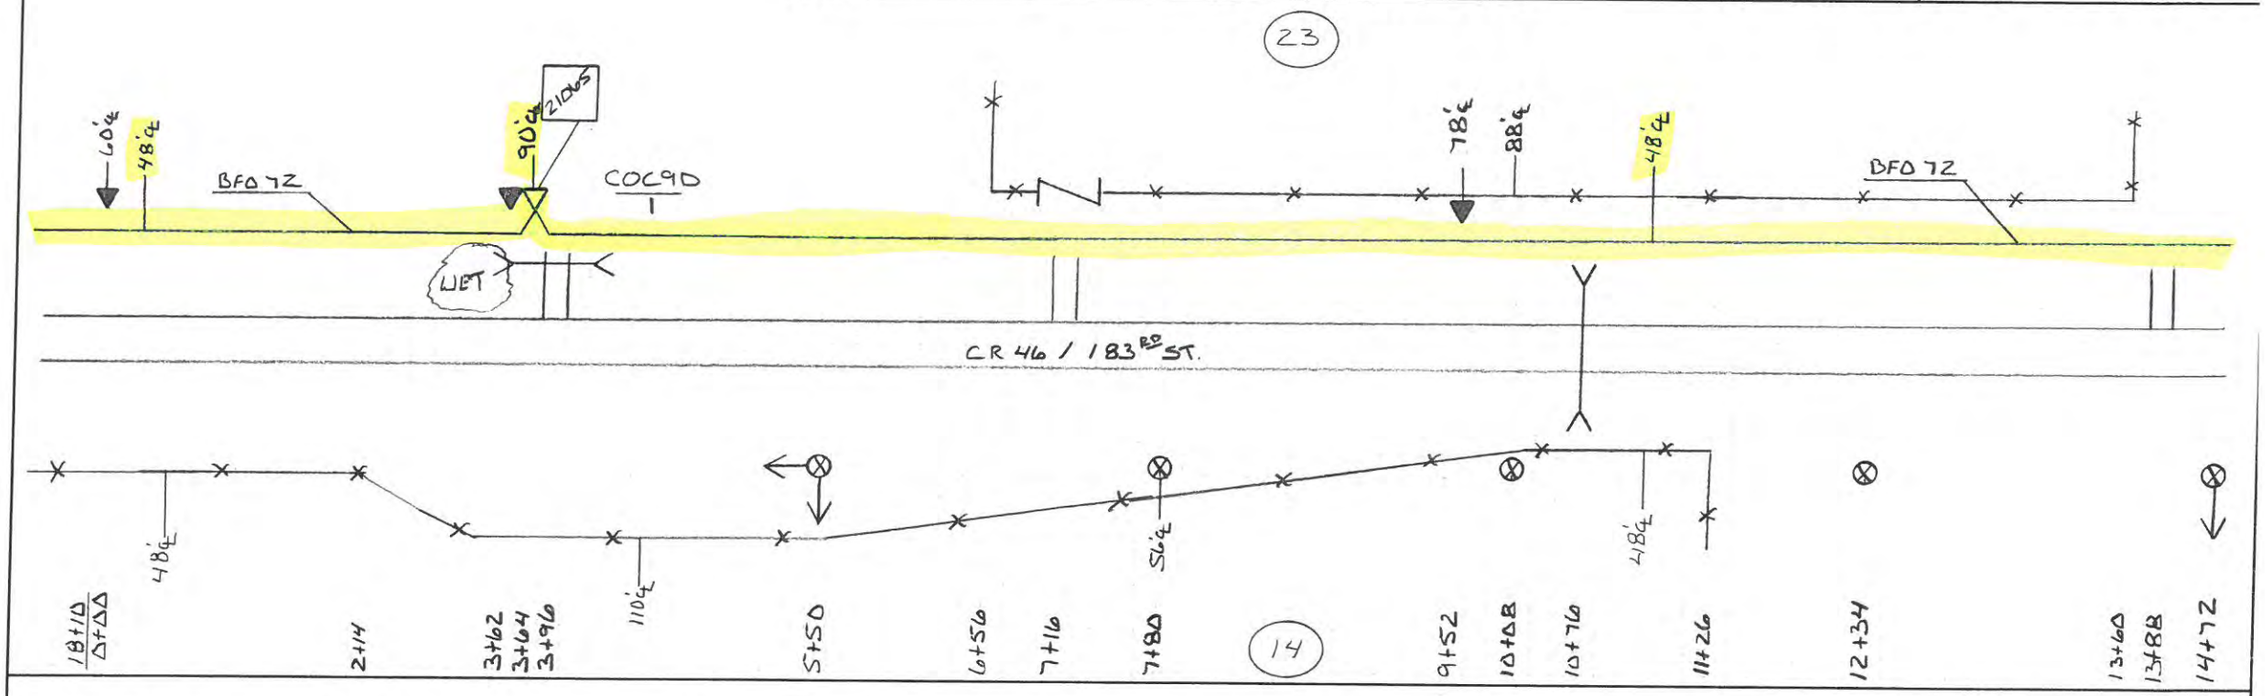

HOUSING NO.	BA	BDO	BFO	BH	BM	HBF	HO	NID	SUB NO.	SEB	UD	UO
	3	4 (AGS)	72		2 (~~5/8~~) 53 53A		-1	5		4		
1	1	1	2336		1 1 1		1	1	21065	408		
	1	1	2336		1 1 1		1	1		408		

Prepared By: CNS 218-564-3000

DISTANCE FROM ℄ ROAD		CTC	TWP 41 N	ROUTE: COC9D
SEE NOTATION			RNG 31 W	
STAKED BY: ERR	DATE: 3-11-15	PROJECT: MN 537	SEC. 23	SHEET: 3 OF 12
REV.	REV.	EXCHANGE: Freedhem	CO. Morrison	SERVICE AREA: Freedhem
AS BUILT BY:	DATE:	TOWNSHIP: BELLE PRAIRIE		

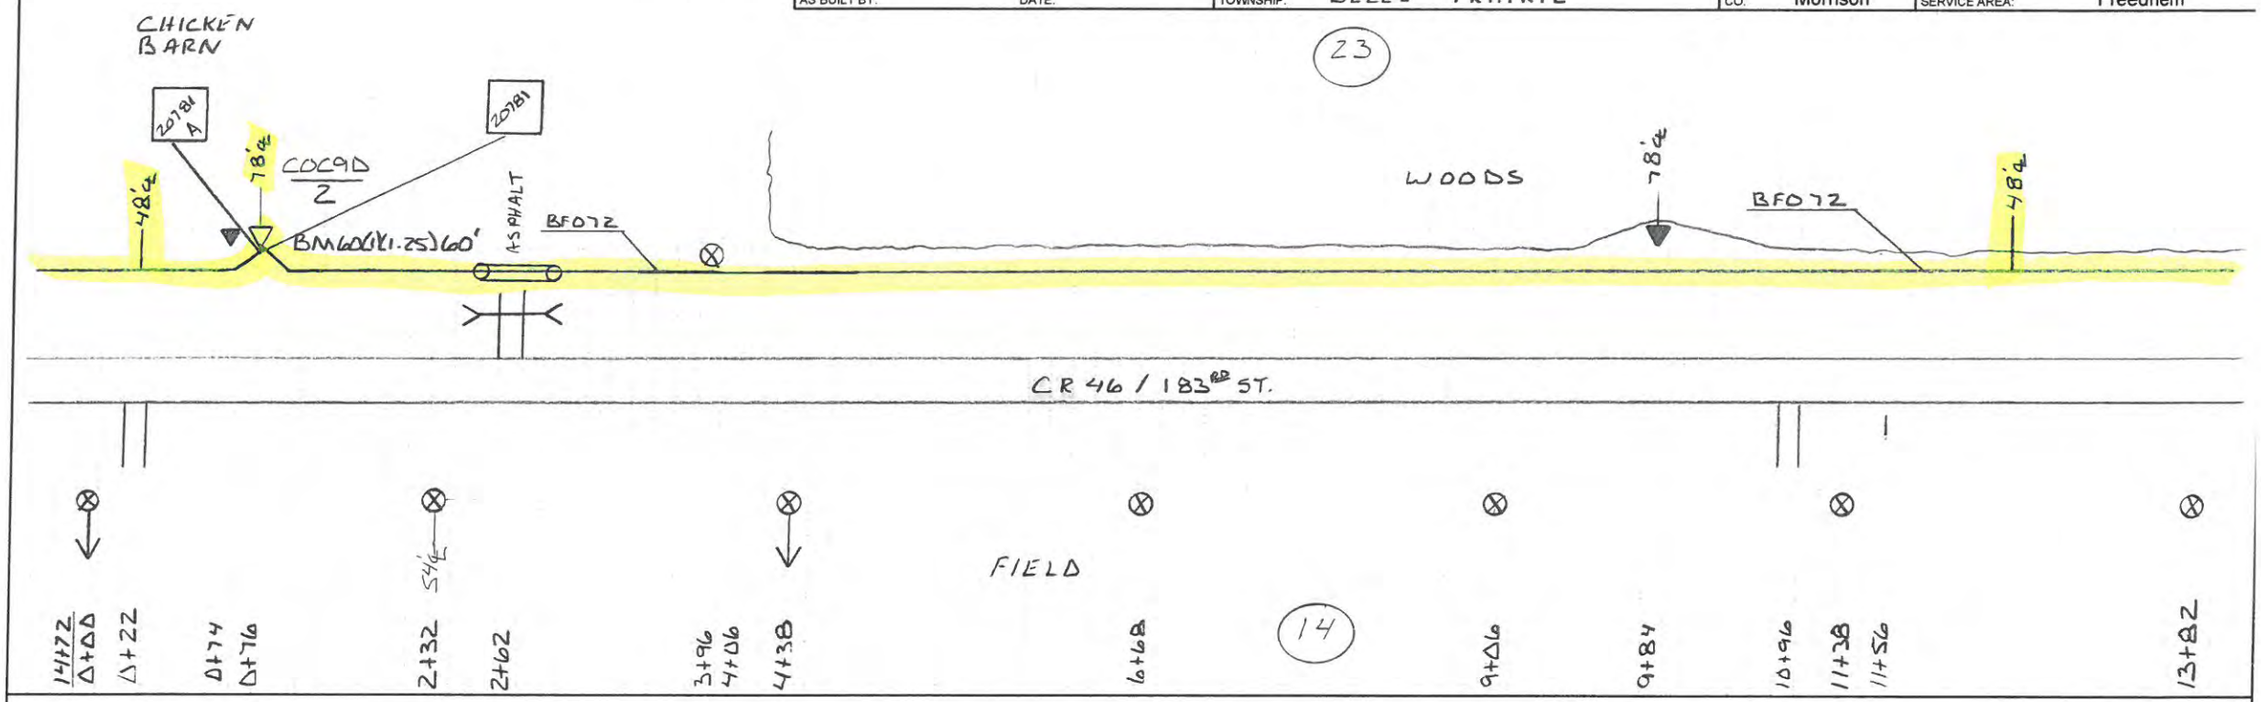

HOUSING NO.	BA	BDO	BFO	BH	BM	HBF	HO	NID	SUB NO.	SEB	UD	UO	
	3	4 (AGS)	72		2 (5/8/8) 53A 60 (3)		-1	2 5		4			
2	1	1	1288		1 1		2	1	20781 A	610			
					60			1	20781	562			
	1	1	1288		1 1 60		2	1 1		1174			

Prepared By: CNS 218-564-3000

DISTANCE FROM ℄ ROAD: SEE NOTATION	CTC	TWP 41 N	ROUTE: COC9D
STAKED BY: ERR DATE: 3-11-15	PROJECT: MN 537	RNG 31 W	
REV. REV.	EXCHANGE: Freedhem	SEC. 23/14 22/15	SHEET: 4 OF 12
AS BUILT BY: DATE:	TOWNSHIP: BELLE PRAIRIE	CO. Morrison	SERVICE AREA: Freedhem

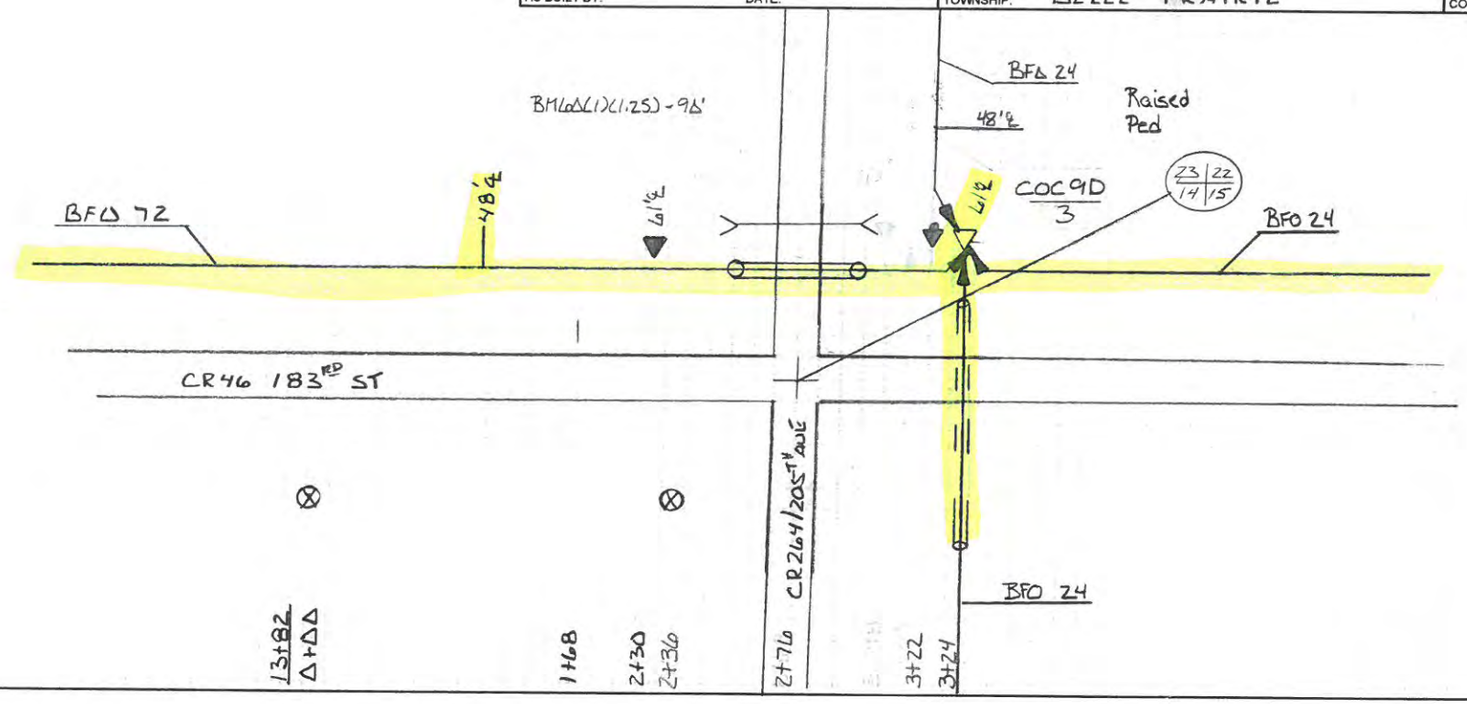

HOUSING NO.	BA	BDO	BFO	BH	BM	HBF	HO	NID	SUB NO.	SE	UD	UO	
	4	4 (AS)	72		2 (5/8)(8) 53A 60 (1)(.25) 81		-1						
3	1	1	1748		1 1 90 1								
	1	1	1748		1 1 90 1								

Prepared By: CNS 218-564-3000

DISTANCE FROM ℄ ROAD: SEE NOTATION	CTC	TWP 41 N	ROUTE: CO C9 D3 D
STAKED BY: EDB DATE: 3-12-15	PROJECT: MN 537	RNG 31 W	
REV. REV.	EXCHANGE: Freedhem	SEC. 22/15	SHEET: 1 OF 10
AS BUILT BY: DATE:	TOWNSHIP: Belle Prairie	CO. Morrison	SERVICE AREA: Freedhem

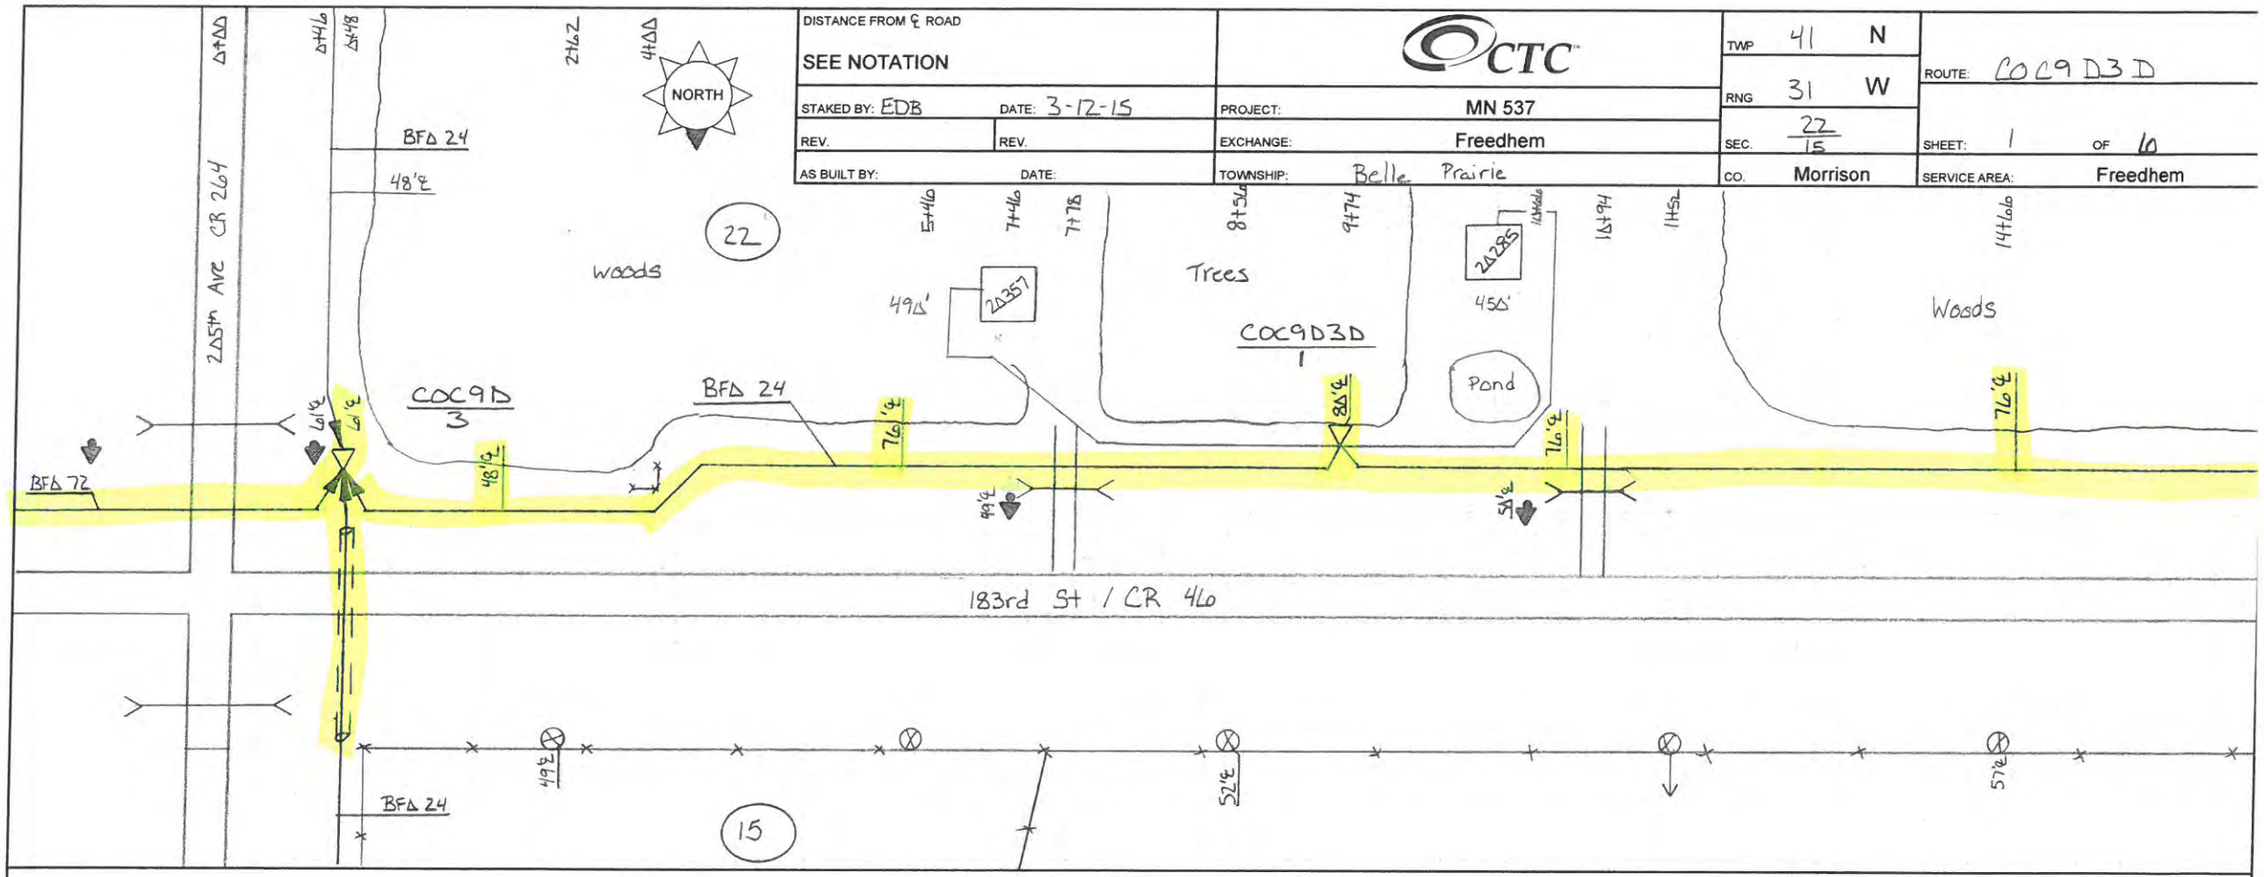

HOUSING NO.	BA	BDO	BFO	BH	BM	HBF	HO	NID	SUB NO.	SEB	UD	UO
	3	4 (AGS)	24		2 (5/8)(8) 53A 61 (3)		-1	3 7		4		
1	1	1	1022		1 1		2	1	20357	490		
					60			1	20285	450		
	1	1	1022		1 1 60		2	1 1		940		

Prepared By: CNS 218-564-3000

DISTANCE FROM ℄ ROAD: SEE NOTATION	CTC	TWP 41 N	ROUTE: COC9D3D
STAKED BY: EDB DATE: 3-12-15	PROJECT: MN 537	RNG 31 W	
REV. REV.	EXCHANGE: Freedhem	SEC. 22/15	SHEET: 2 OF 6
AS BUILT BY: DATE:	TOWNSHIP: Belle Prairie	CO. Morrison	SERVICE AREA: Freedhem

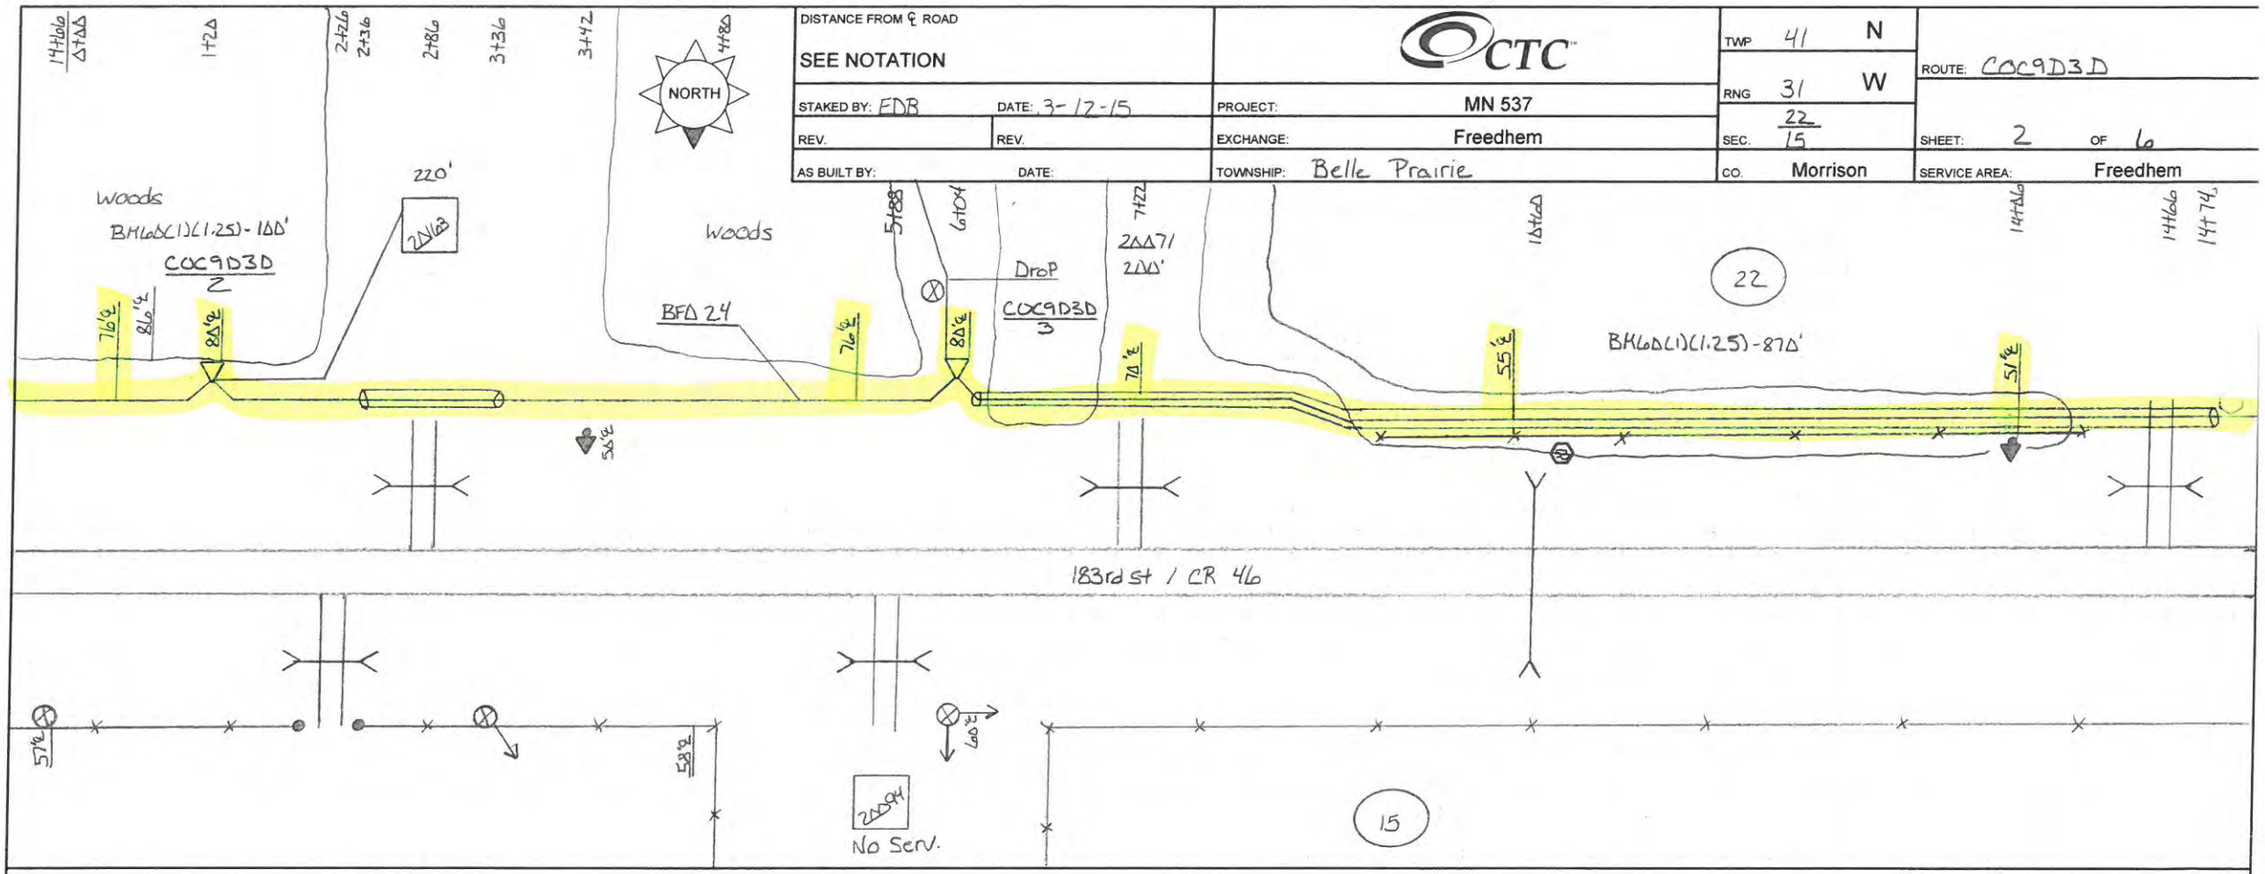

HOUSING NO.	BA	BDO	BFO	BH	BM	HBF	HO	NID	SUB NO.	SE B	UD	UO
	3	4 (AGS)	24		2 (5/8)(8) 53A 60 (1)(1.25)		-1	3 5		4		
2	1	1	698		1 1		1	1	20163	220		
3	1	1	5660		1 1 100		1	1	20071	200		
	2	2	1264		2 2 100		2	1 1		420		

Prepared By: CNS 218-564-3000

DISTANCE FROM ℄ ROAD: SEE NOTATION	CTC	TWP 41 N	ROUTE: CAC 9D3D
STAKED BY: EDB DATE: 3-12-15	PROJECT: MN 537	RNG 31 W	
REV. REV.	EXCHANGE: Freedhem	SEC. 27/15	SHEET: 3 OF 6
AS BUILT BY: DATE:	TOWNSHIP: Belle Prairie	CO. Morrison	SERVICE AREA: Freedhem

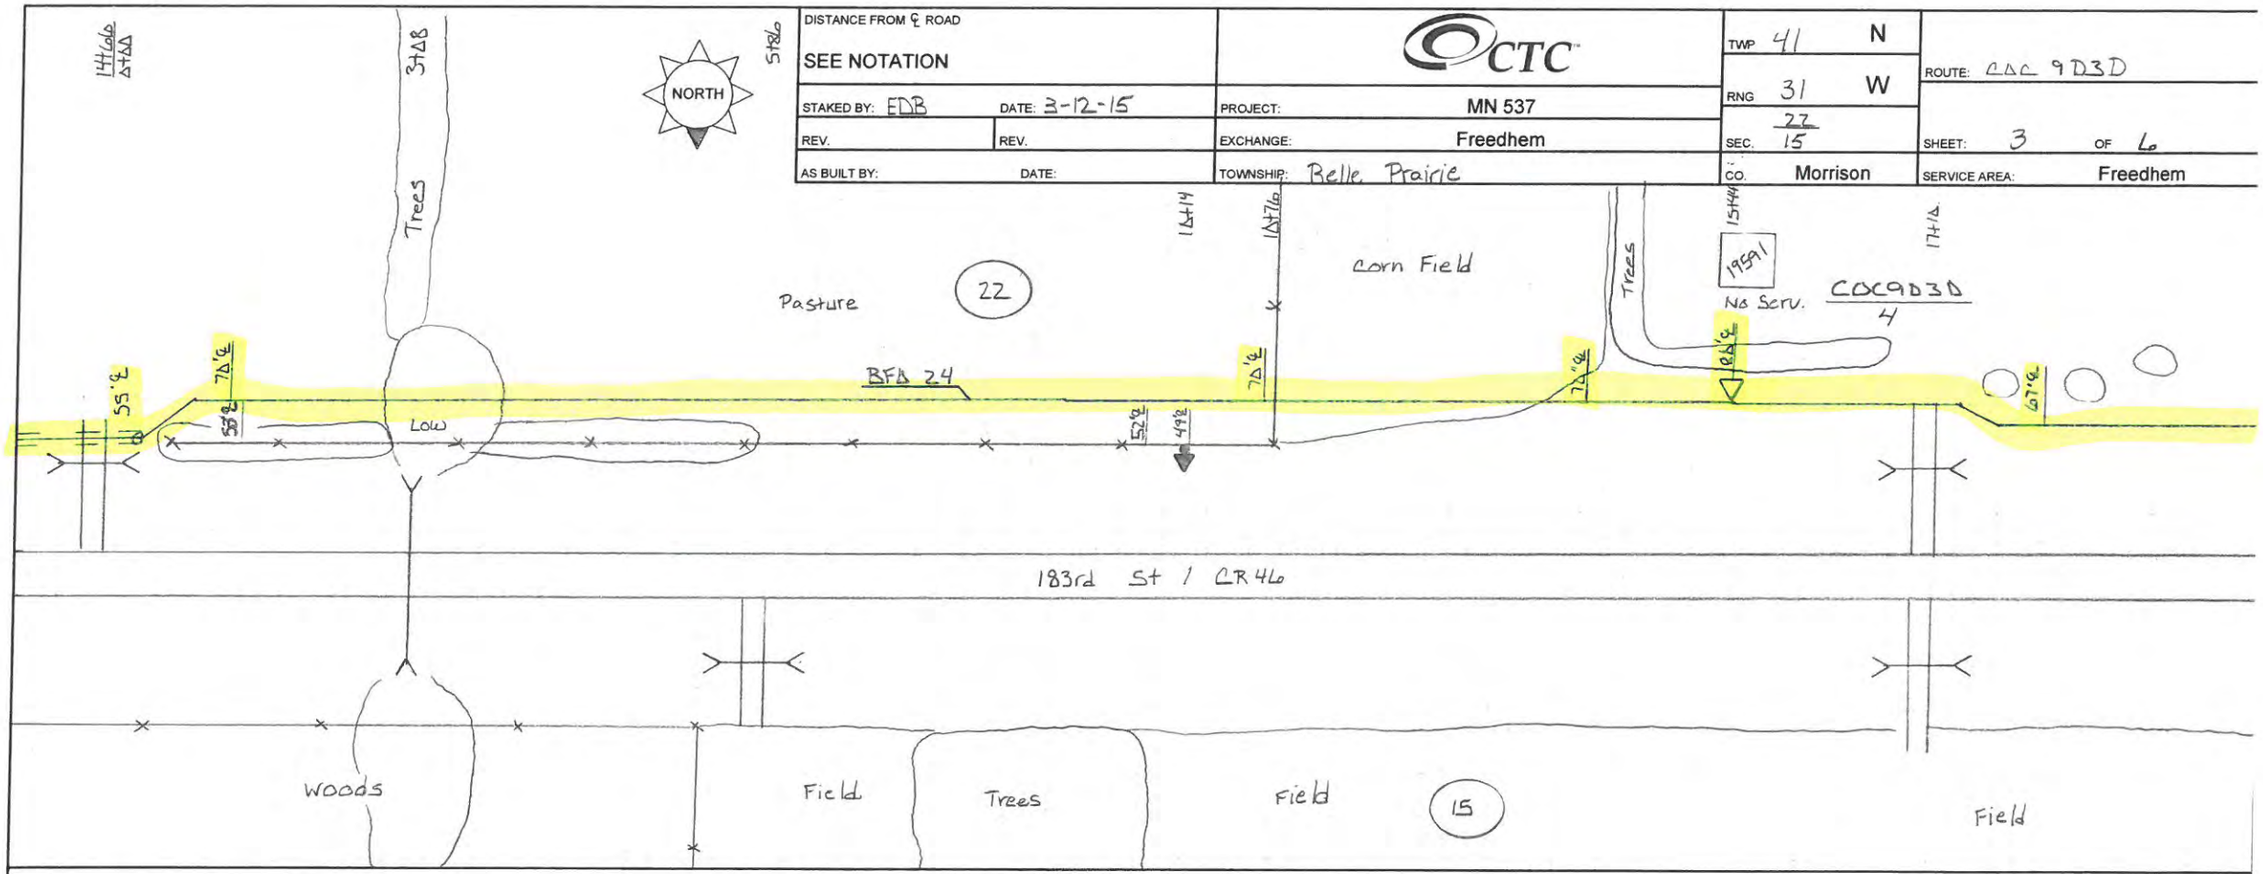

HOUSING NO.	BA	BDO	BFO	BH	BM	HBF	HO	NID	SUB NO.	SE	UD	UO	
	3	4 (AGS)	24		2 (58) (8) 53 53A (60) (1.25)		-1						
4	1	1	2554		1 1 1 870								
	1	1	2554		1 1 1 870								

Prepared By: CNS 218-564-3000

DISTANCE FROM ℄ ROAD: SEE NOTATION	CTC	TWP 41 N	ROUTE: COC9D3D
STAKED BY: EDB DATE: 3-12-15	PROJECT: MN 537	RNG 31 W	
REV. REV.	EXCHANGE: Freedhem	SEC. 15 / 22 / 16 / 21	SHEET: 4 OF 6
AS BUILT BY: DATE:	TOWNSHIP: Belle Prairie	CO. Morrison	SERVICE AREA: Freedhem

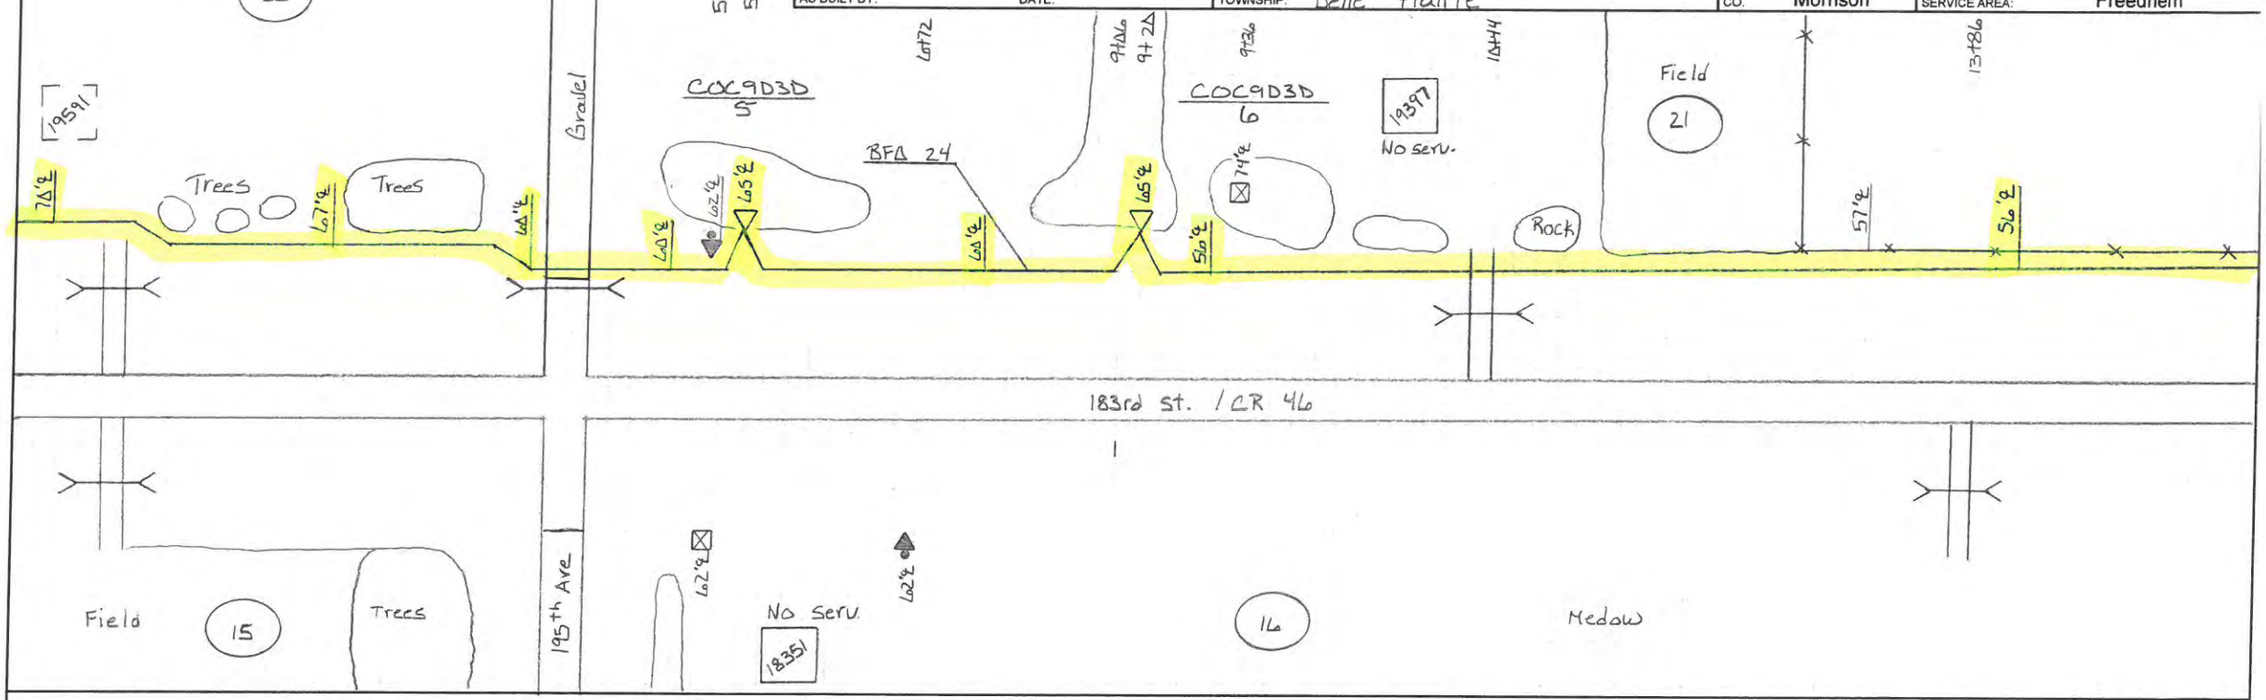

HOUSING NO.	BA	BDO	BFO	BH	BM	HBF	HO	NID	SUB NO.	SE	UD	UO	
	3	4 (AGS)	24		2 (F/6)(8) 53A								
5	1	1	772		1 1								
6	1	1	482		1 1								
	2	2	1254		2 2								

Prepared By: CNS 218-564-3000

DISTANCE FROM ℄ ROAD: SEE NOTATION	CTC	TWP 41 N	ROUTE: COC9 D3D
STAKED BY: FDB DATE: 3-16-15	PROJECT: MN 537	RNG 31 W	
REV. REV.	EXCHANGE: Freedhem	SEC. 21/16	SHEET: 5 OF 6
AS BUILT BY: DATE:	TOWNSHIP: Belle Prairie	CO. Morrison	SERVICE AREA: Freedhem

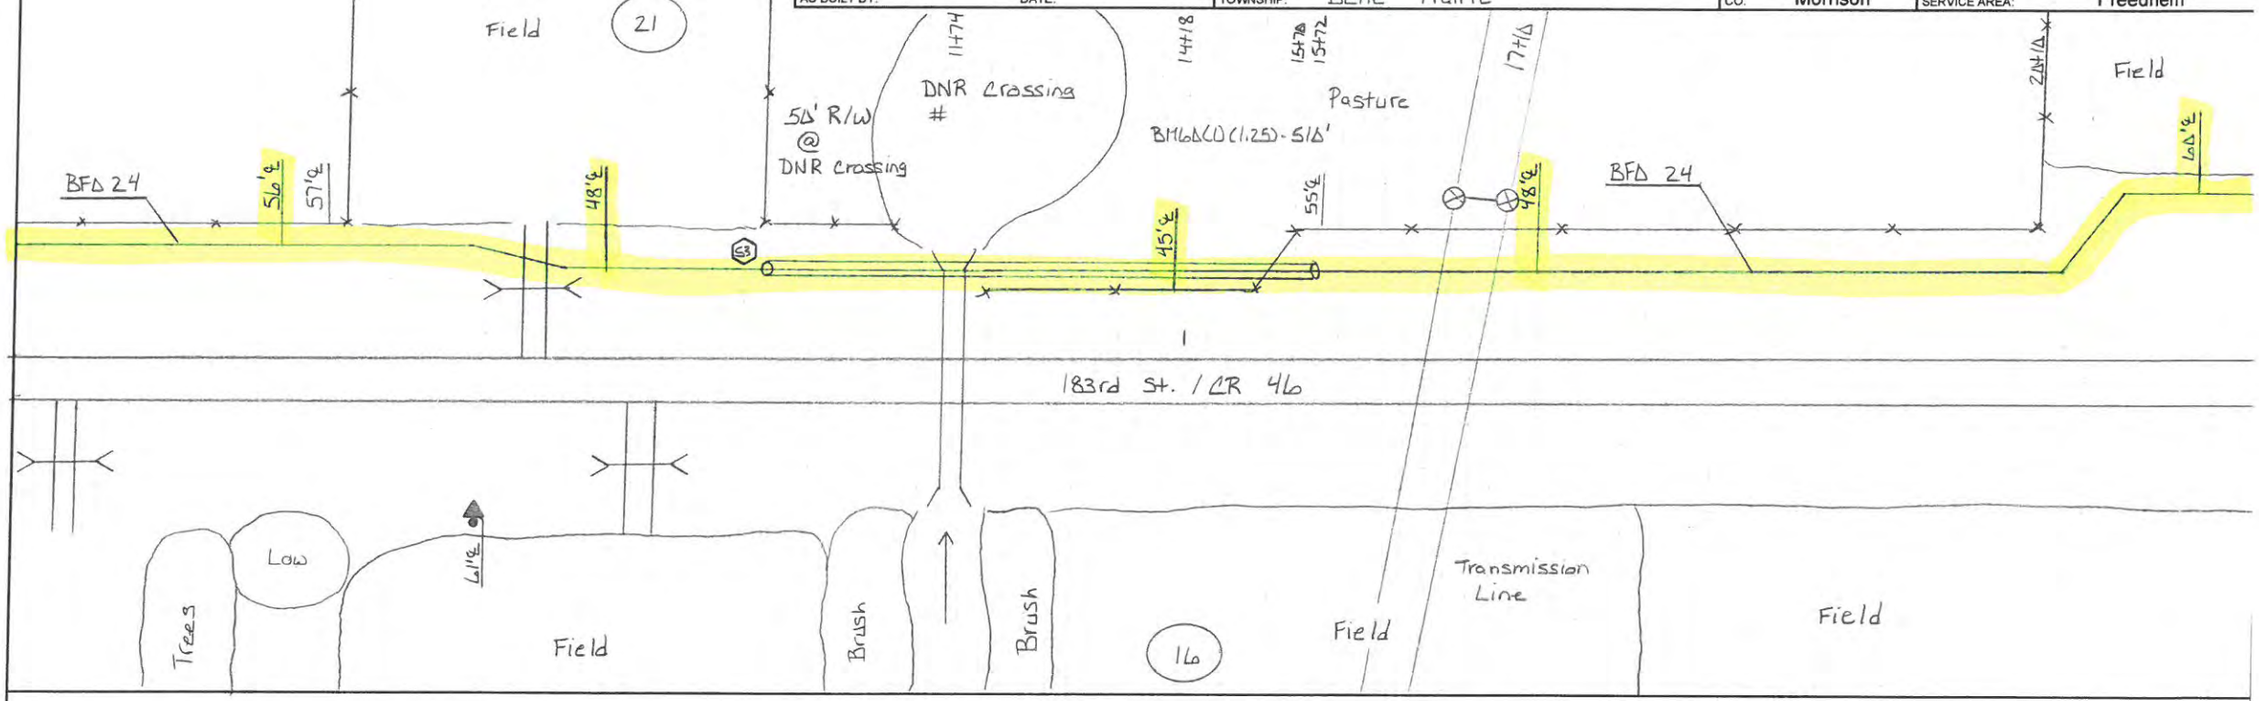

HOUSING NO.	BA	BDO	BFO	BH	BM	HBF	HO	NID	SUB NO.	SE	UD	UO	
					NO UNITS								

Prepared By: CNS 218-564-3000

DISTANCE FROM ℄ ROAD: SEE NOTATION	CTC	TWP 41 N / RNG 31 W	ROUTE: COC9D3D
STAKED BY: EDB DATE: 3-16-15	PROJECT: MN 537	SEC. 21/16	SHEET: 6 OF 6
REV. / REV.	EXCHANGE: Freedhem		
AS BUILT BY: / DATE:	TOWNSHIP: Belle Prairie	CO. Morrison	SERVICE AREA: Freedhem

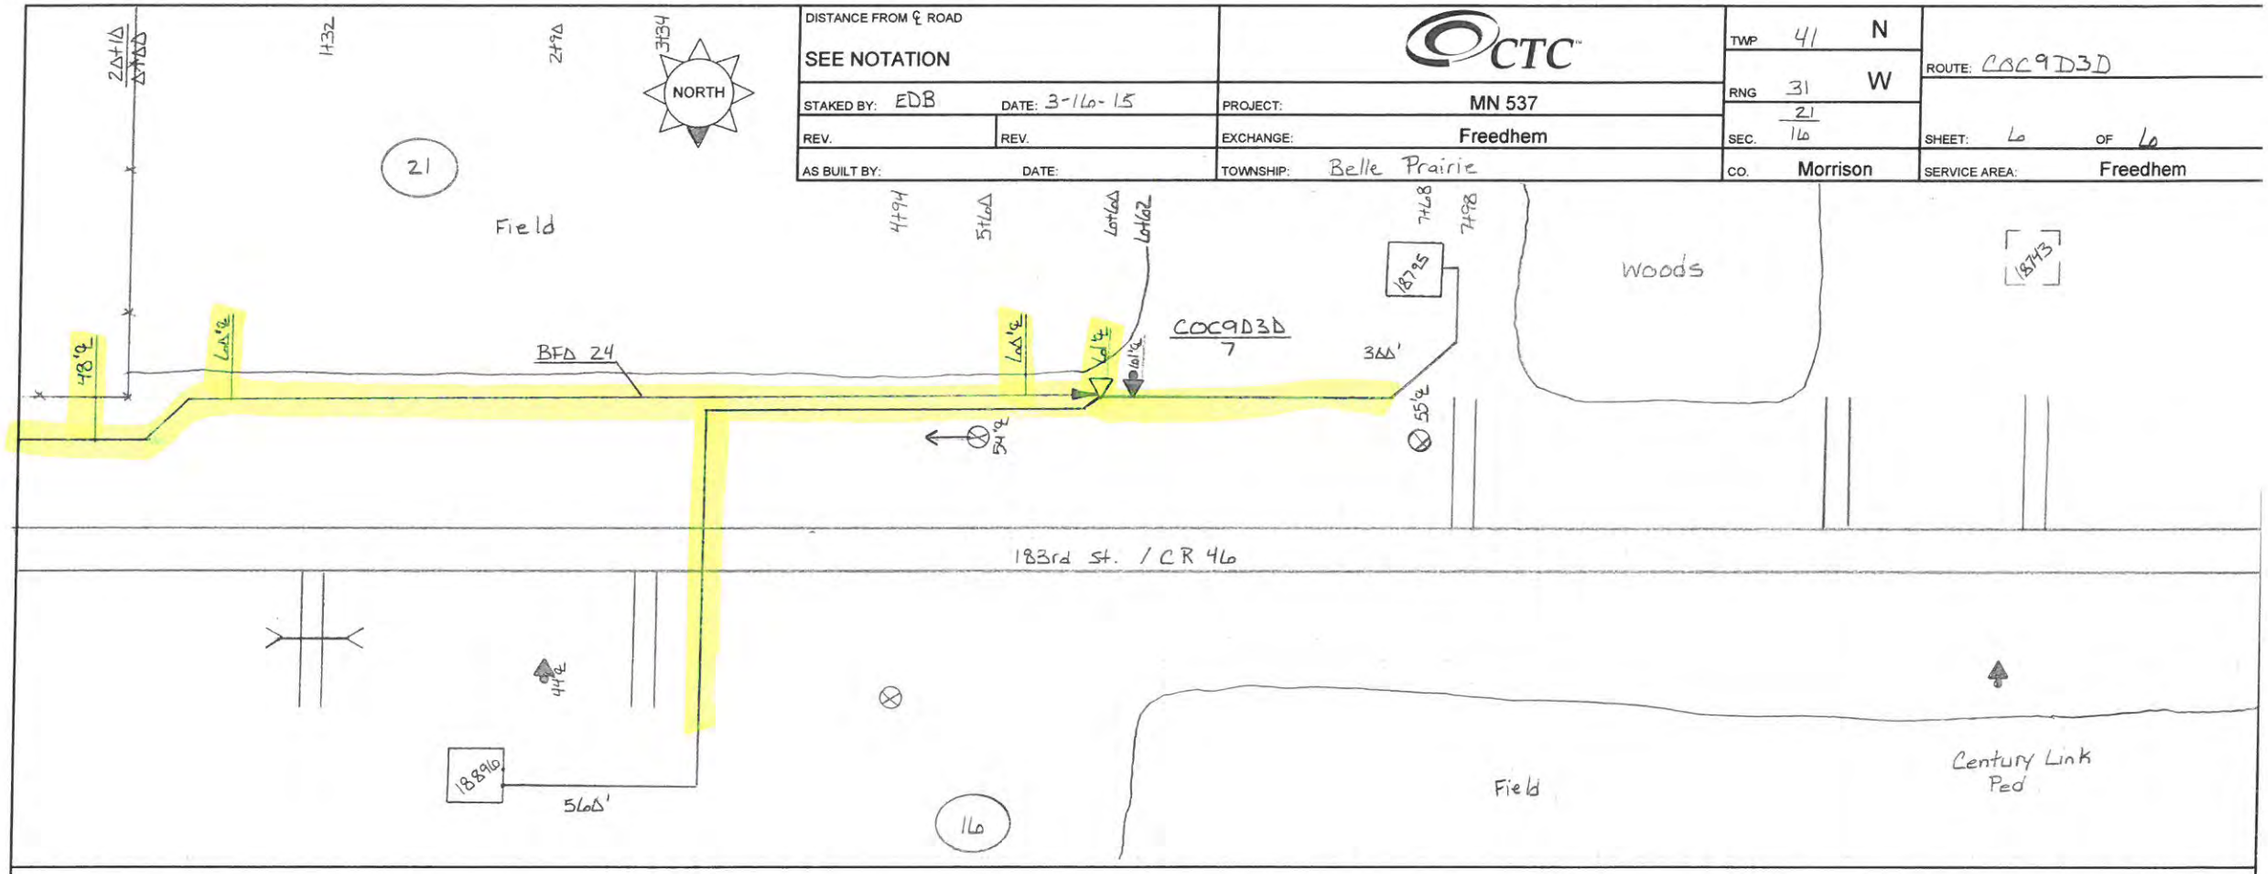

HOUSING NO.	BA	BDO	BFO	BH	BM	HBF	HO	NID	SUB NO.	SEB	UD	UO
	3	4 (AGS)	24		2 (5/8 8) 53 53A 60 (1 1.25) 61 (3)			3		4		
7	1	1	3298		1 1 1 510 80			1	18896	560		
					16			1	18795	300		
	1	1	3298		1 1 1 510 96			2		860		

Prepared By: CNS 218-564-3000