GENERAL LOCATION ONLY. DO NOT USE TO LOCATE FOR EXCAVATION. CALL 1-800-252-1166 FOR ONSITE LOCATIONS AND STAKING.

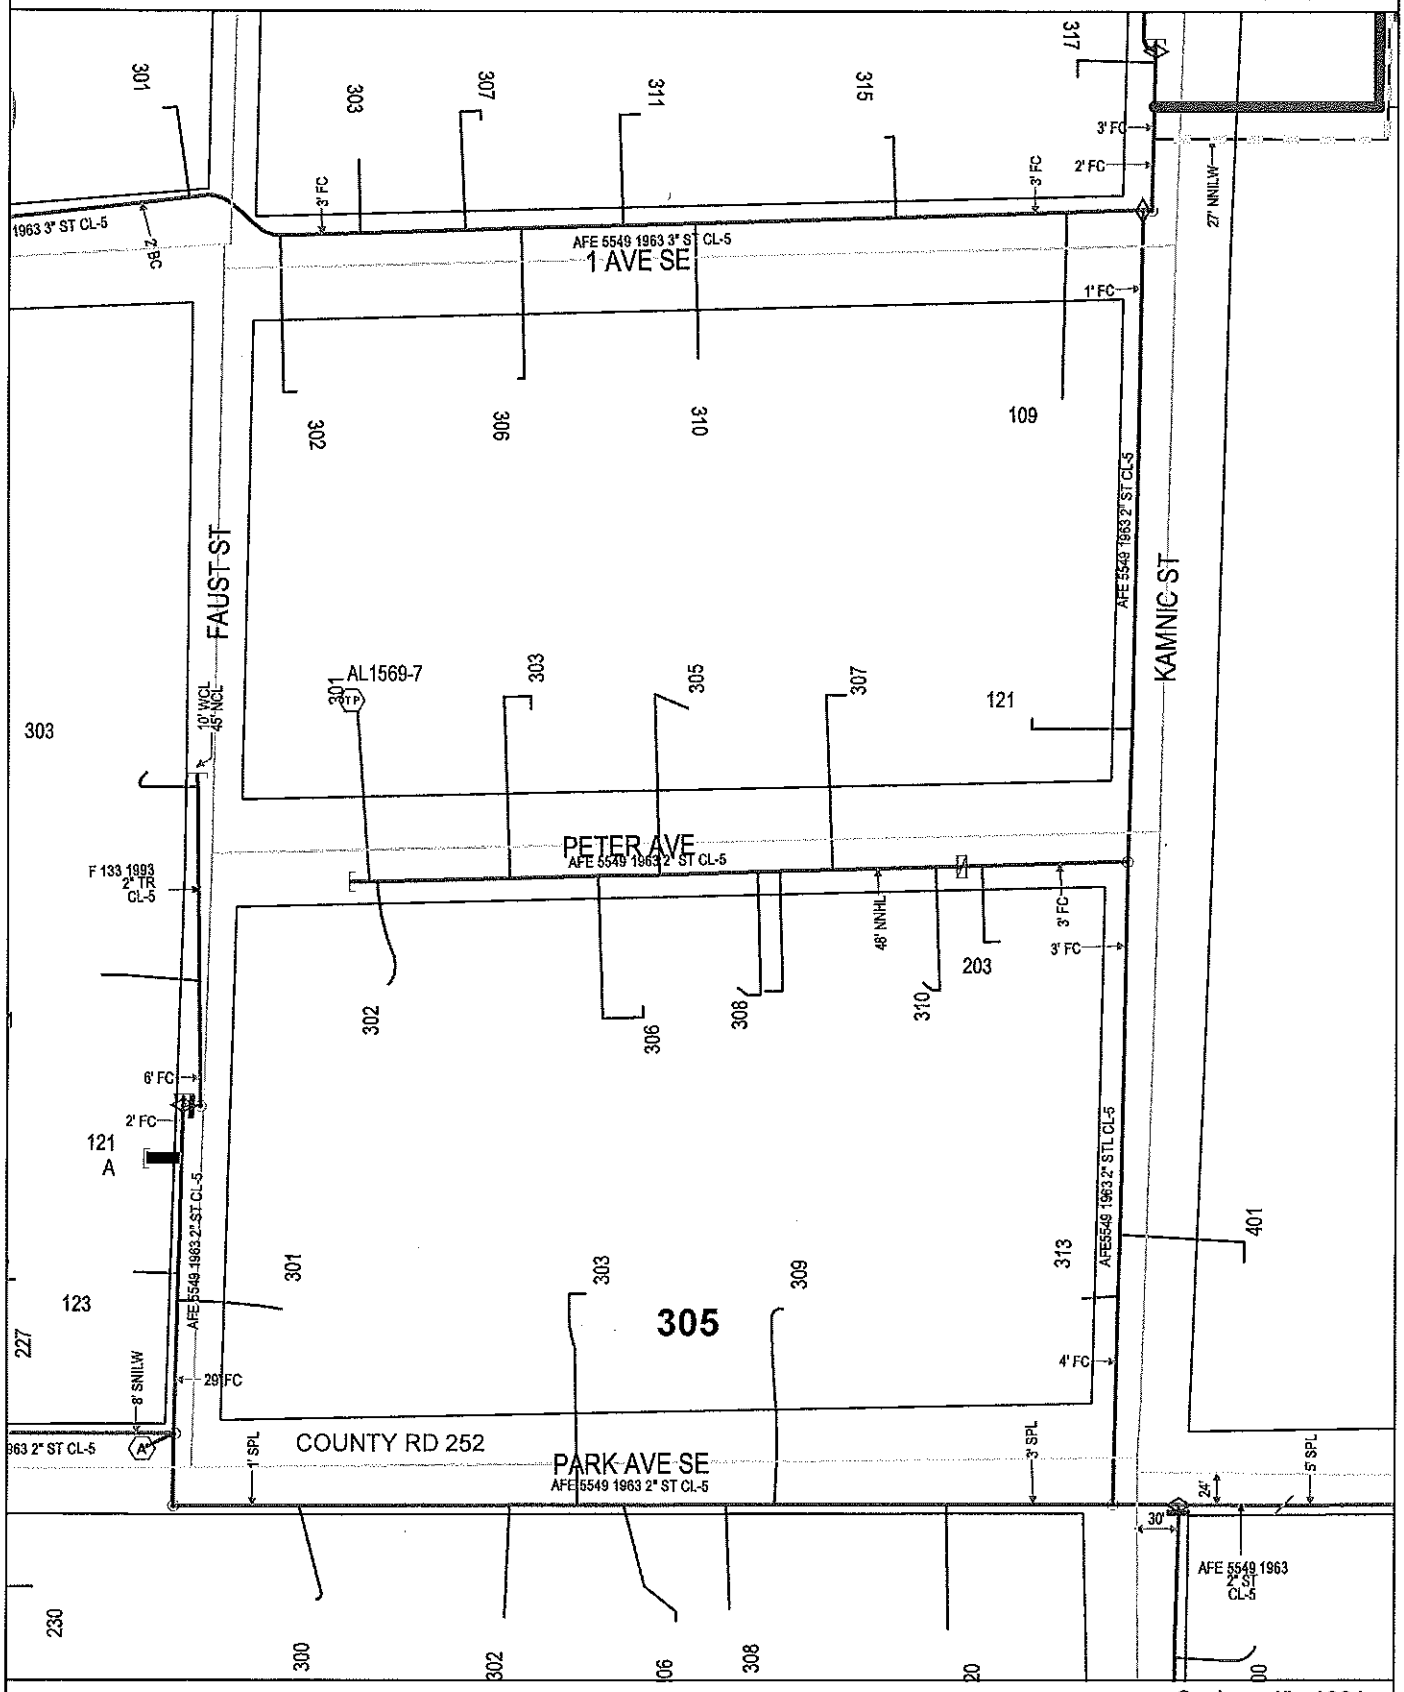

Plotted by: i222382

Plot Date: 10/2/2015

305 PARK AVE SE

PIERZ, MN 56364 MORRISON COUNTY

Scale: 1" : 100 '

CenterPoint Energy

North