


PLAN VIEW: 1"=200'

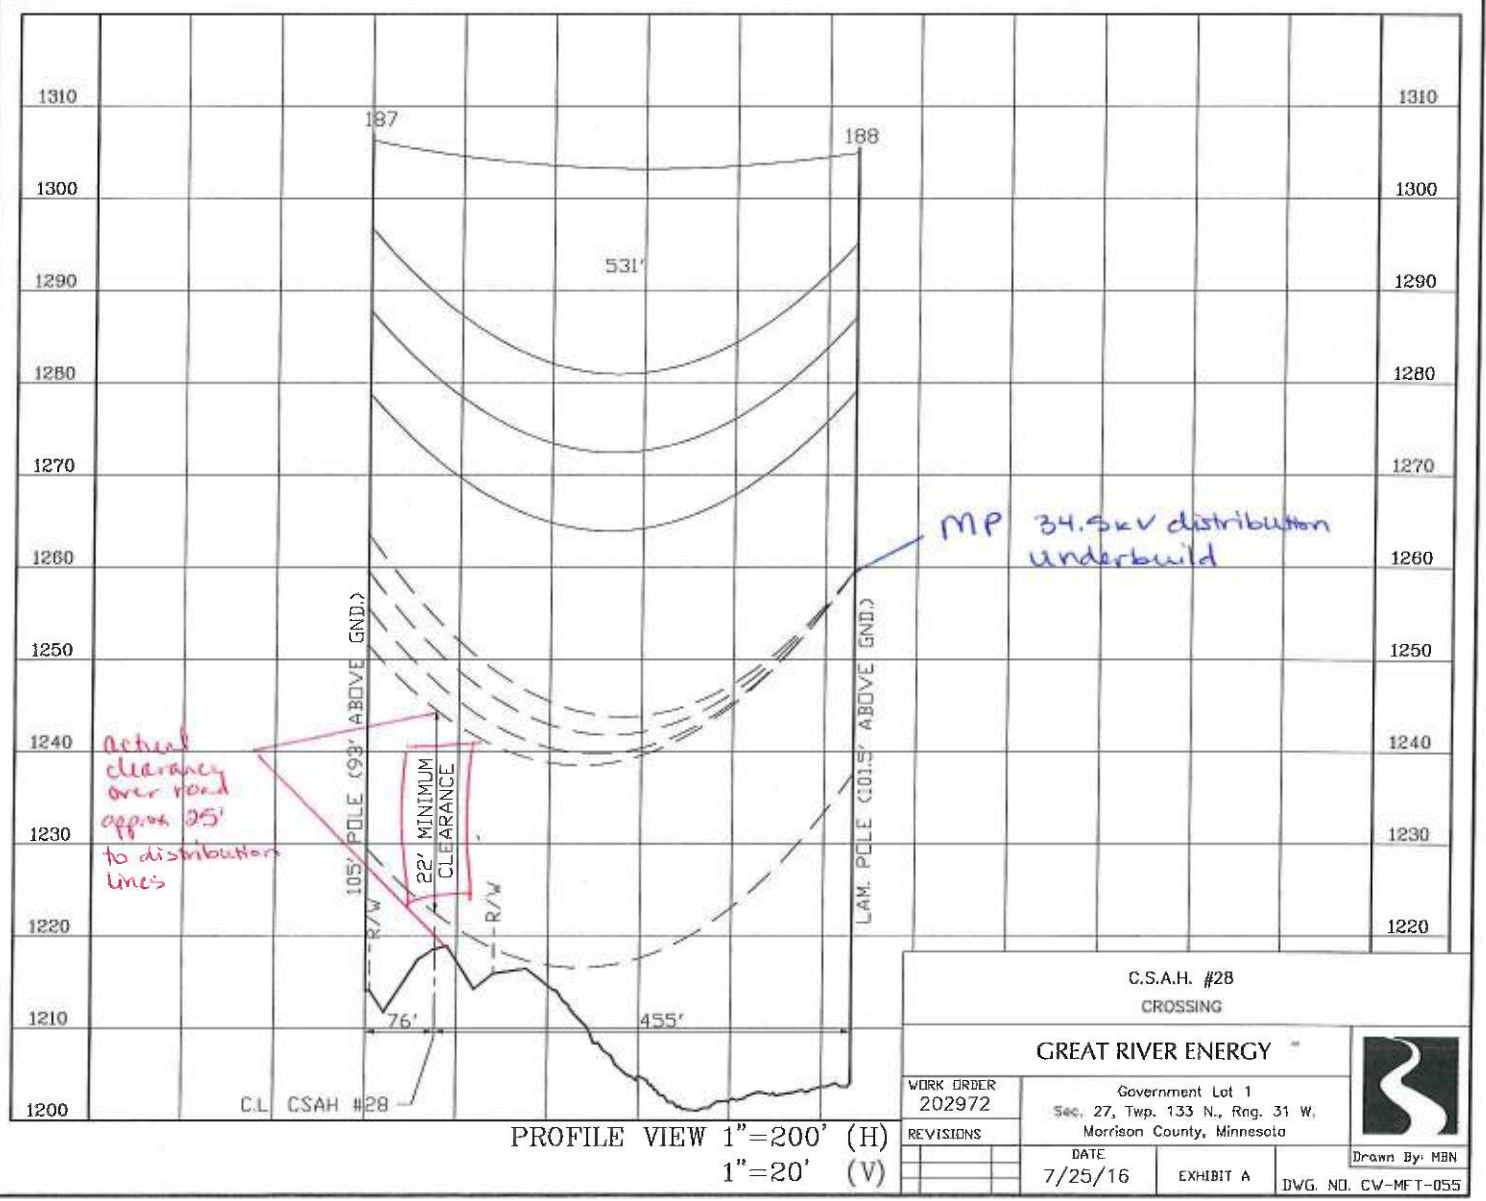

PROFILE VIEW 1"=200' (H)
1"=20' (V)