


Replace bad pole in same location. Approx. 750' west of 22nd ave & 47' north of CI on CR 12. Minimum clearance running along road is 21'

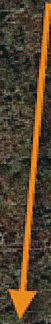

12