


Replace pole in same location as existing (approx 32' east of CL)

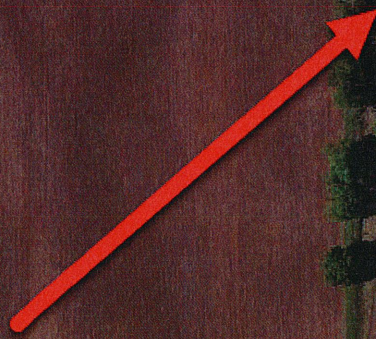

Address 6242 Great River Rd



Great River Rd

© 2018 Google

1991

224

Imag