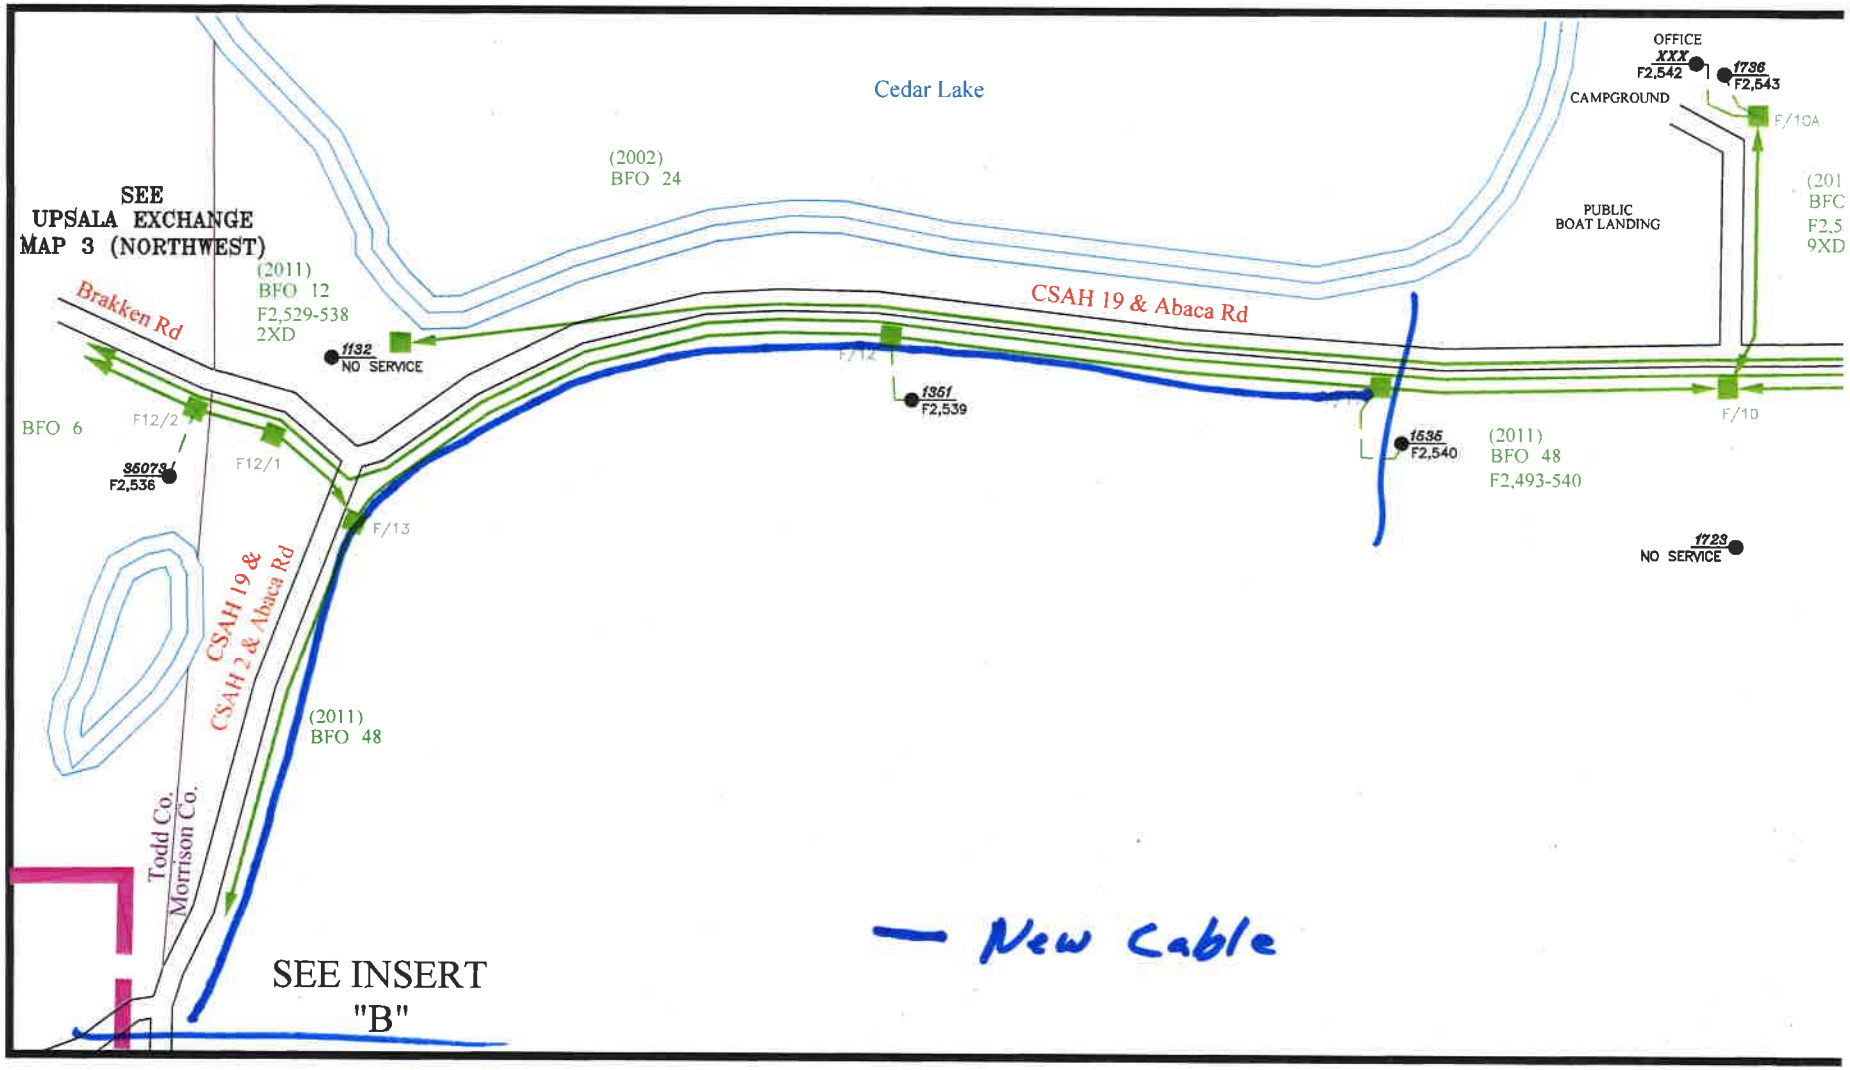
Cedar Lake
OFFICE
XXX
F2,542
1736
F2,543
CAMPGROUND
F/10A
(2002)
BFO 24
SEE
UPSALA EXCHANGE
MAP 3 (NORTHWEST)
PUBLIC
BOAT LANDING
(201
BFC
F2,5
9XD
(2011)
BFO 12
F2,529-538
2XD
Brakken Rd
CSAH 19 & Abaca Rd
1132
NO SERVICE
F/12
1951
F2,539
F/10
BFO 6
F12/2
F12/1
35073
F2,536
1535
F2,540
(2011)
BFO 48
F2,493-540
F/13
1729
NO SERVICE
CSAH 19 &
CSAH 2 & Abaca Rd
(2011)
BFO 48
Todd Co.
Morrison Co.
New Cable
SEE INSERT
"B"

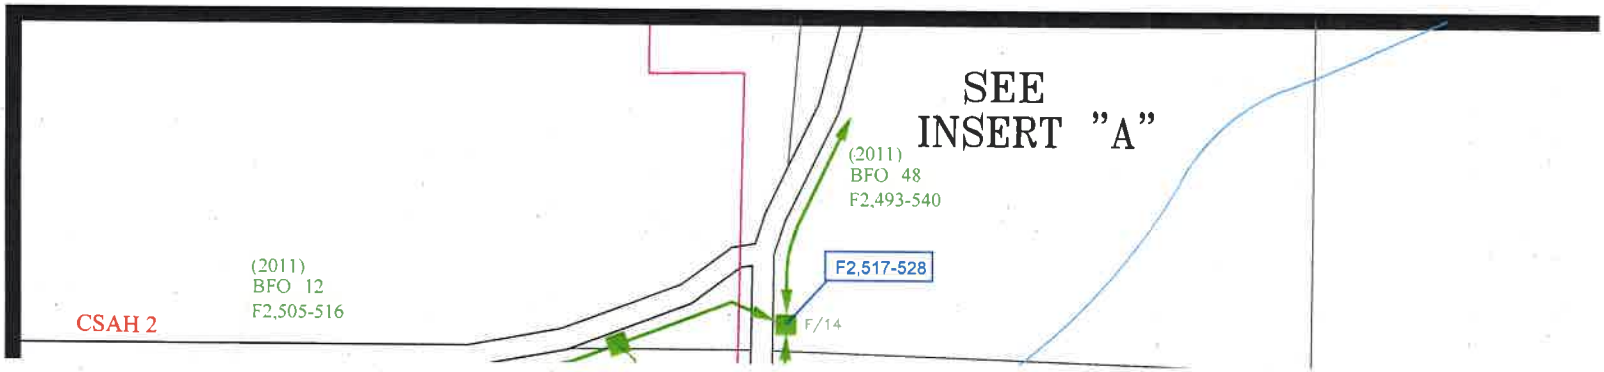
SEE
INSERT "A"
(2011)
BFO 48
F2,493-540
F2,517-528
(2011)
BFO 12
F2,505-516
CSAH 2
F/14