


GENERAL LOCATION ONLY. DO NOT USE TO LOCATE FOR EXCAVATION. CALL 1-800-252-1166 FOR ONSITE LOCATIONS AND STAKING.

# LONG TAP:400' ECL CREAMERY DR

## 27150, 27152

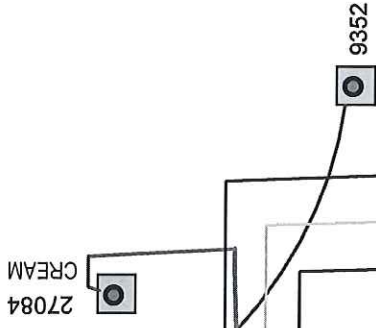

CREAMERY DR

27274

27142

93 ST  
F 300 1994 2" TR CL-6

29

06230

27217

27231

27247

27252

(COUNTY RD 34)

297

Plotted by: i213215

Plot Date: 9/21/2017

27150 & 27152 93RD ST (CO RD 34)

MORRISON

Scale: 1" = 100'

