



# ArcGIS Web Map

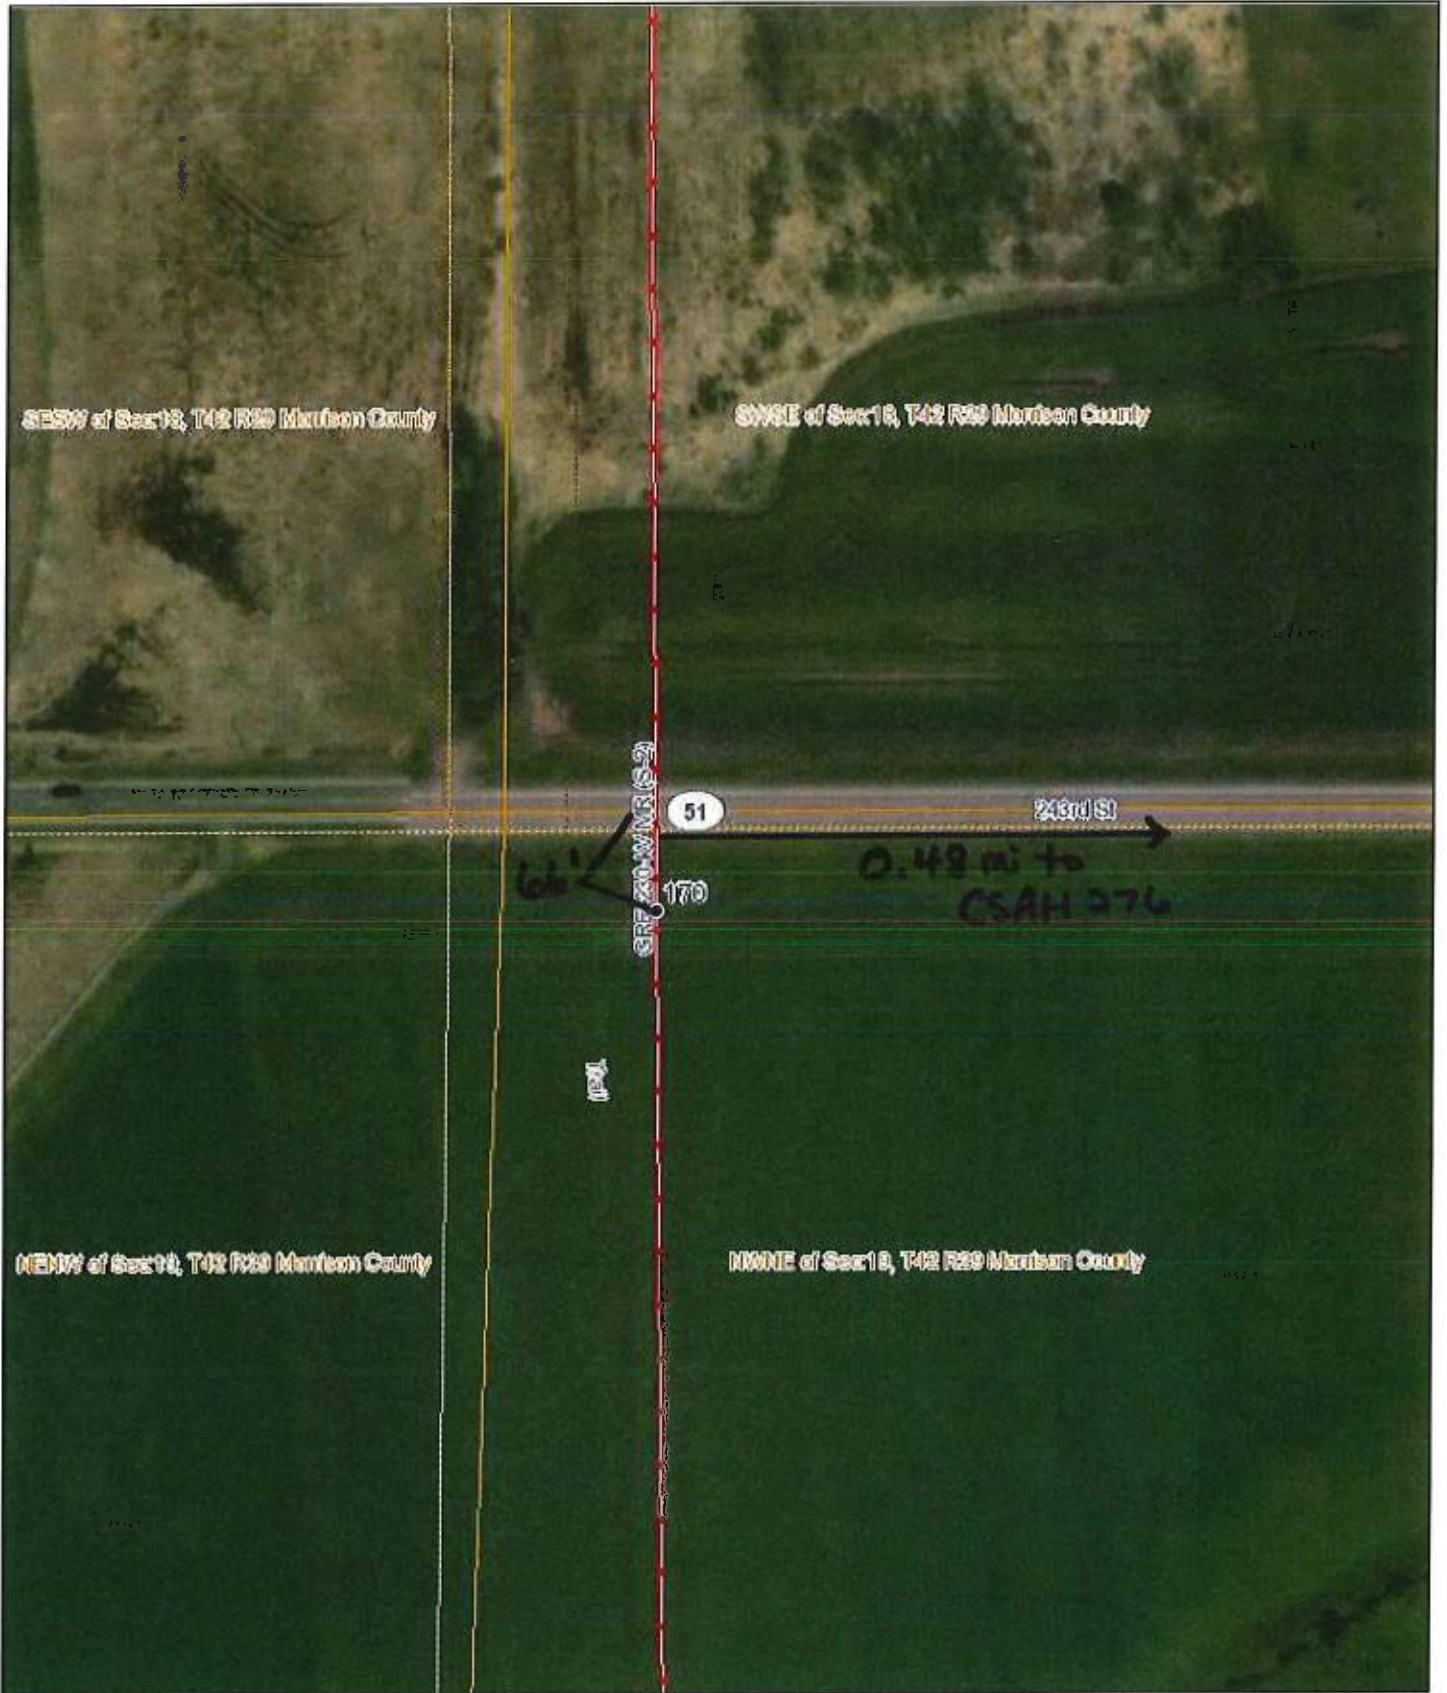

2/22/2018, 12:25:01 PM

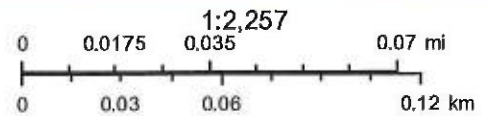

- GRE Breaker
- GRE Substation Switch
- GRE Capacitor
- GRE Reactor